


PENNSYLVANIA COAL CO.

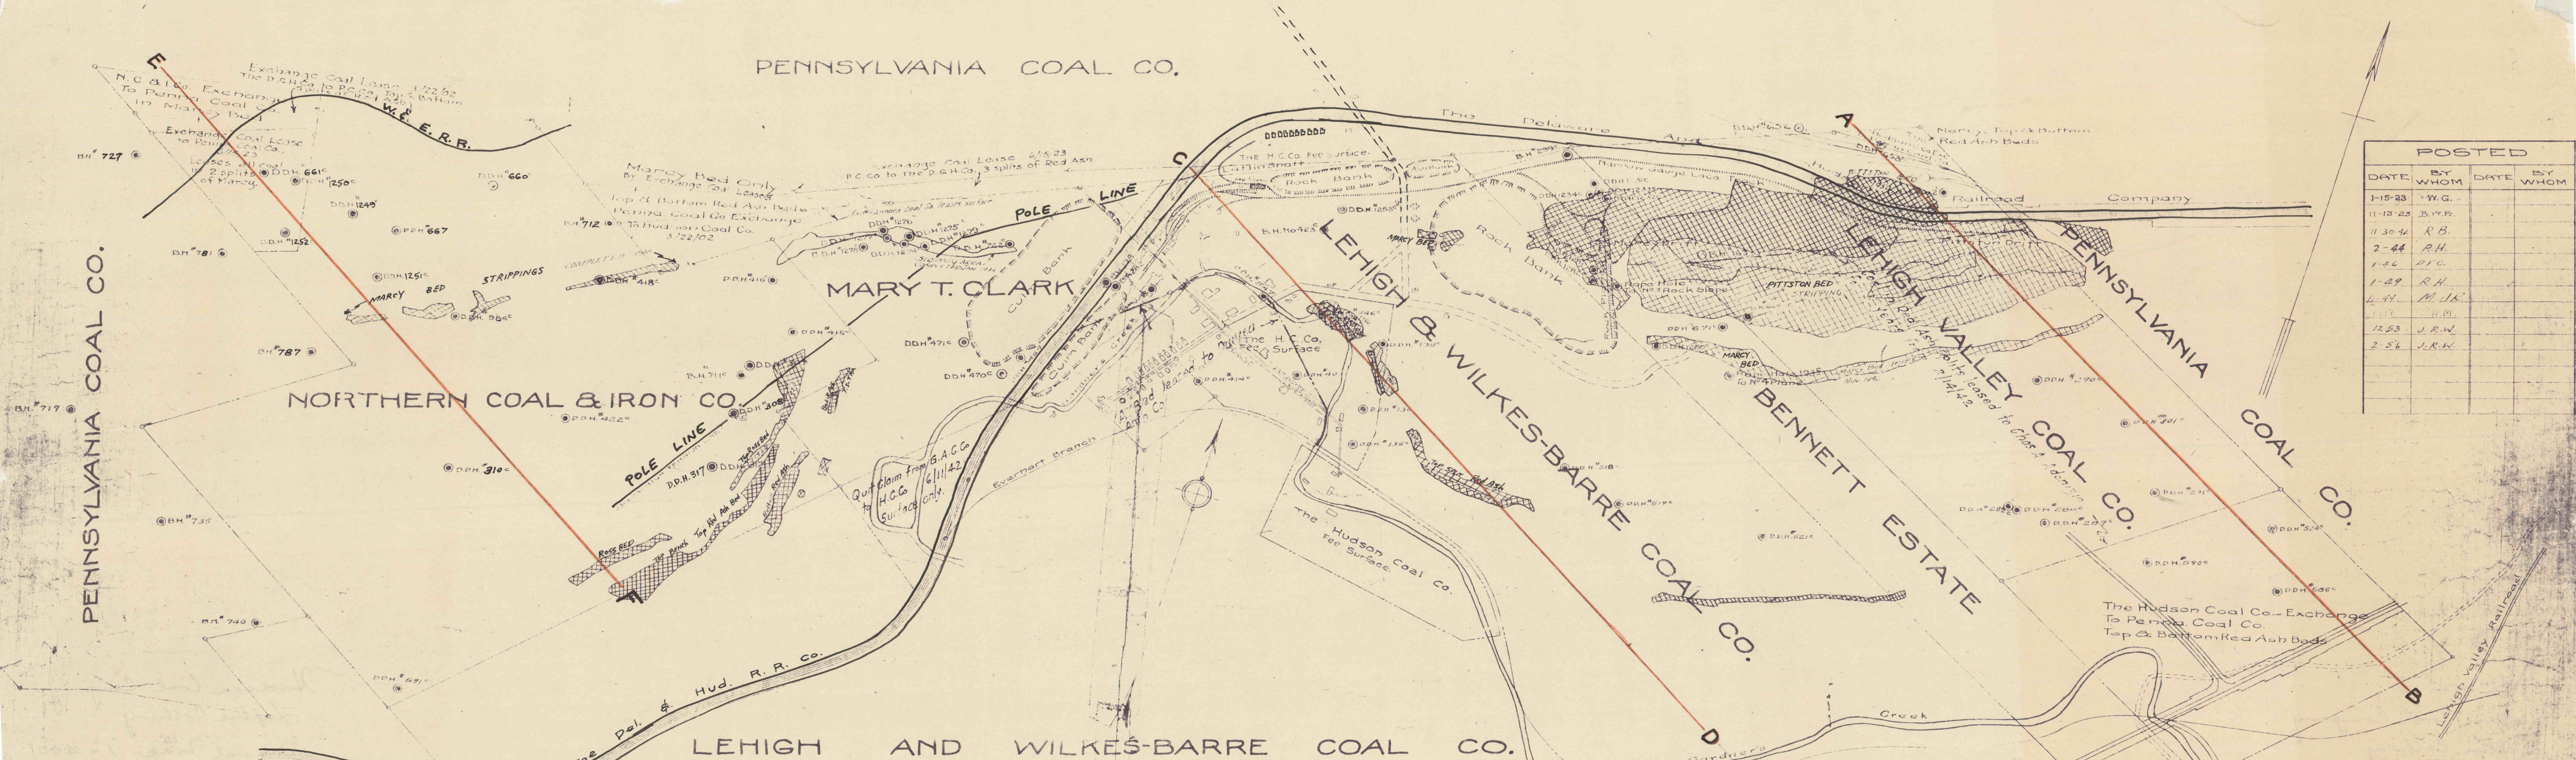

POSTED			
DATE	BY WHOM	DATE	BY WHOM
1-15-23	W.G.		
11-13-23	B.Y.F.		
11-30-24	R.B.		
2-44	R.H.		
1-46	P.F.C.		
1-49	R.H.		
4-44	M. J.K.		
1-51	H.M.		
12-53	J.R.W.		
2-56	J.R.W.		

THE HUDSON COAL CO
WILKESBARRE DIVISION
LAFLIN COLLIERY
And Adjoining Workings
GENERAL MAP

Scale; 1"=400'.

Office of
Forecast Dept,
Scranton, Pa.

Jan. 1 1921