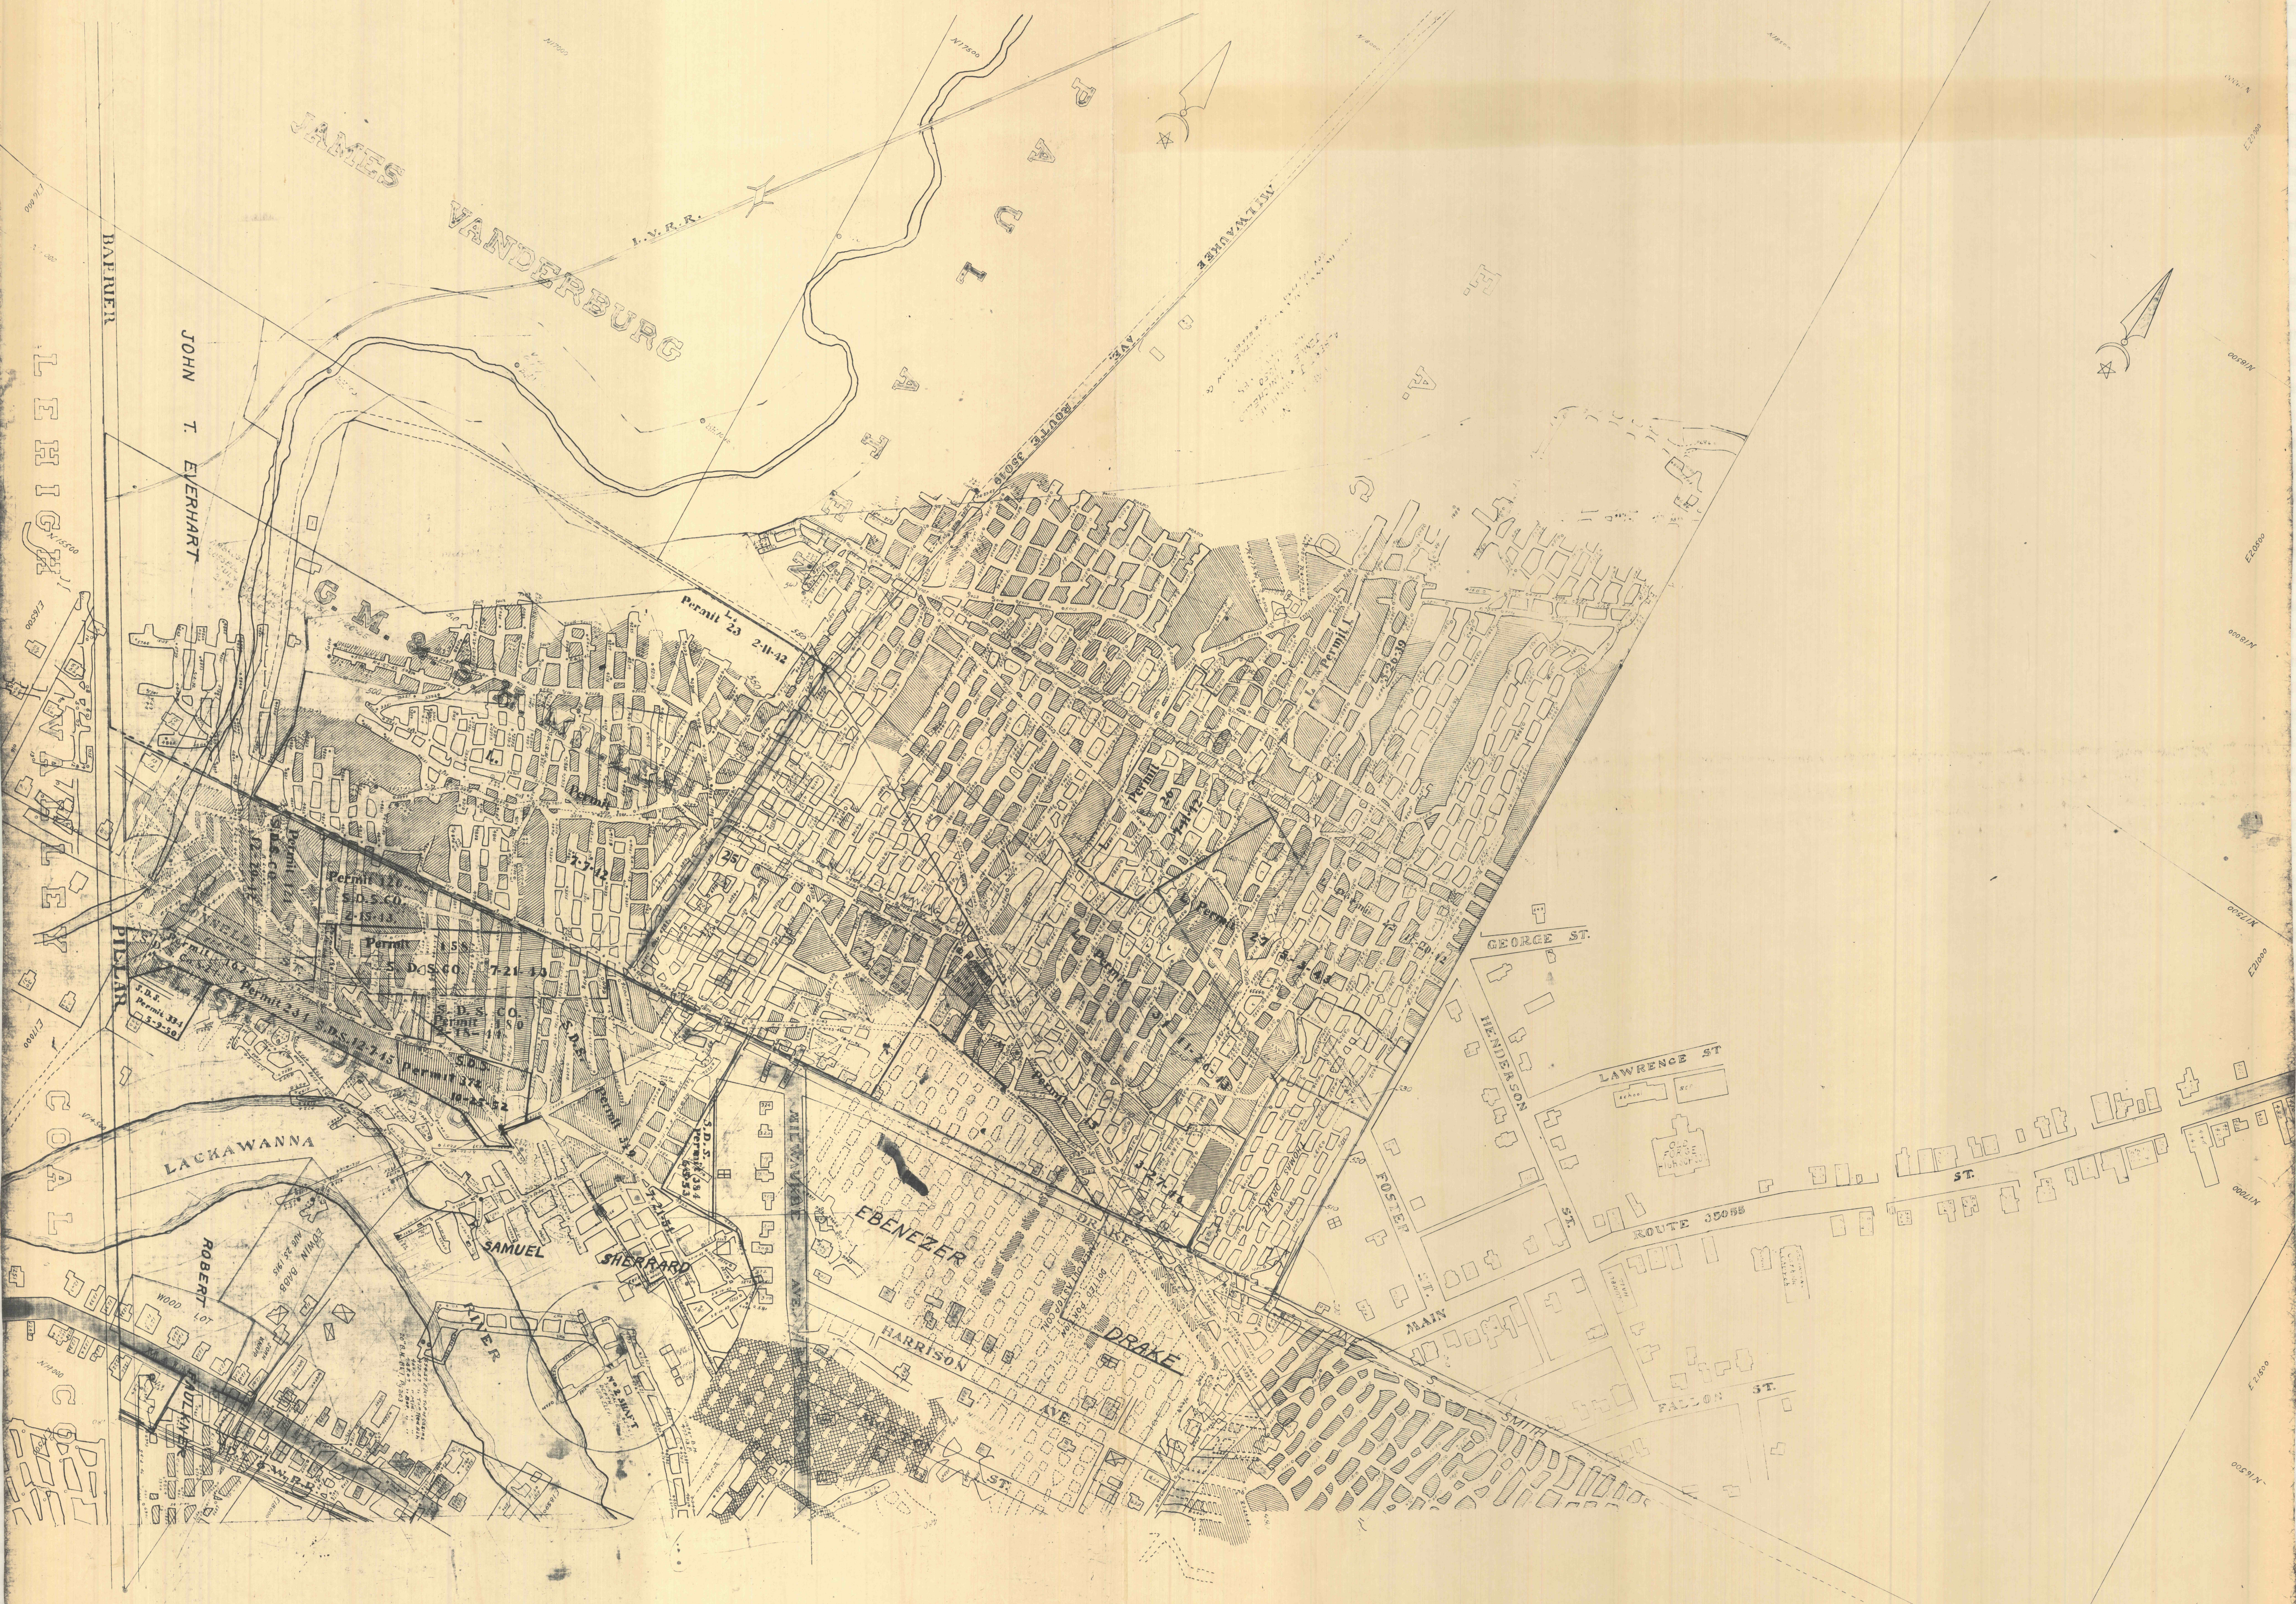
JAMES VANDERBURG
L.V.R.R.
PAUL A. TEDE
ROUTE 35010
MILWAUKEE AVE.
BARRIER
JOHN T. EVERHART
LEHIGH VALLEY COAL CO.
PILLAR
G. M. & S. HALLSTEAD
Permit 23 2-11-42
Permit 7-7-42
Permit 171 S.D.S.CO. 12-26-45
Permit 127 S.D.S.CO. 2-15-43
Permit 158 S.D.S.CO. 7-21-43
S.D.S.CO. Permit 180 2-15-44
Permit 162
Permit 231 S.D.S. 12-7-45
S.D.S. Permit 334 5-9-50
S.D.S. Permit 372 10-25-52
S.D.S. Permit 384 6-5-53
Permit 349
7-21-51
Permit 26 7-1-47
Permit 27 3-4-43
Permit 12-20-42
Permit 11-2-43
Permit 5-20-39
3-27-46
25
LACKAWANNA RIVER
ROBERT WOOD LOT
EDWIN BABB AUG 25 1915
JOHN KNAPP
FAULKNER
SAMUEL SHERRARD
EBENEZER DRAKE
THOMAS DRAKE
No 2 SHAFT
HARRISON AVE.
MAIN ST.
ROUTE 35055
GEORGE ST.
LAWRENCE ST
HENDERSON ST.
FOSTER ST.
FALLON ST.
SMITH
OLD FORGE High School
school
D.L.&W.R.R.
DOTTED PORTION AS TOP COAL
N17000
N17500
N18000
N18500
N18000
N17500
N17000
N16500
N15500
N14500
N14000
E16000
E16500
E17000
E18000
E18500
E20000
E20500
E21000
E21500