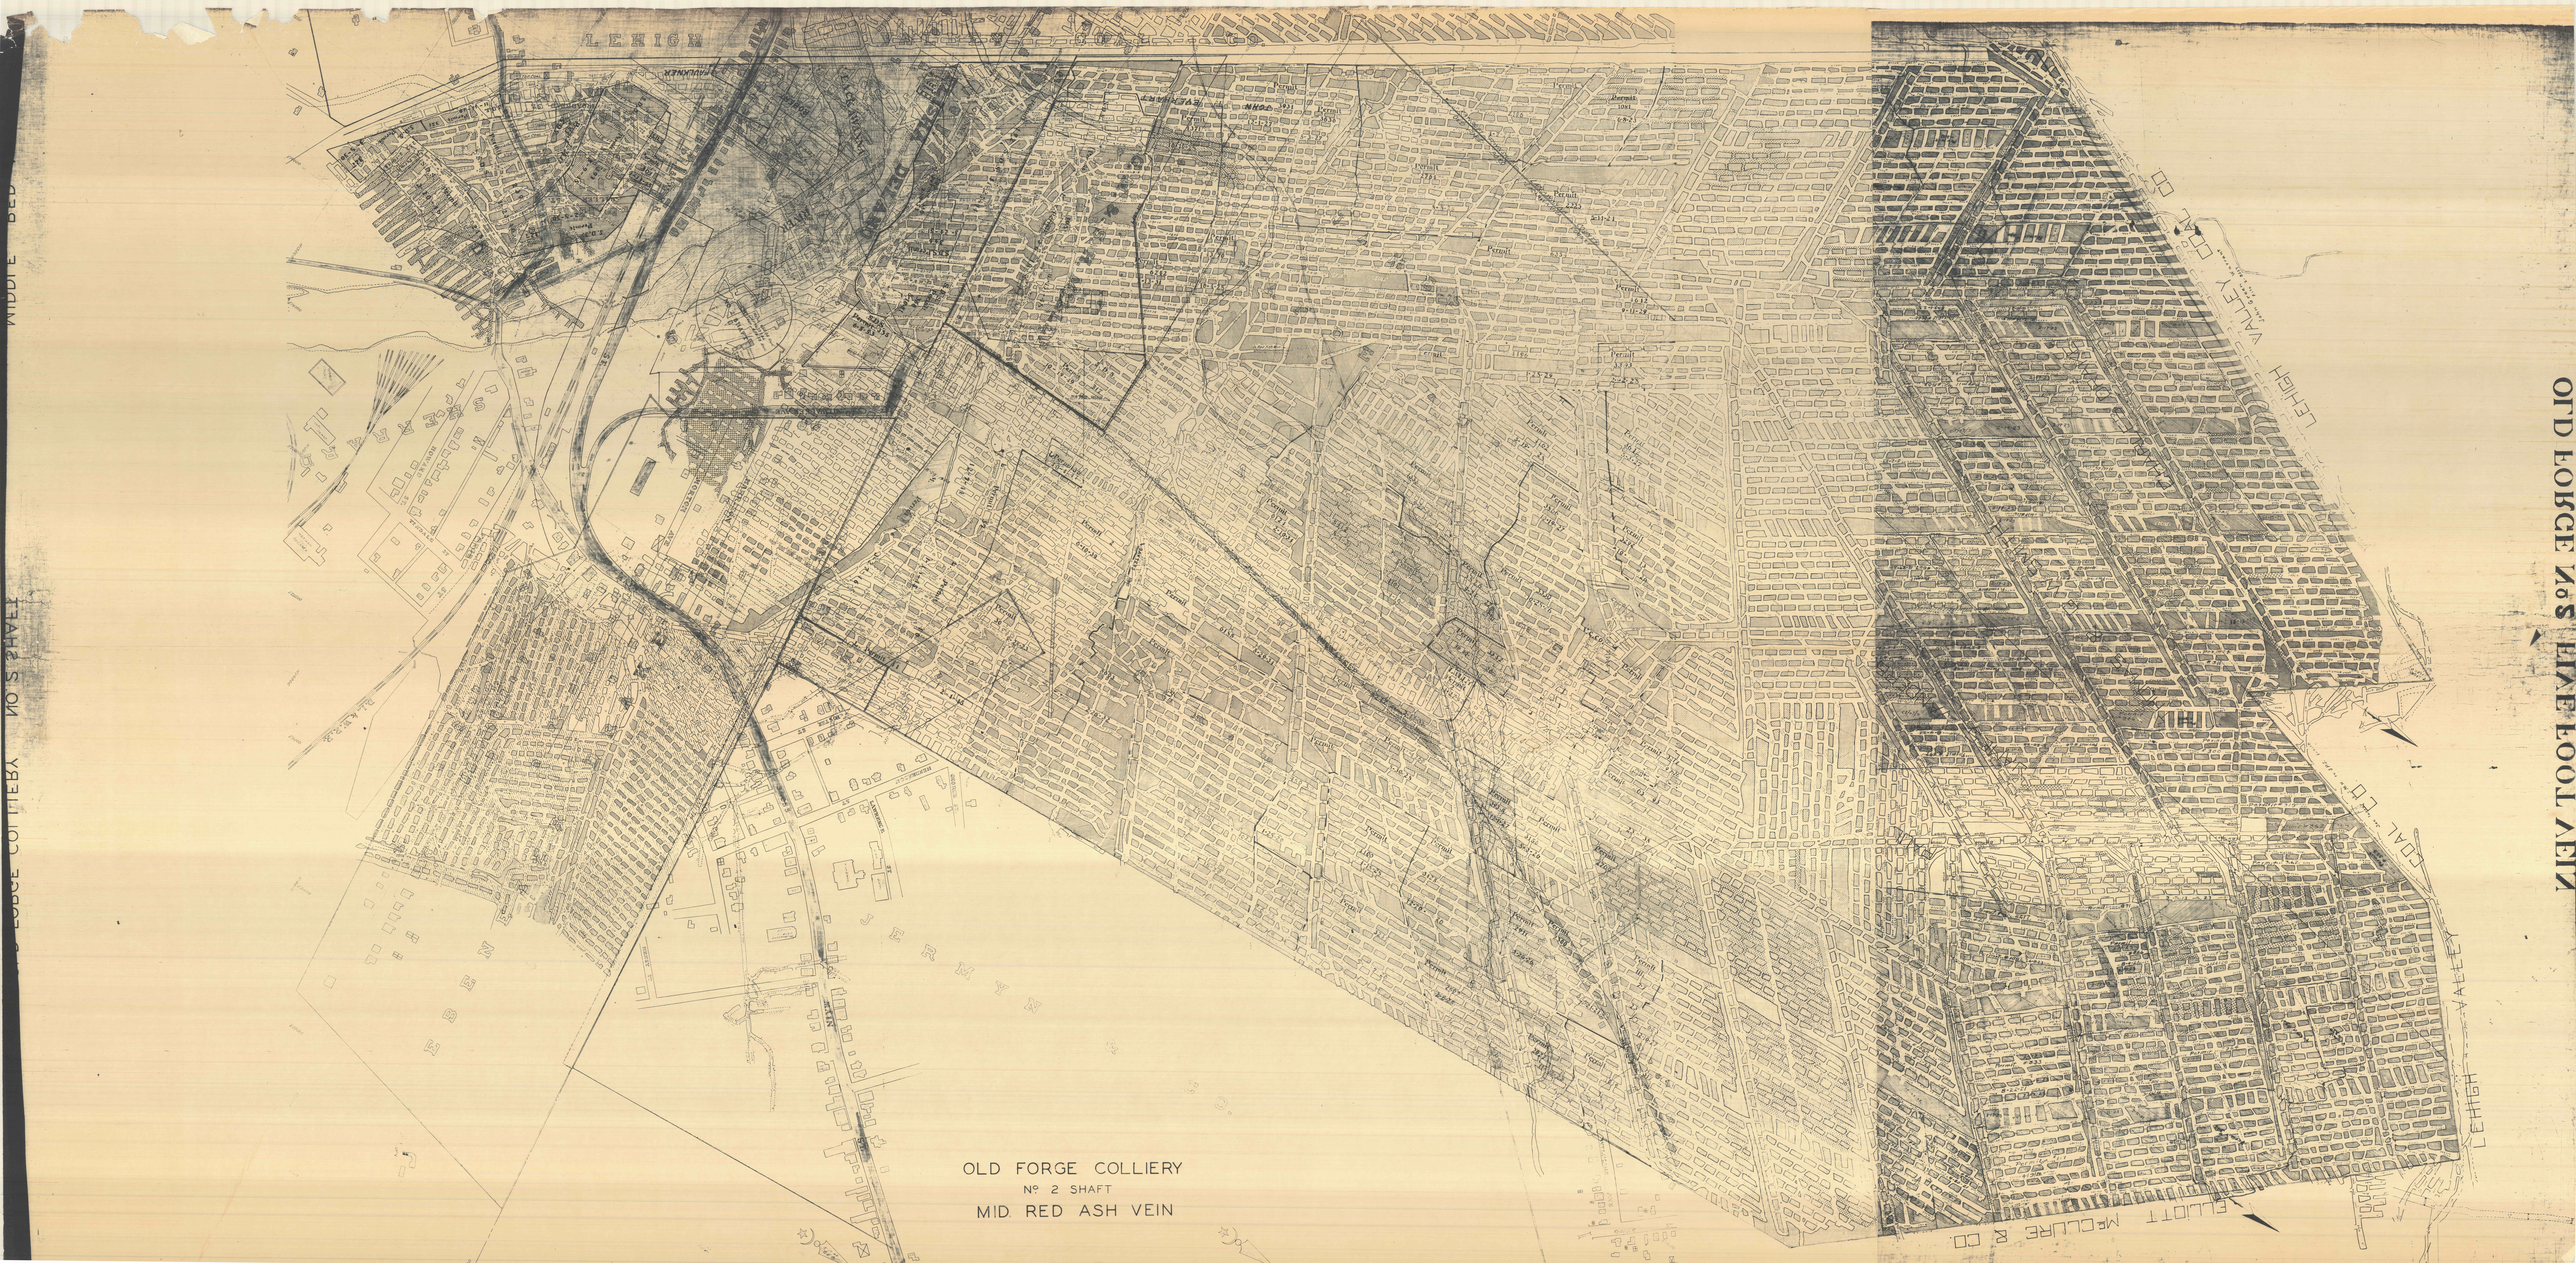

LEHIGH
OLD FORGE COLLIERY
Nº 2 SHAFT
MID. RED ASH VEIN
OLD FORGE Nº 2 SHAFT
MID. RED ASH VEIN
LEHIGH VALLEY COAL CO.
ELLIOTT McCLURE R. CO.
LEHIGH VALLEY