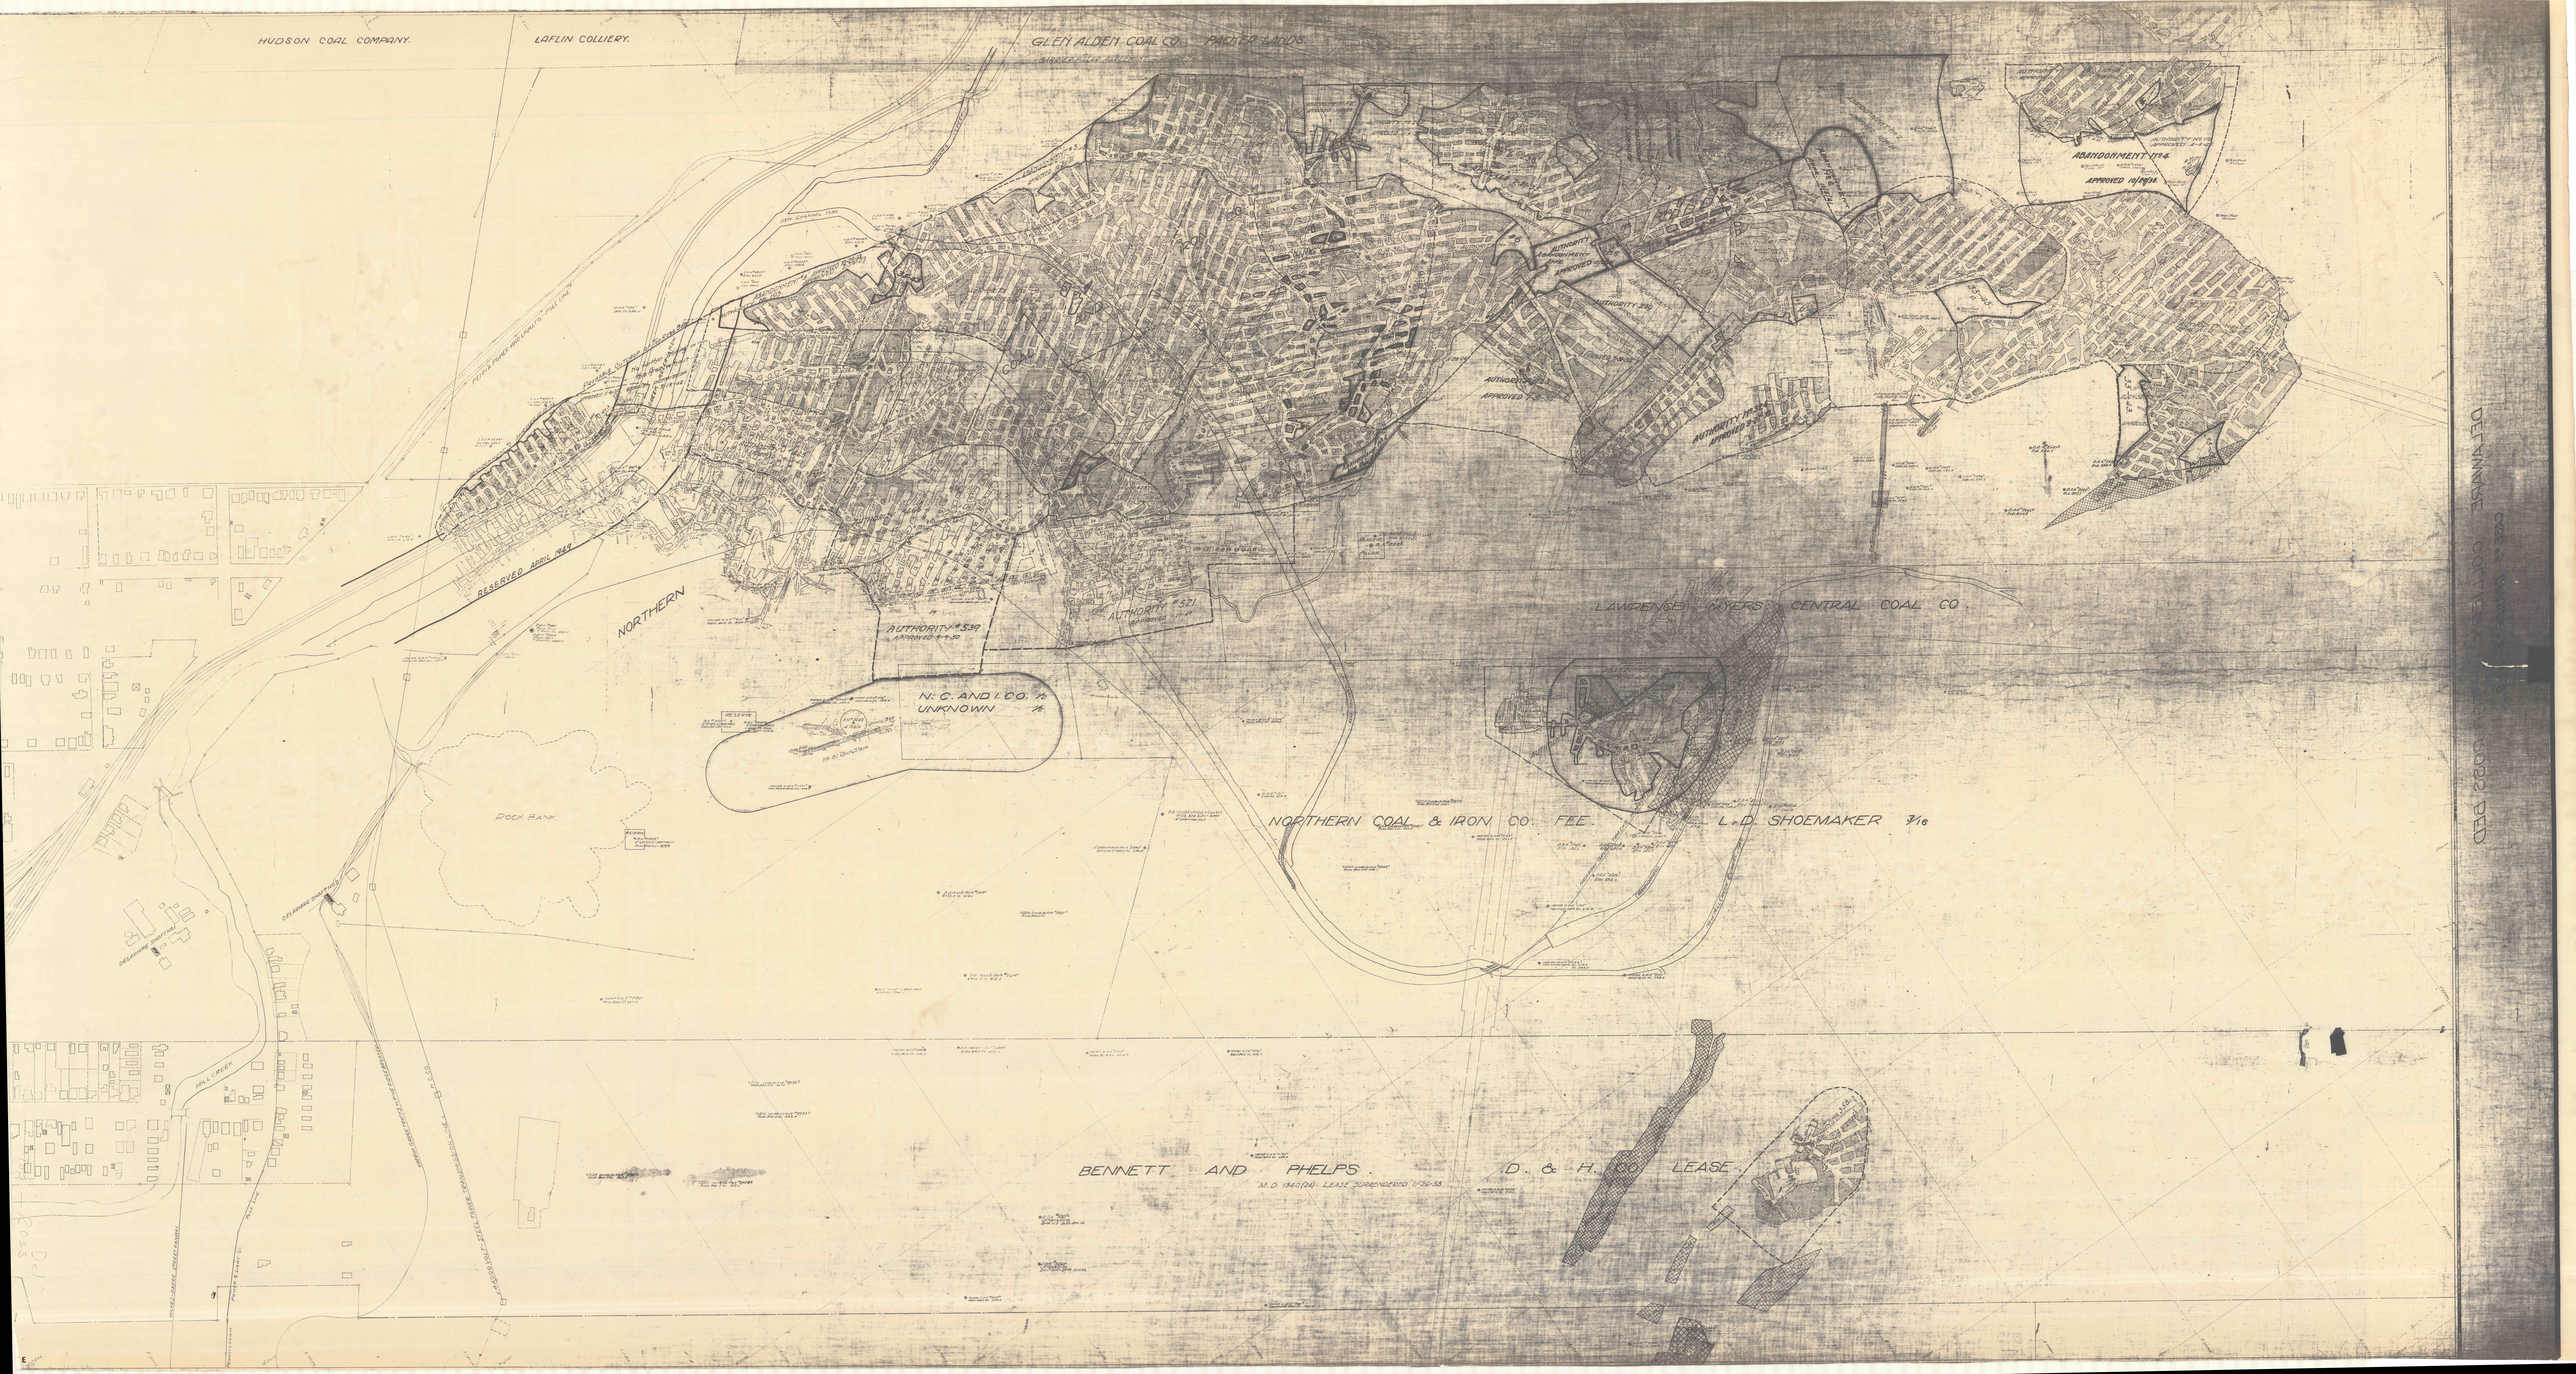
HUDSON COAL COMPANY.
LAFLIN COLLIERY.
GLEN ALDEN COAL CO. PACIFIC LANDS
RESERVED APRIL 1942
NORTHERN
AUTHORITY #539
APPROVED 8-7-58
AUTHORITY #521
APPROVED 1-17-58
N. C. AND I. CO. ½
UNKNOWN ½
ROCK BANK
DELAWARE SUBSTATION
MILL CREEK
ABANDONMENT 1926
APPROVED 1929
AUTHORITY #536
APPROVED 5-5-58
AUTHORITY #535
APPROVED 5-5-58
AUTHORITY #534
APPROVED 5-5-58
LAWRENCE MYERS CENTRAL COAL CO.
NORTHERN COAL & IRON CO. FEE
L.D. SHOEMAKER 3/8
BENNETT AND PHELPS
M.D. 1940(Q8). LEASE SURRENDERED 11-26-58
D. & H. CO. LEASE
DELAWARE CANAL
DELAWARE & HUDSON CANAL CO. TOWPATH