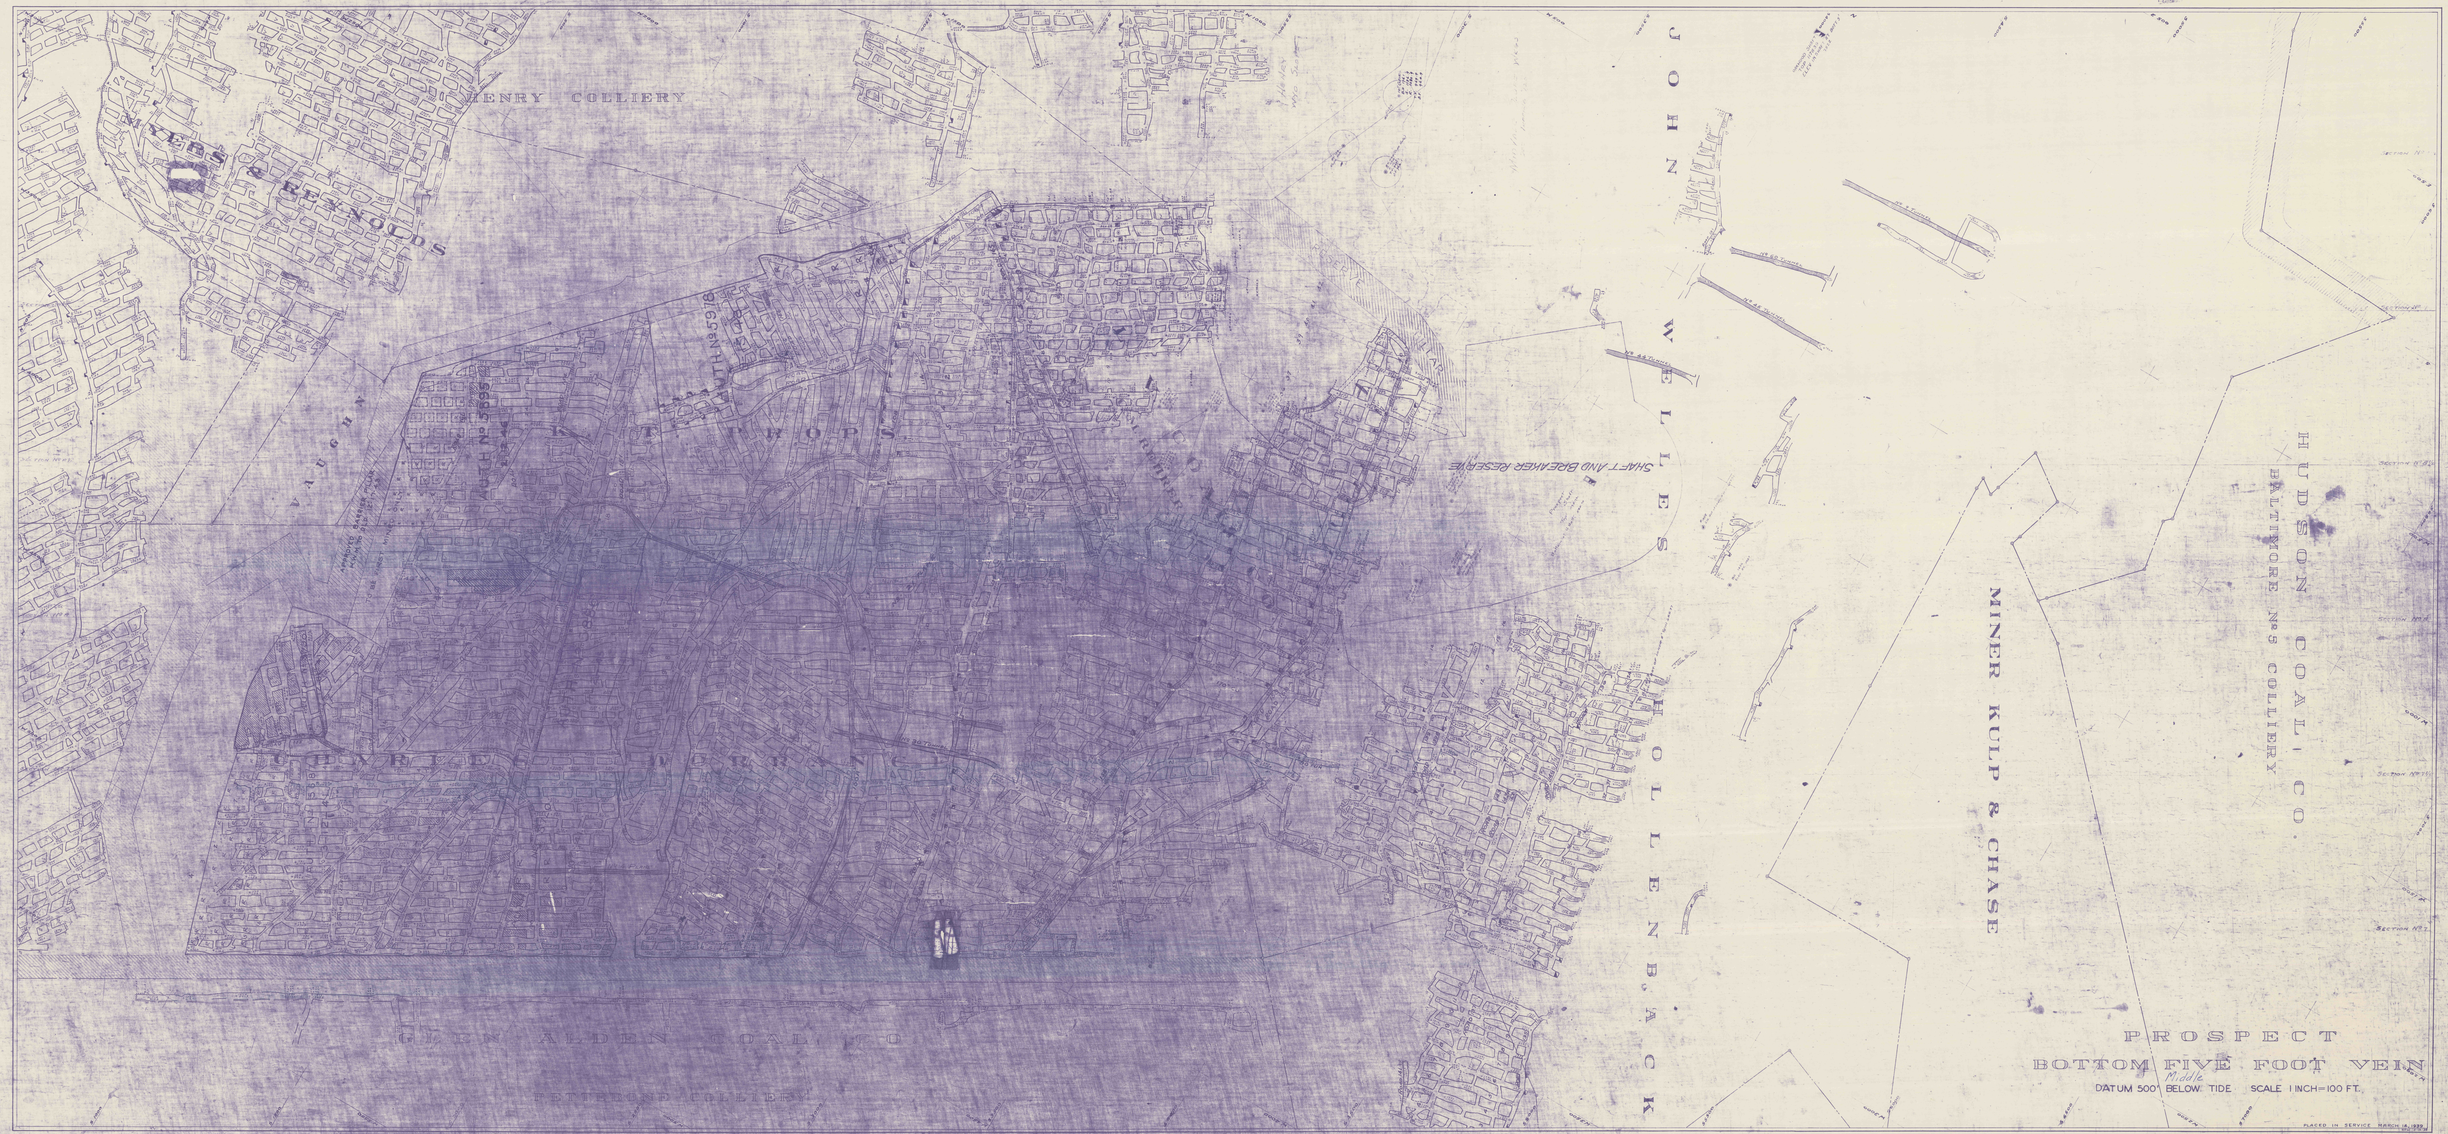

HENRY COLLIERY
MYERS & REYNOLDS
VAUGHN
AUTH No 5695
AUTH No 5918
T PROPS
BARRIER PILLAR
CHARLES DORRANCE
No 30 TUNNEL
SHAFT AND BREAKER RESERVE
PILLAR
JOHN WELLES HOLLENBACK
MINER KULP & CHASE
HUDSON COAL CO.
BALTIMORE No 5 COLLIERY
GLEN ALDEN COAL CO.
PETTEBONE COLLIERY
S 1500
W 5500
S 2000
S 2500
W 5000
S 3000
W 3500
S 5500
W 3000
S 6000
S 6500
W 2500
S 7000
W 2000

PROSPECT

BOTTOM ~~FIVE~~ FOOT VEIN

Middle

DATUM 500' BELOW TIDE SCALE 1 INCH=100 FT.

PLACED IN SERVICE MARCH 14, 1939

REW. 3-14-39