


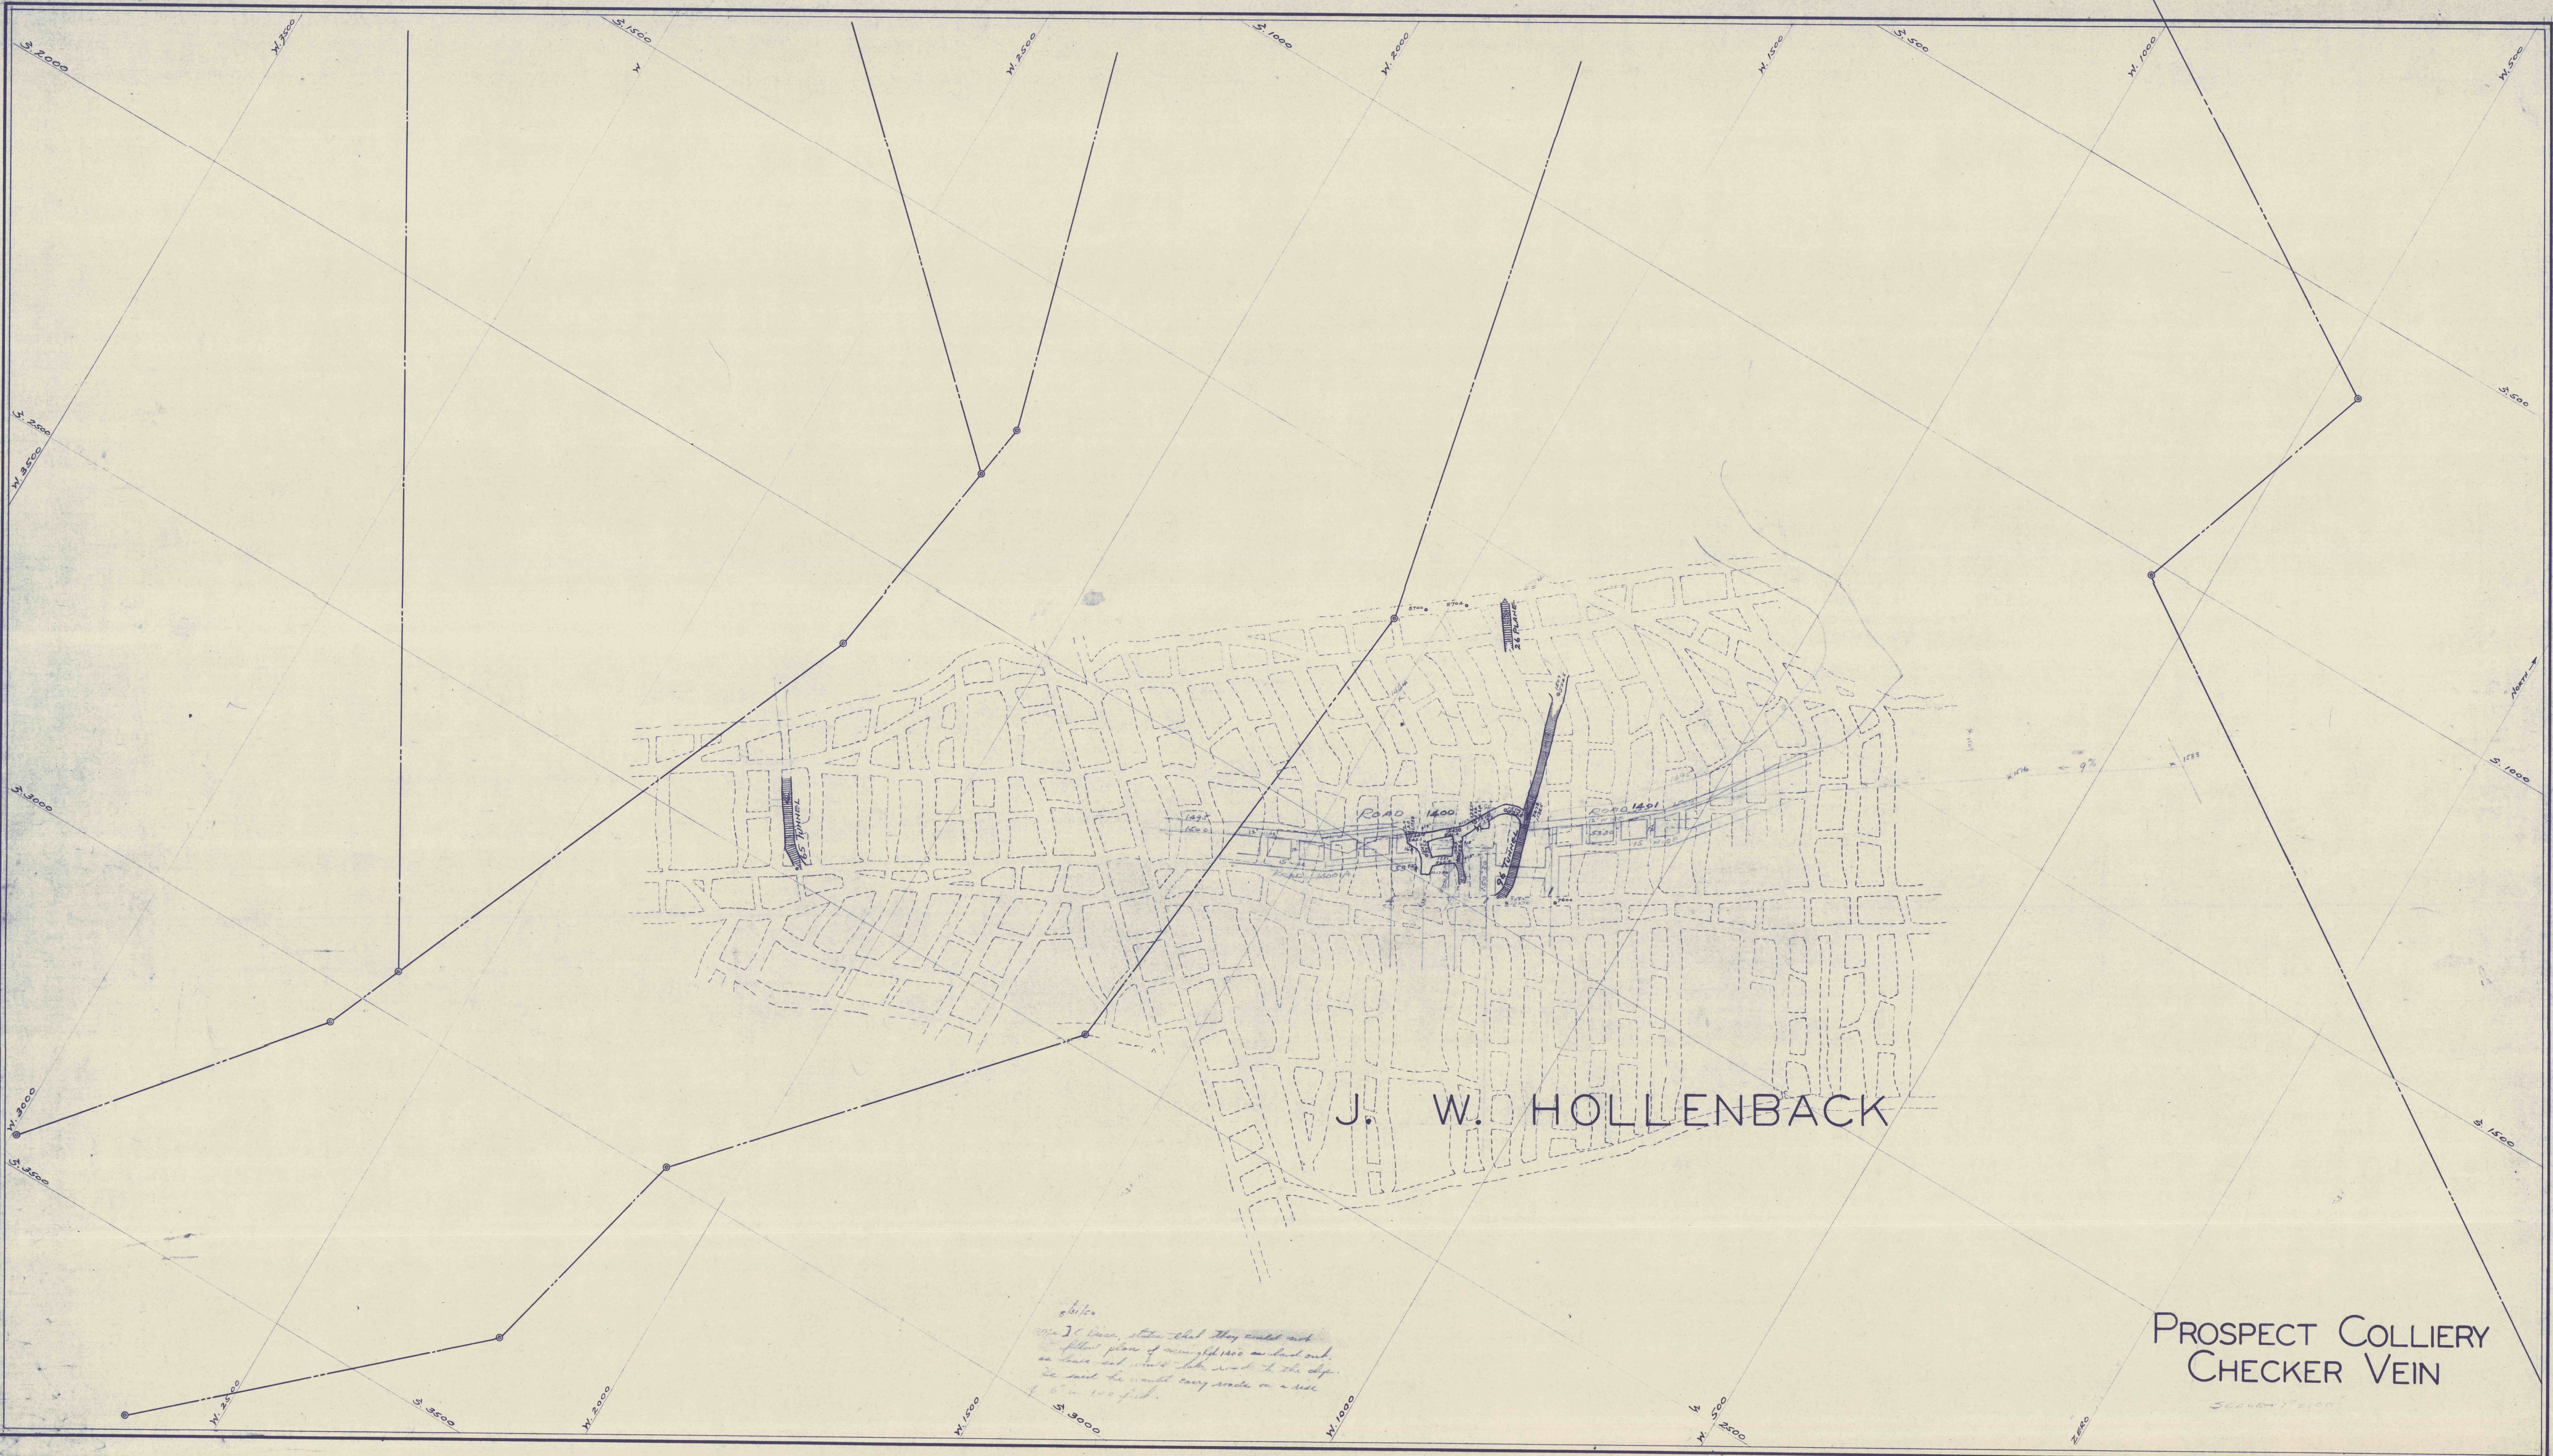

J. W. HOLLENBACK

PROSPECT COLLIERY
CHECKER VEIN

6/1/10
Mr. J. C. Voss, states that they could not
fill plan of vein, 1400's and 1500's
as they are not in the dip.
He said he would carry roads on a rise
of 6" to 100 feet.