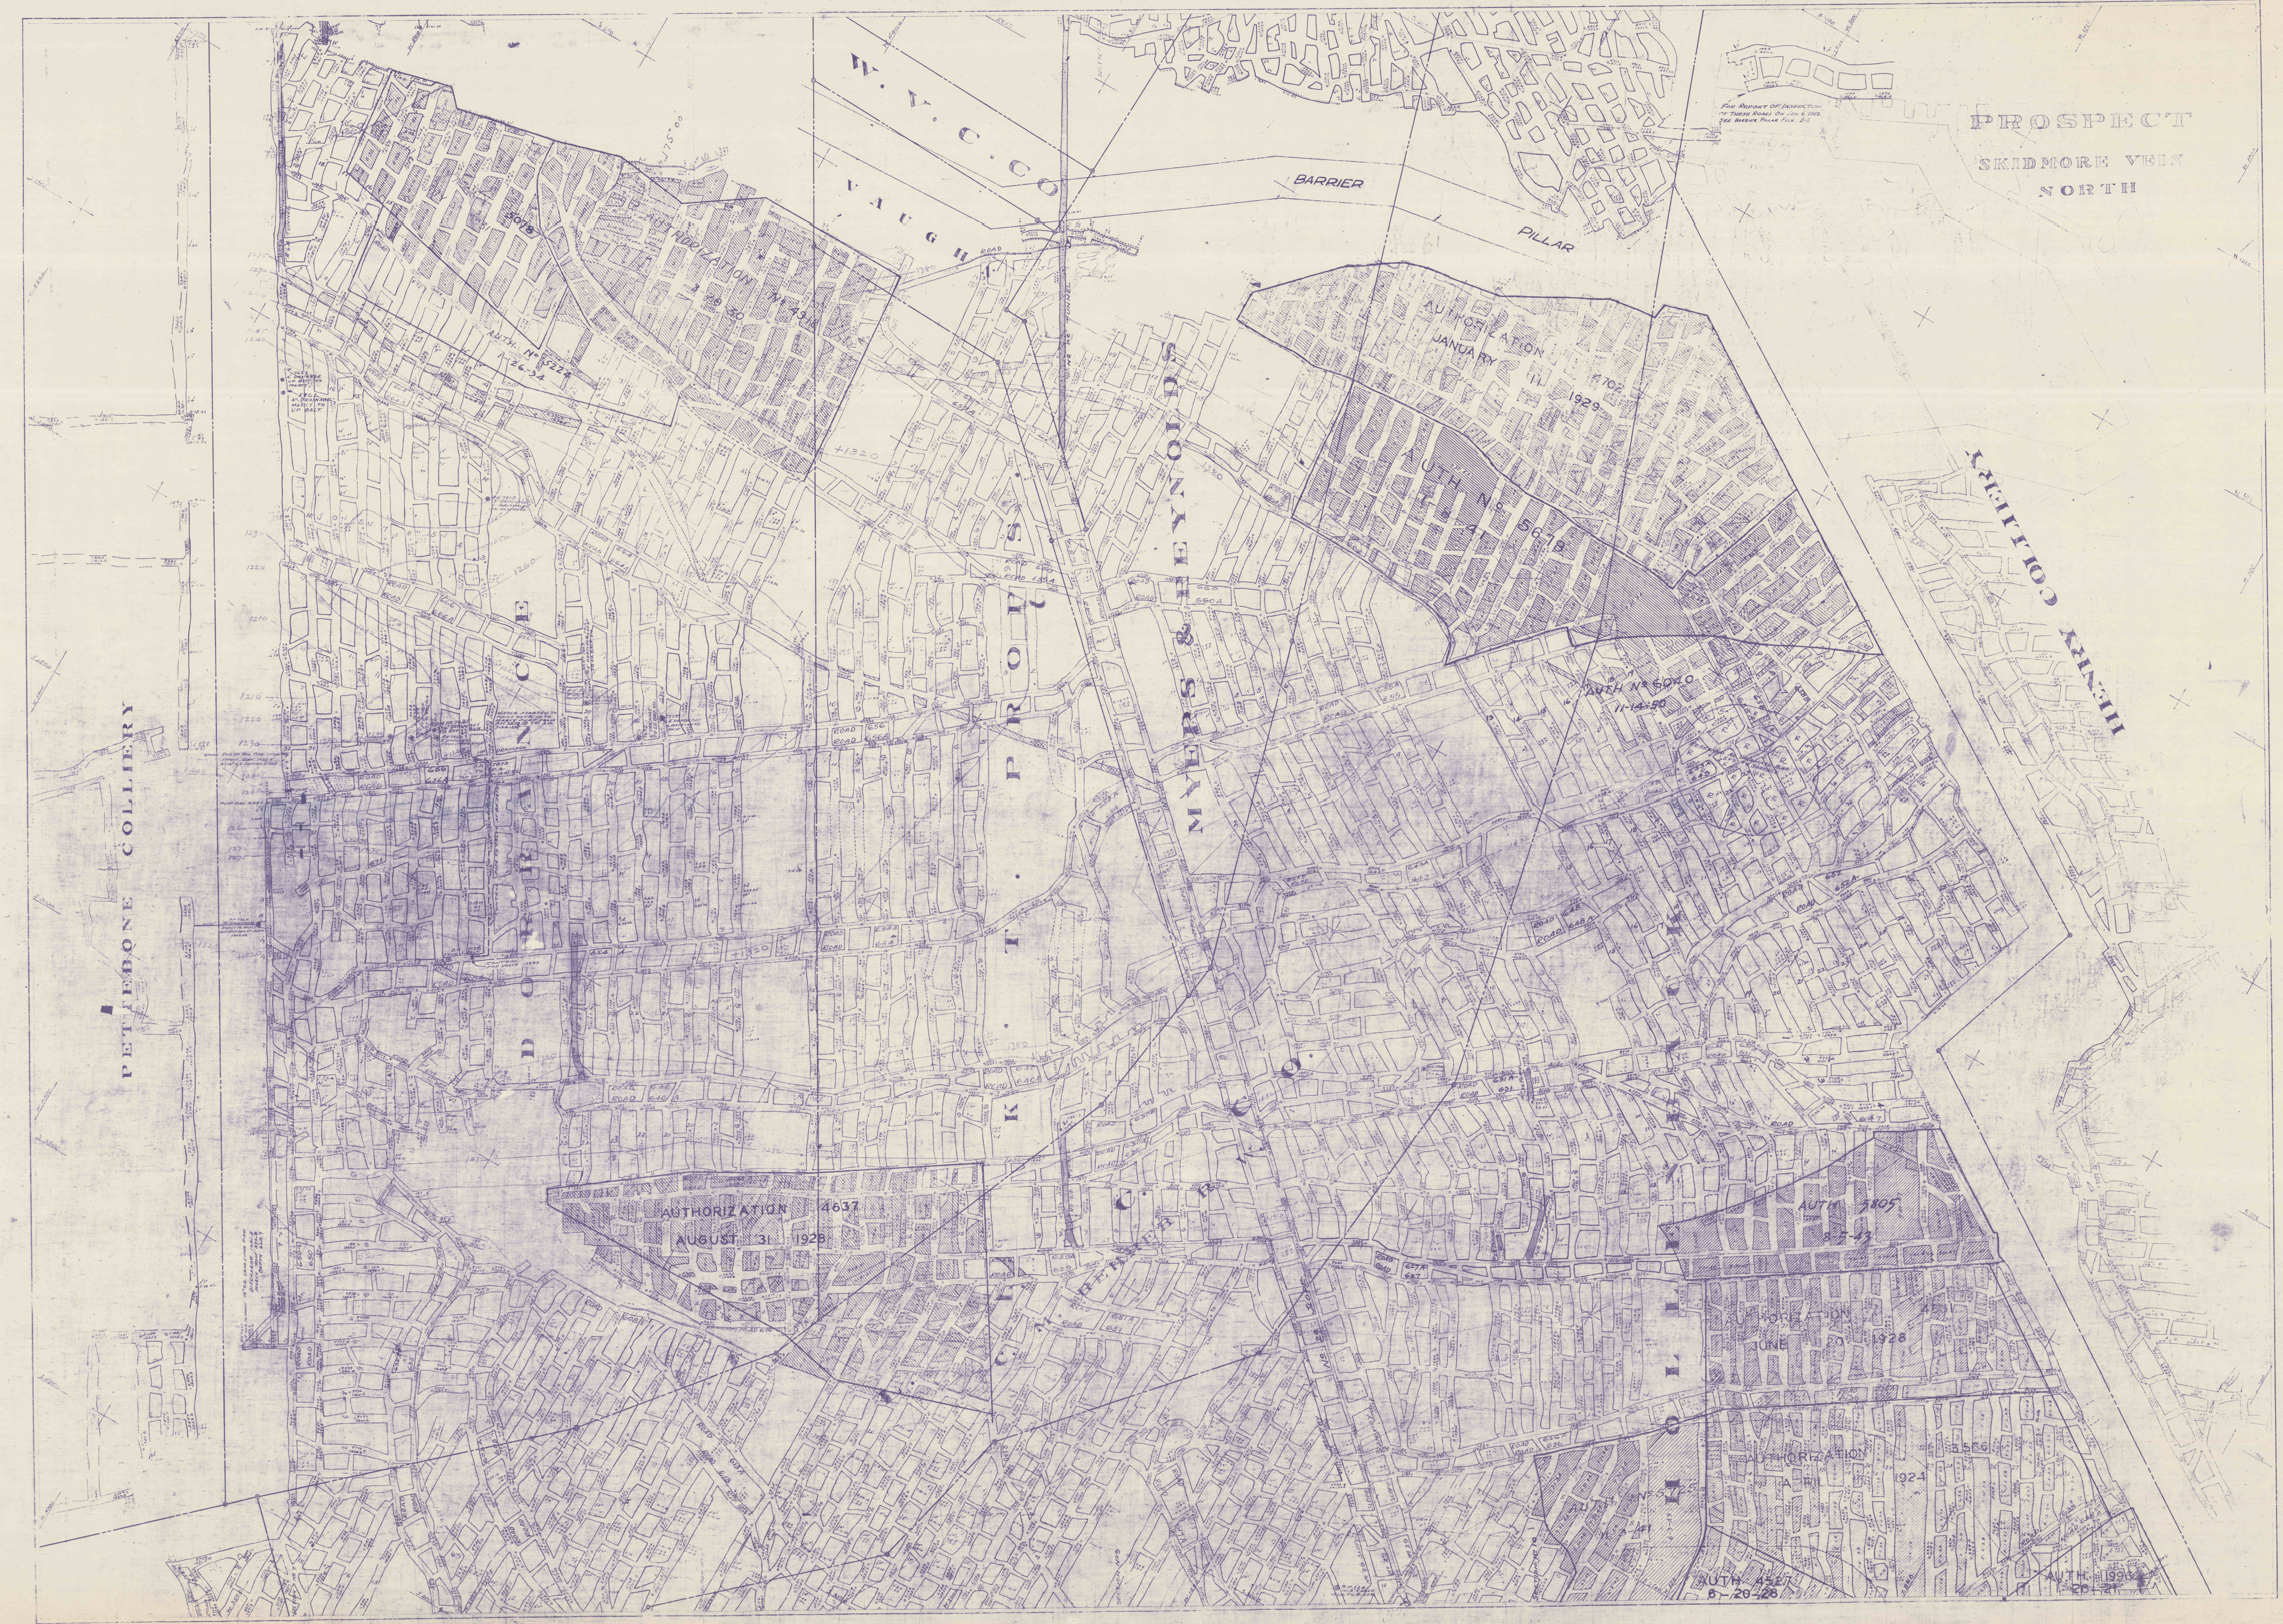
PROSPECT
SKIDMORE VEIN
NORTH
FOR REPORT OF INSPECTION OF THESE ROADS ON JAN. 6 1942 SEE BARRIER PILLAR FILE B-2
W. V. C. CO
VAUGHN
BARRIER
PILLAR
AUTHORIZATION No 4318
5018
AUTH. No 5224 1-26-34
AUTHORIZATION JANUARY 11 1929 4702
AUTH. No 5679 1-8-41
AUTH. No 6040 11-14-50
HENRY COLLIERY
PETTEBONE COLLIERY
DORRANCE
K. T. PROPS.
MYERS & REYNOLDS
No 56 TUNNEL
No 29 SLOPE
No 96 TUNNEL
HOLLENBACK
AUTHORIZATION 4637 AUGUST 31 1928
AUTH. 5805 8-5-43
AUTHORIZATION 4581 JUNE 20 1928
AUTHORIZATION 3566 APRIL 1924
AUTH. 4527 6-20-28
AUTH. 1991 1-20-21
ROAD

MARCY