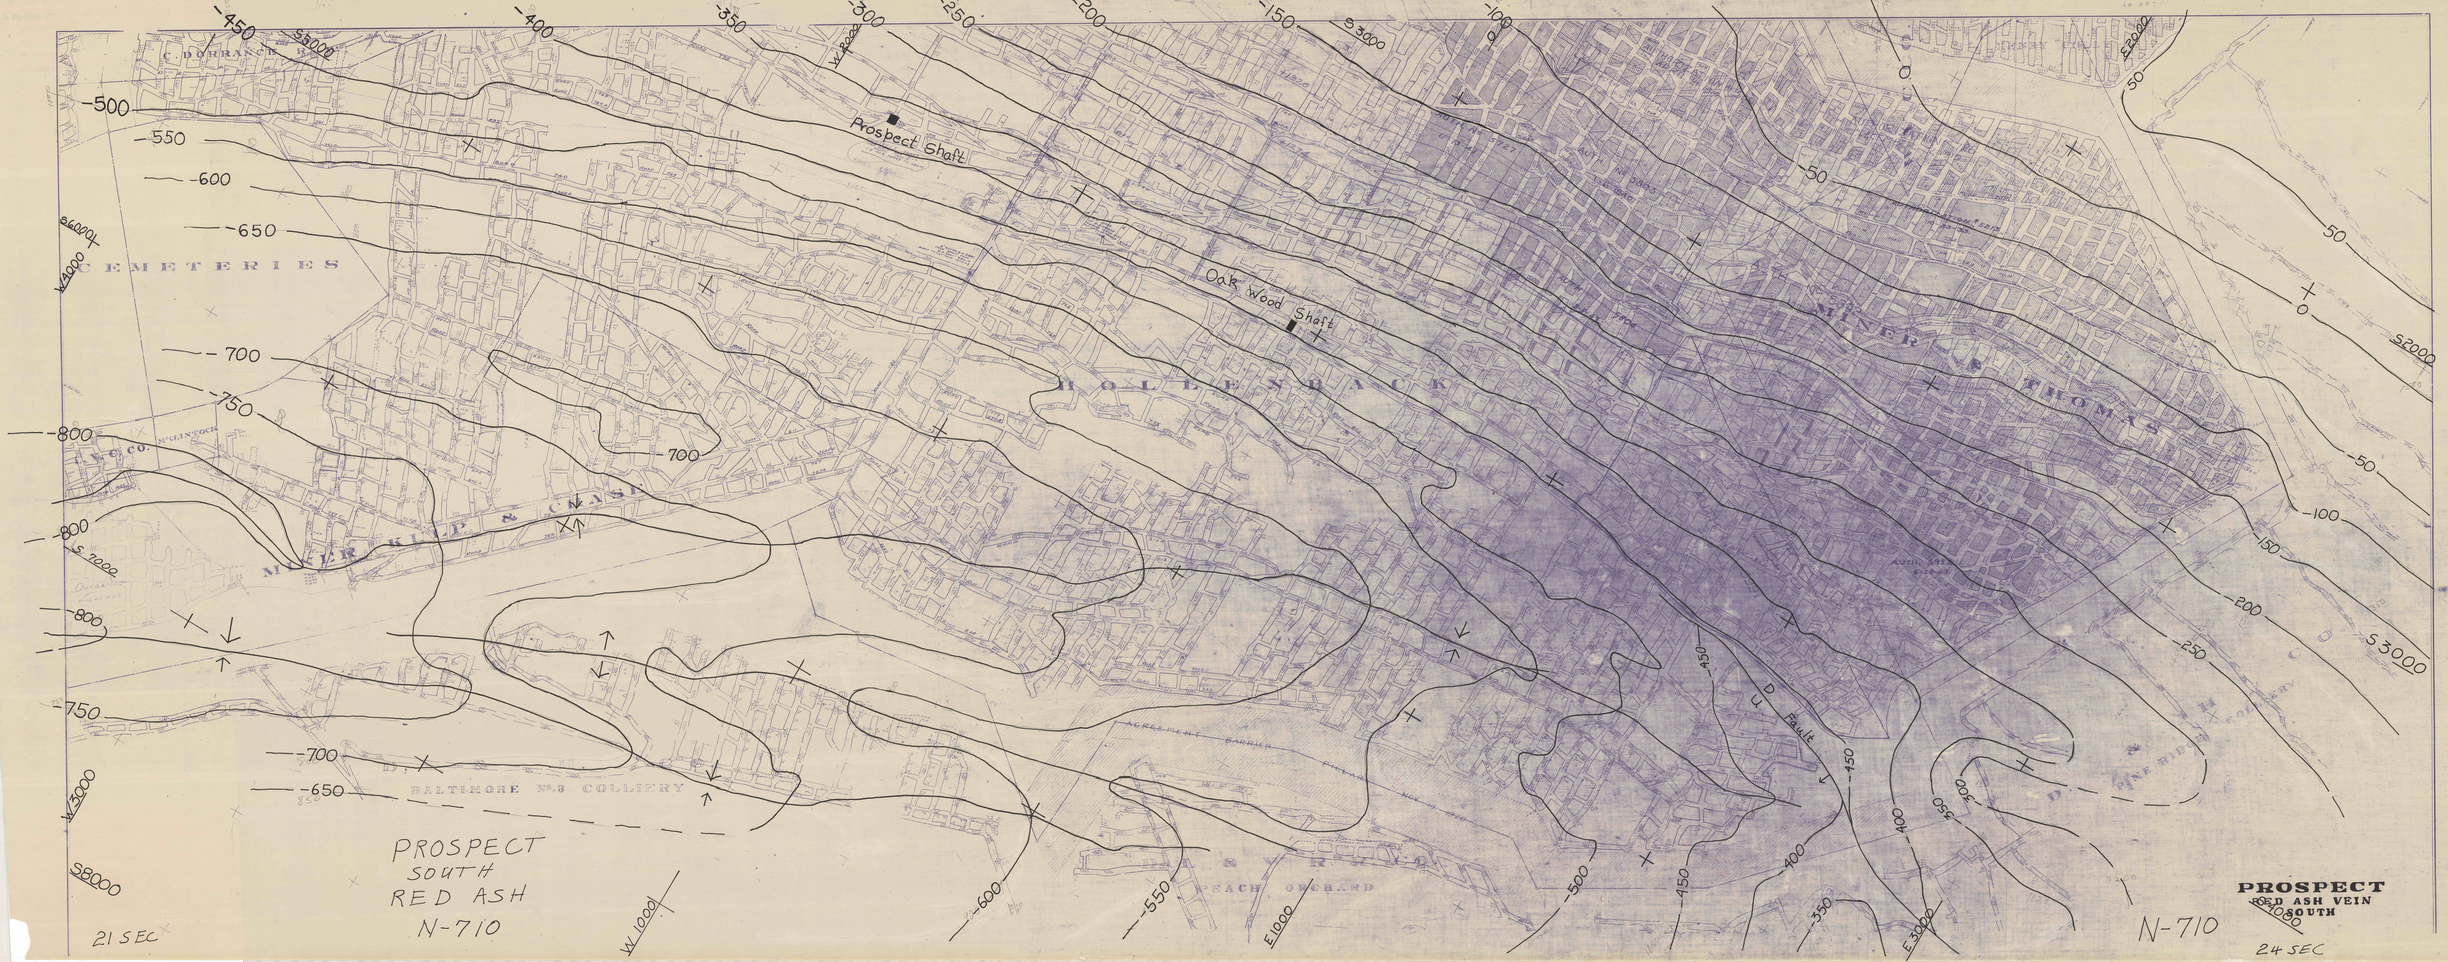

PROSPECT
SOUTH
RED ASH
N-710

PROSPECT
RED ASH VEIN
SOUTH

N-710

21 SEC

24 SEC

F

C. DORRANCE
CEMETERIES
HOLLENBACK
MINER & THOMAS
MINER KLIP & CASE
BALTIMORE No.3 COLLIERY
PEACH ORCHARD
Prospect Shaft
Oak Wood Shaft
U
D
Fault
-450
-400
-350
-300
-250
-200
-150
-100
-50
0
50
-500
-550
-600
-650
-700
-750
-800
700
-700
-650
-600
-550
-500
450
400
350
300
150
200
250
S5000
S3000
S2000
S6000
S7000
S8000
S4000
W4000
W3000
W2000
W1000
E1000
E2000
E3000