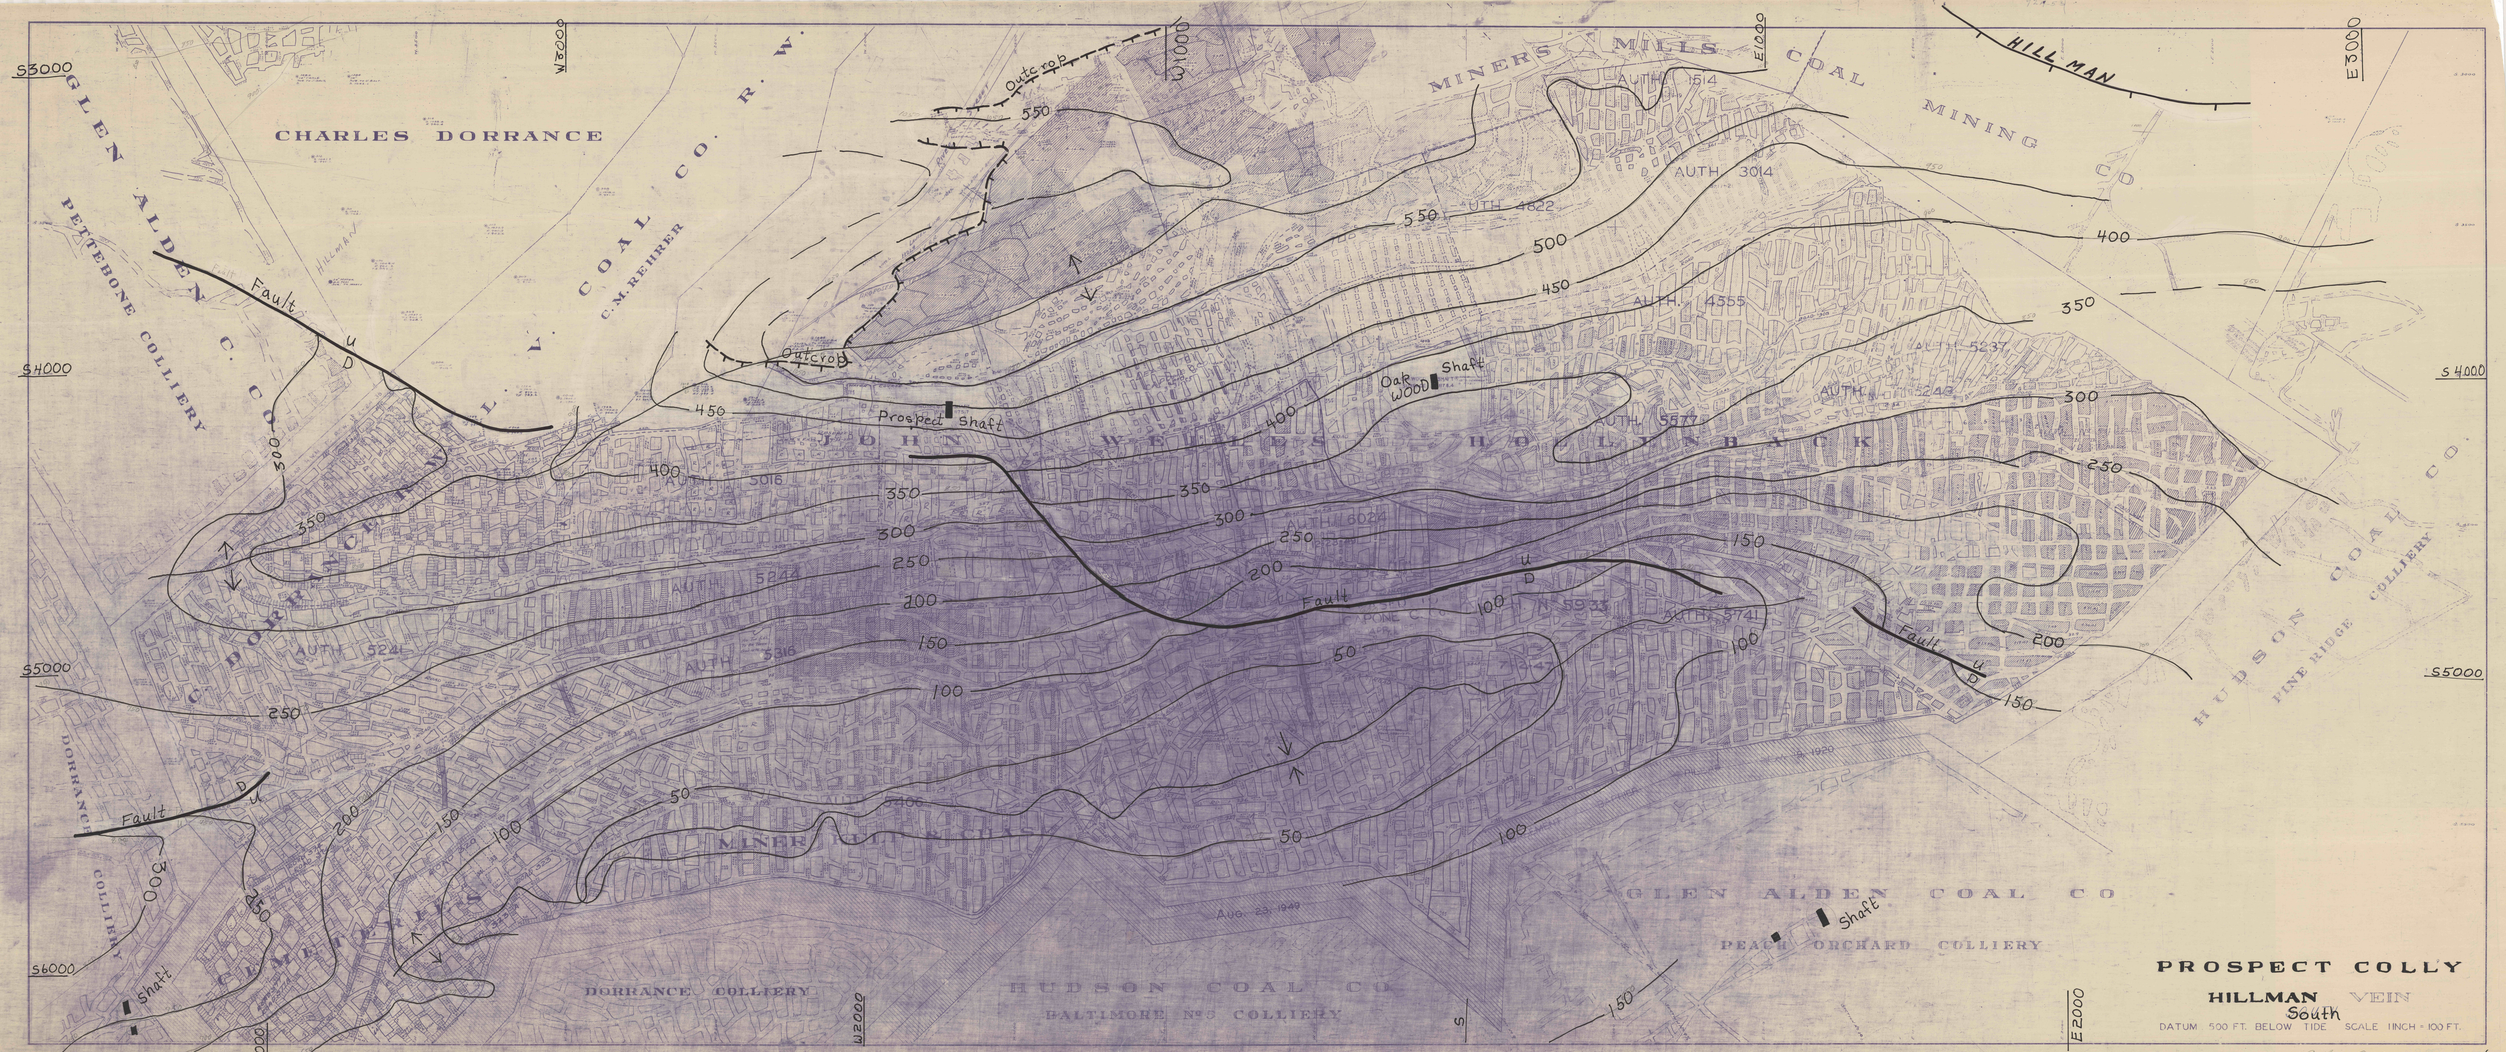
CHARLES DORRANCE
GLEN ALDEN C. CO.
PETTEBONE COLLIERY
C. M. REHRER
Fault
Outcrop
Prospect Shaft
Oak Wood Shaft
JOHN WELLES HOLLISBACK
AUTH. 5016
AUTH. 5244
AUTH. 5224
AUTH. 5316
AUTH. 6024
AUTH. 5777
AUTH. 5741
AUTH. 1514
AUTH. 3014
AUTH. 4822
AUTH. 4555
AUTH. 5237
AUTH. 243
MINERS MILLS COAL MINING CO
HILLMAN
HUDSON COAL CO
PINE RIDGE COLLIERY
DORRANCE COLLIERY
Shaft
MINERS MILLS
DORRANCE COLLIERY
HUDSON COAL CO
BALTIMORE No 6 COLLIERY
GLEN ALDEN COAL CO
PEACH ORCHARD COLLIERY
Aug. 23, 1949
S3000
S4000
S5000
S6000
W2000
W1000
E1000
E2000
E3000
PROSPECT COLLY
HILLMAN VEIN
South
DATUM 500 FT. BELOW TIDE SCALE 1INCH = 100 FT.