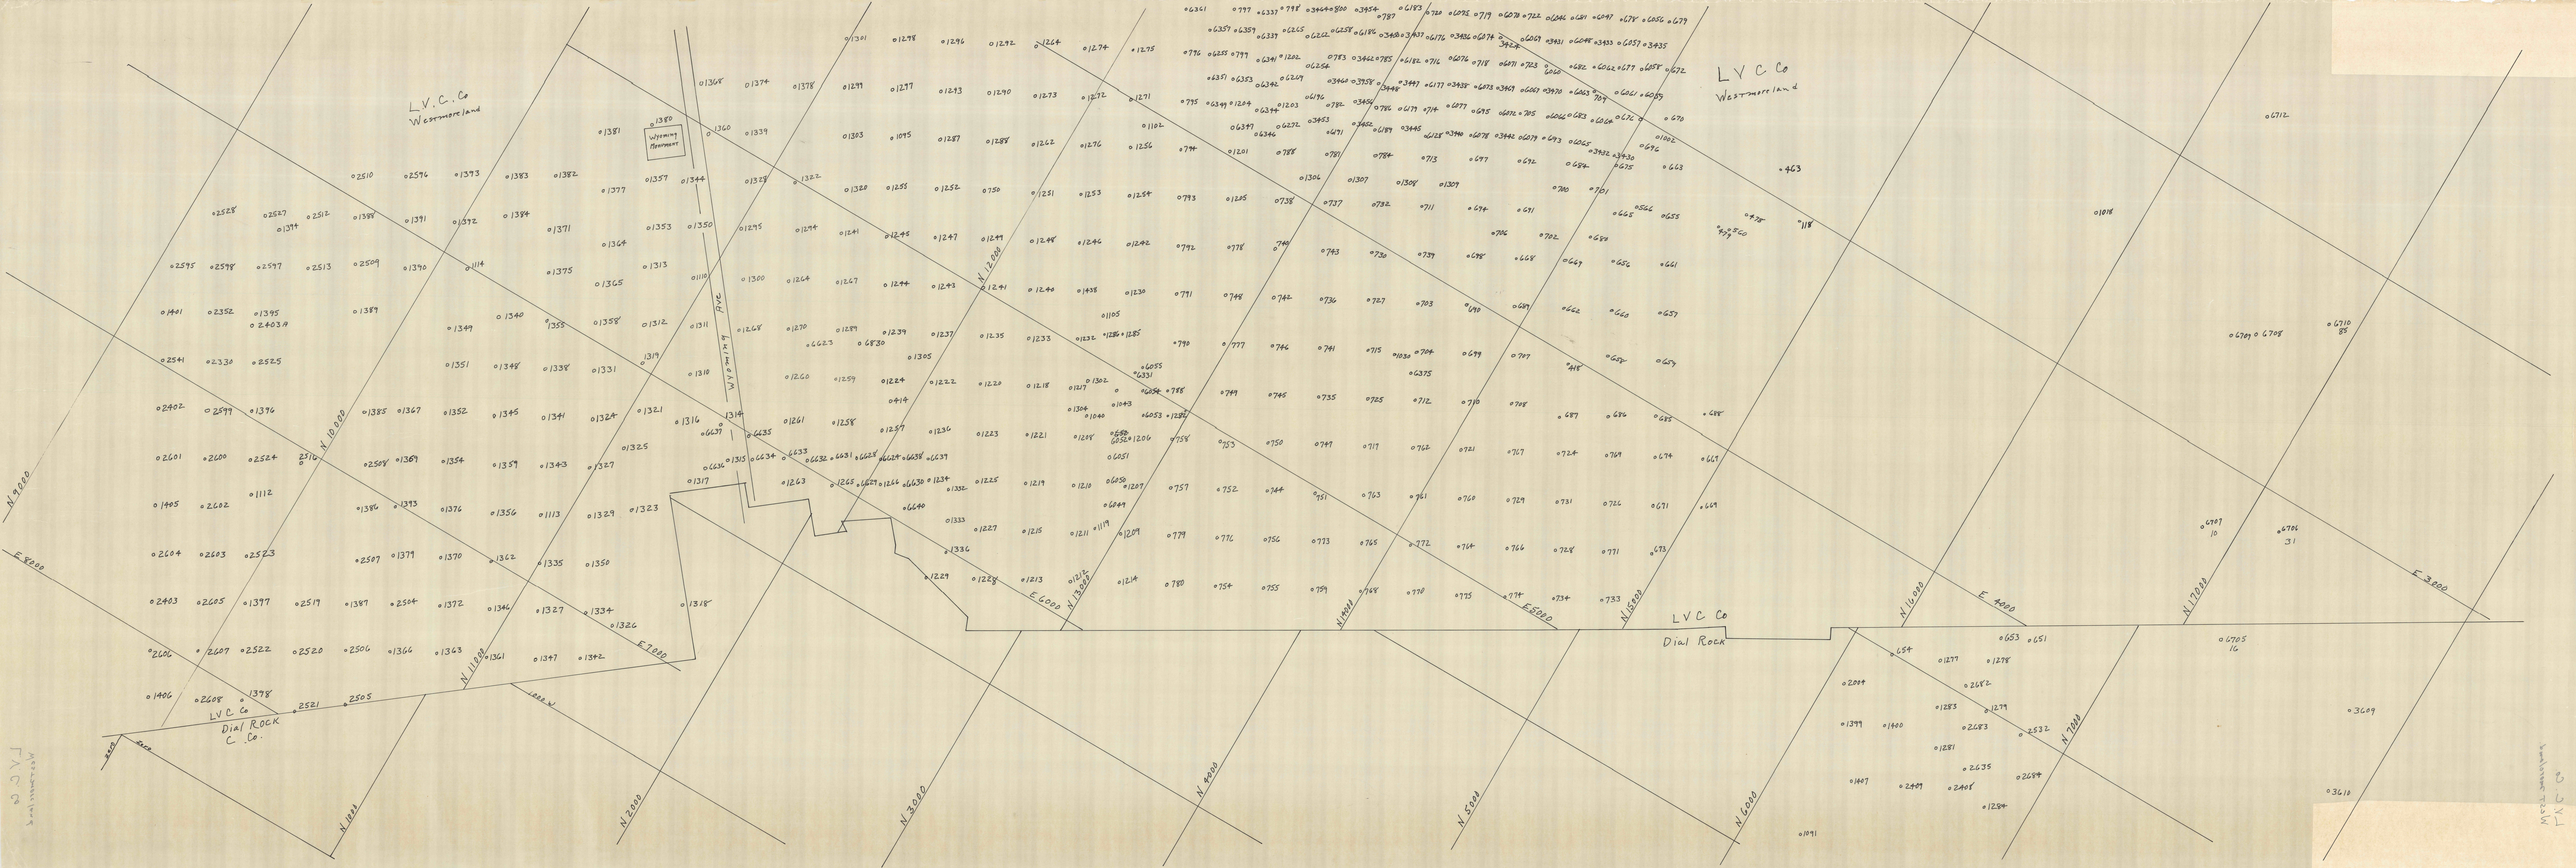

L.V.C. Co
Westmoreland
Wyoming Monument
Wyoming Ave
L V C Co
Westmoreland
463
LVC Co
Dial Rock
LVC Co
Dial ROCK
C. Co.
N 1000
N 2000
N 3000
N 4000
N 5000
N 6000
N 7000
N 9000
N 10000
N 11000
N 12000
N 13000
N 14000
N 15000
N 16000
N 17000
E 8000
E 7000
E 6000
E 5000
E 4000
E 3000
1000 N
zero
L.V.C. Co.
Westmoreland