Exeter (West)
LVC Co.

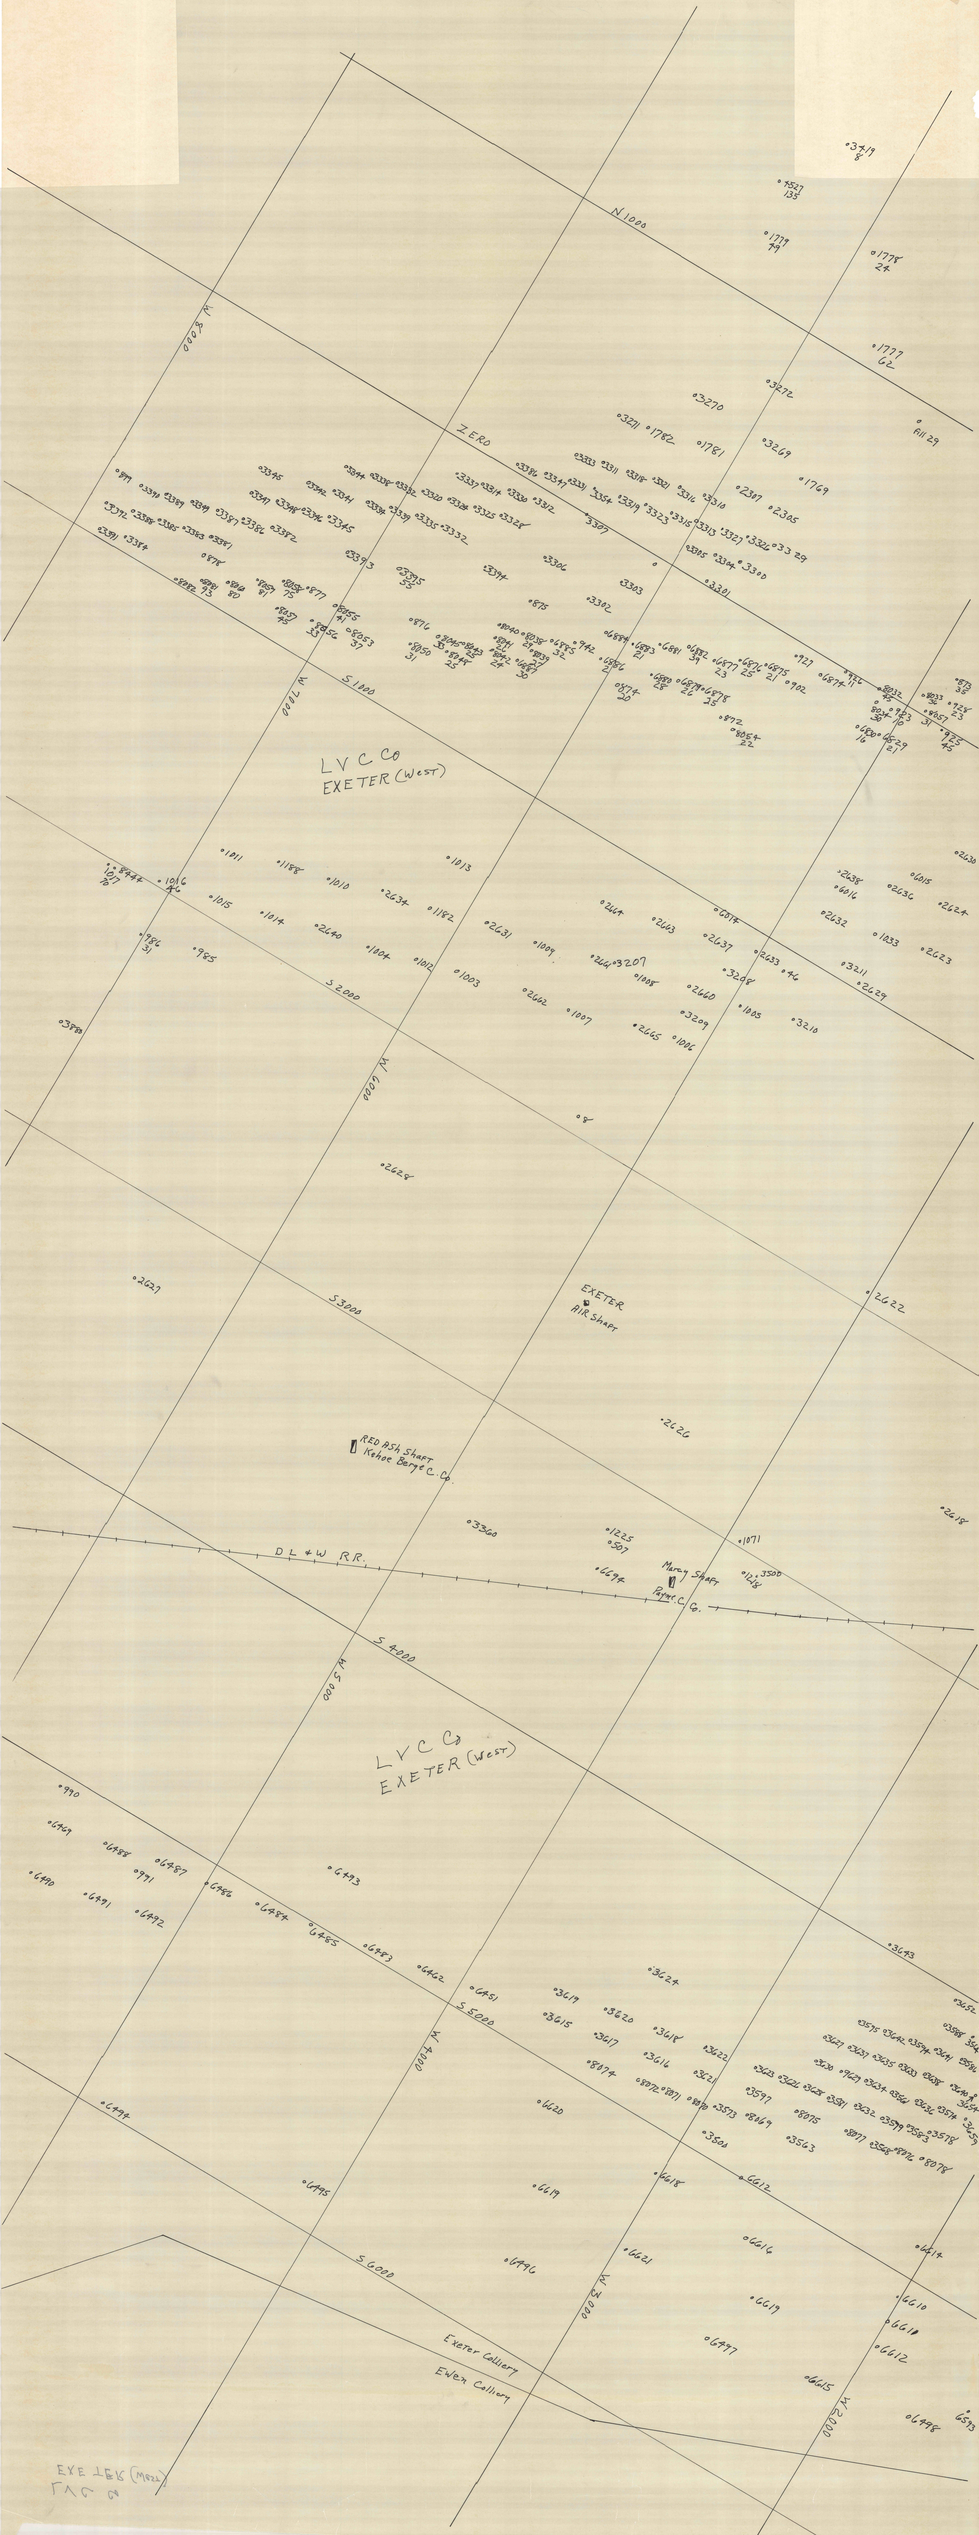

EXETER (West)
LVC Co