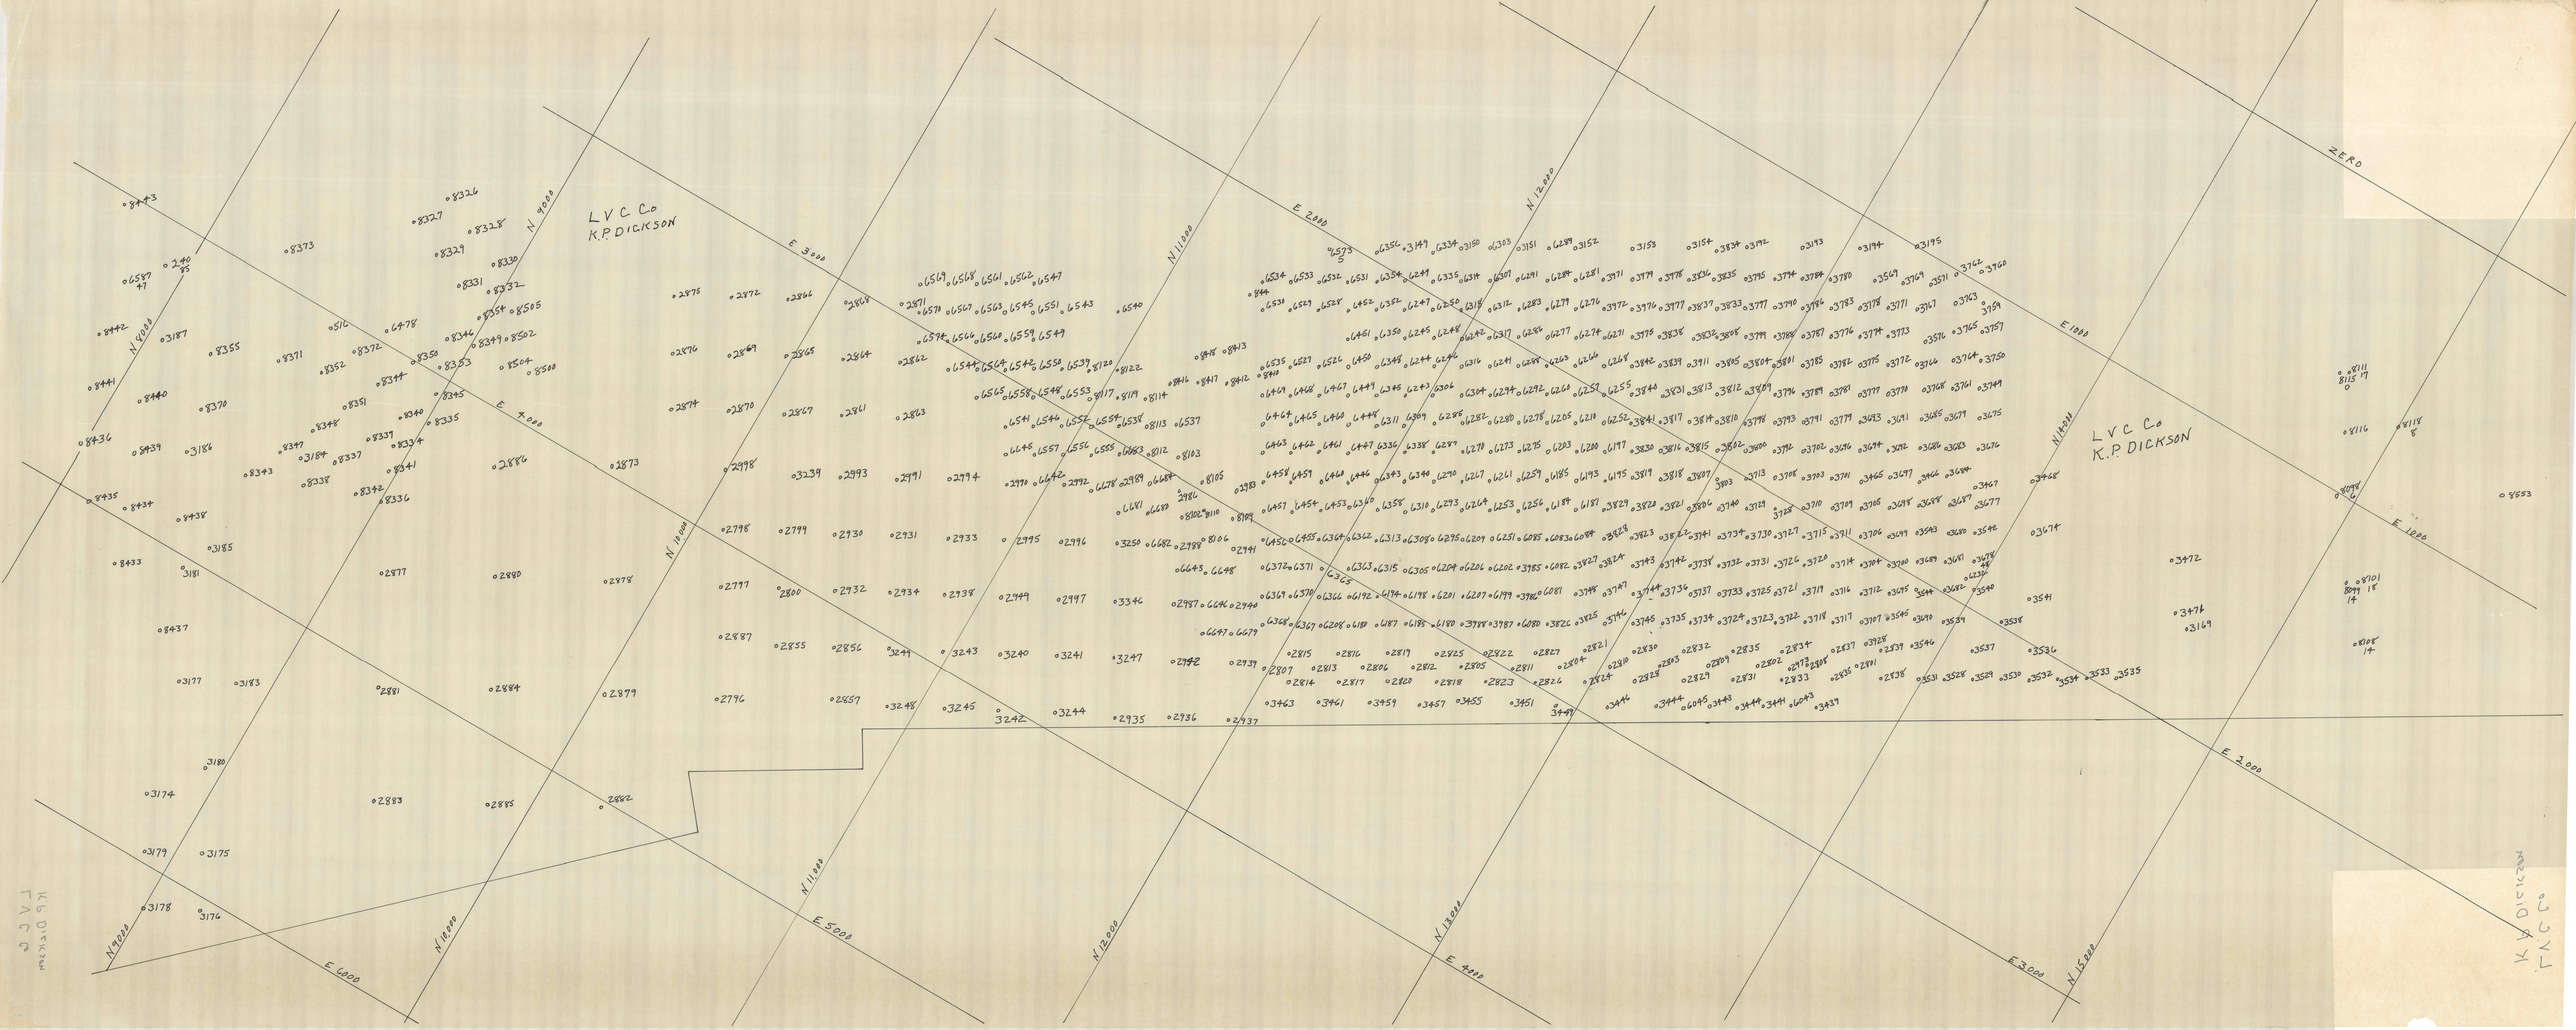
LVC Co
K.P. DICKSON
LVC Co
K.P. DICKSON
ZERO
E 1000
E 2000
E 3000
E 4000
E 5000
E 6000
N 9000
N 10000
N 11000
N 12000
N 13000
N 14000
N 15000