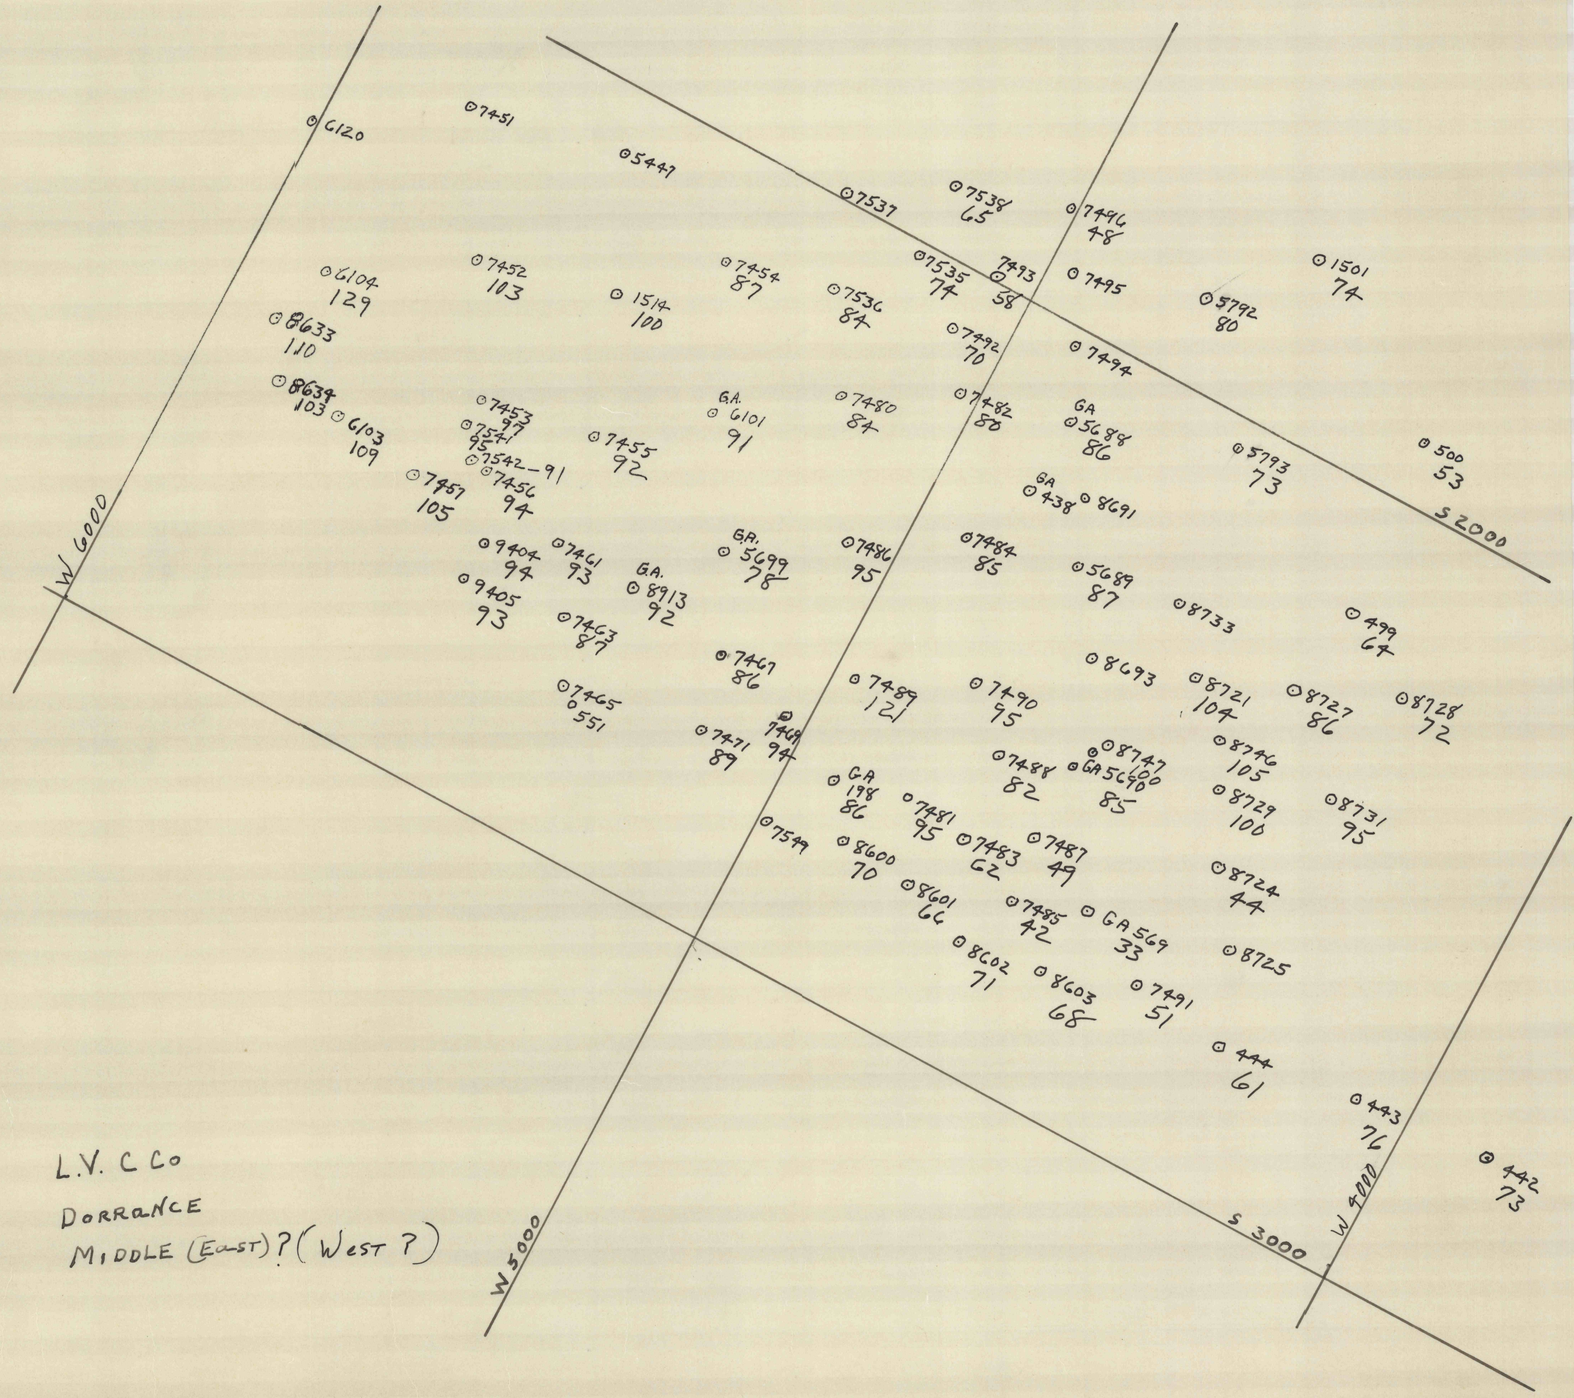

L.V. C Co
DORRANCE
MIDDLE (East)? (West ?)

Dorrance