


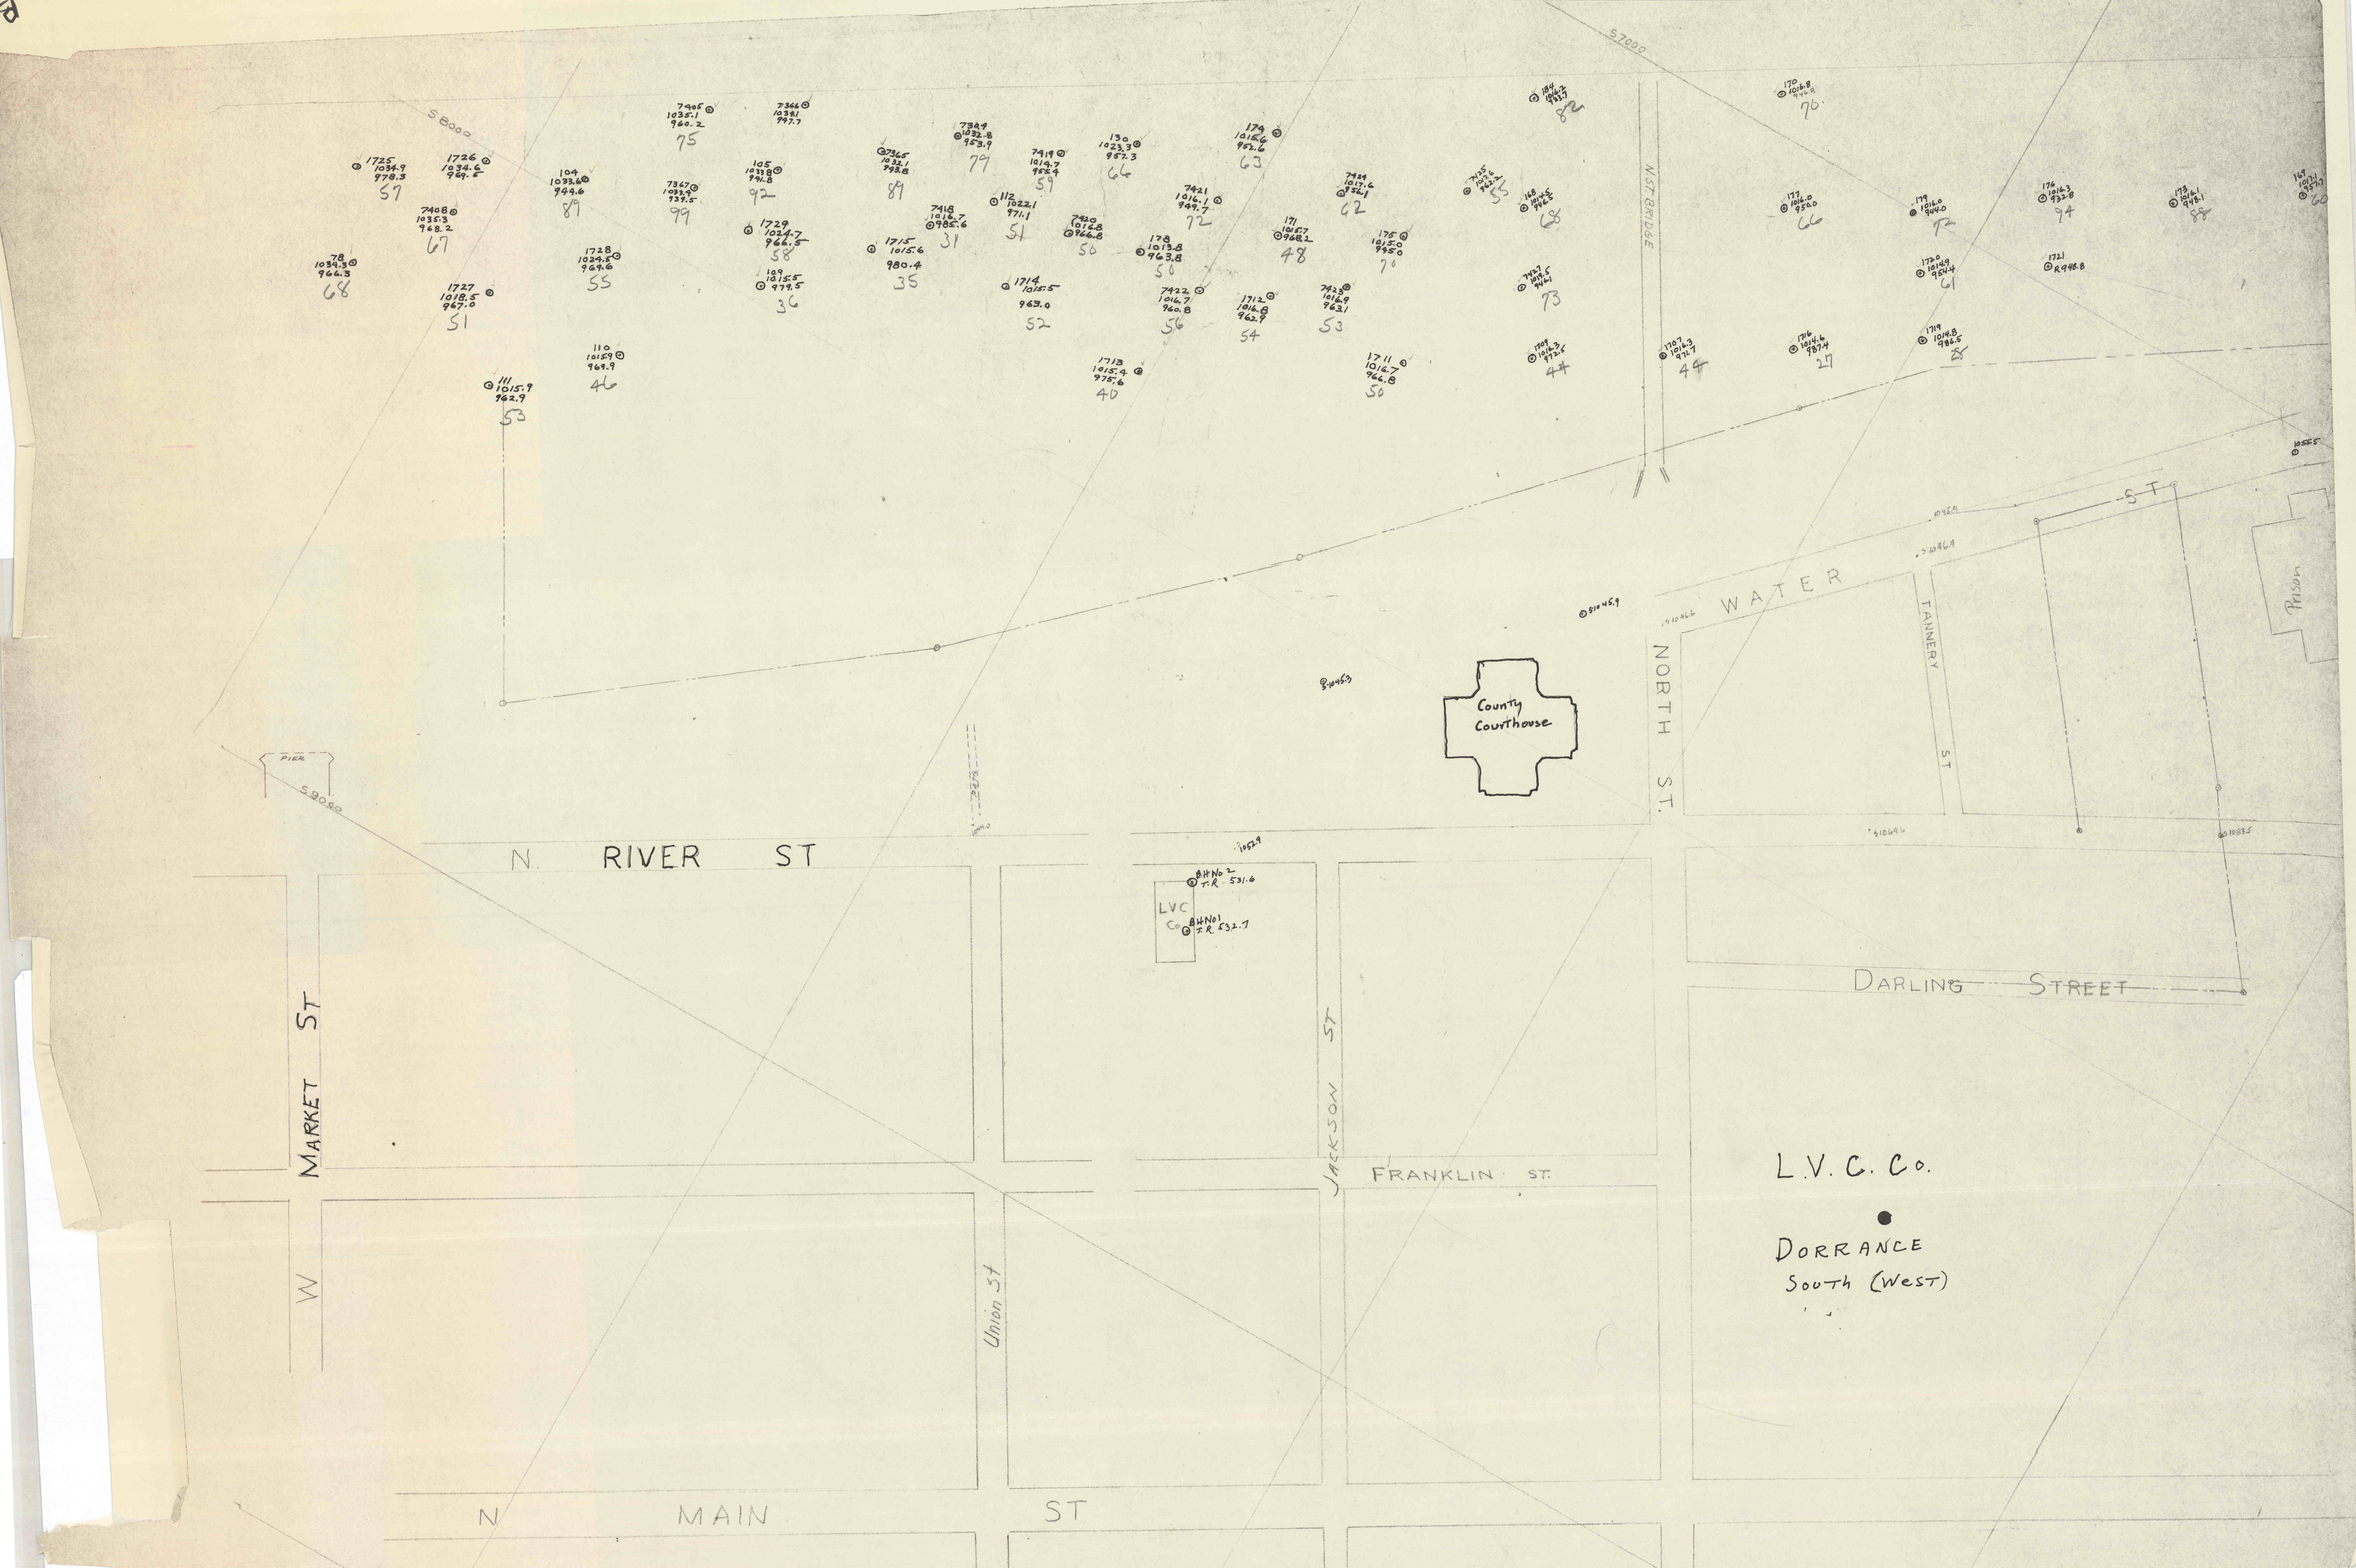

PIER
590.0

MARKET ST

W

N. RIVER ST

N MAIN ST

Union St

JACKSON ST

FRANKLIN ST

DARLING STREET

NORTH ST

County
Courthouse

L.V.C. Co.

DORRANCE
South (West)

TANNERY ST

Prison

78 1034.3 966.3 68
1725 1034.9 978.3 57
1726 1034.6 969.5 67
7408 1035.3 968.2 67
1727 1018.5 967.0 51
111 1015.7 962.7 53
104 1033.6 944.6 87
1728 1034.8 967.6 55
110 1015.9 969.9 46
7905 1035.1 960.2 75
7346 1034.1 977.7 75
105 1033.8 941.8 92
7347 1033.5 937.5 99
1729 1024.7 964.5 58
109 1015.5 979.5 36
1715 1015.6 980.4 35
7418 1016.7 985.6 31
112 1022.1 971.1 51
1714 1015.5 963.0 52
7420 1016.8 966.8 50
173 1015.8 963.8 50
7422 1016.7 960.8 56
1713 1015.4 975.6 40
130 1023.3 957.3 66
7419 1014.7 952.4 59
171 1015.7 968.2 48
7421 1016.1 944.7 72
1712 1016.8 962.9 54
7423 1016.9 963.1 53
1711 1016.7 966.8 50
170 1016.8 960.2 82
