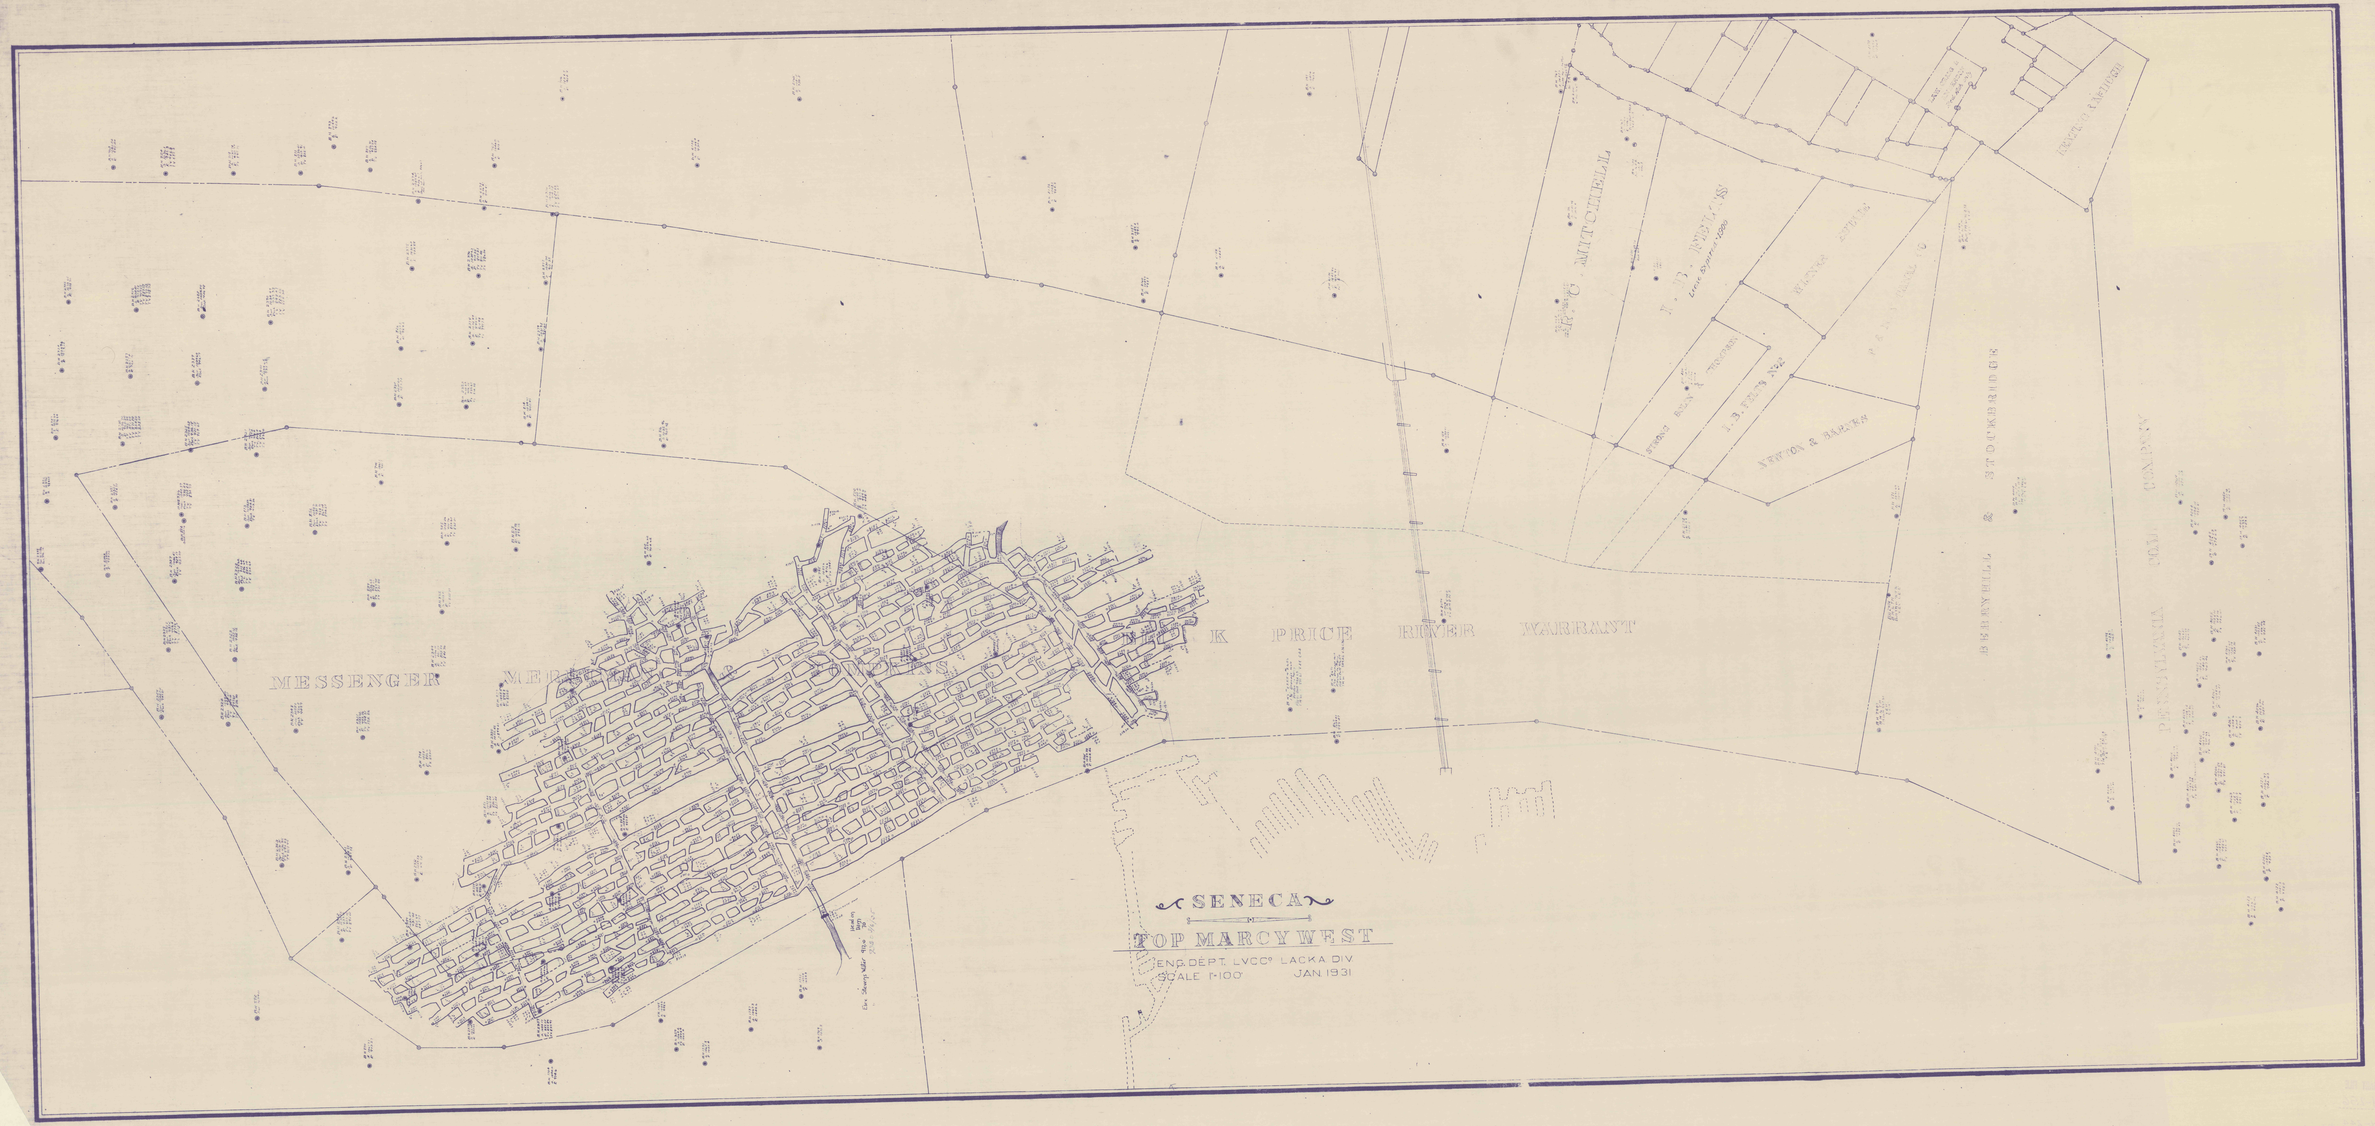
MESSENGER
K PRICE RIVER WARRANT
SENECA
TOP MARCY WEST
ENG. DEPT. LVCO LACKA DIV
SCALE 1-100 JAN. 1931