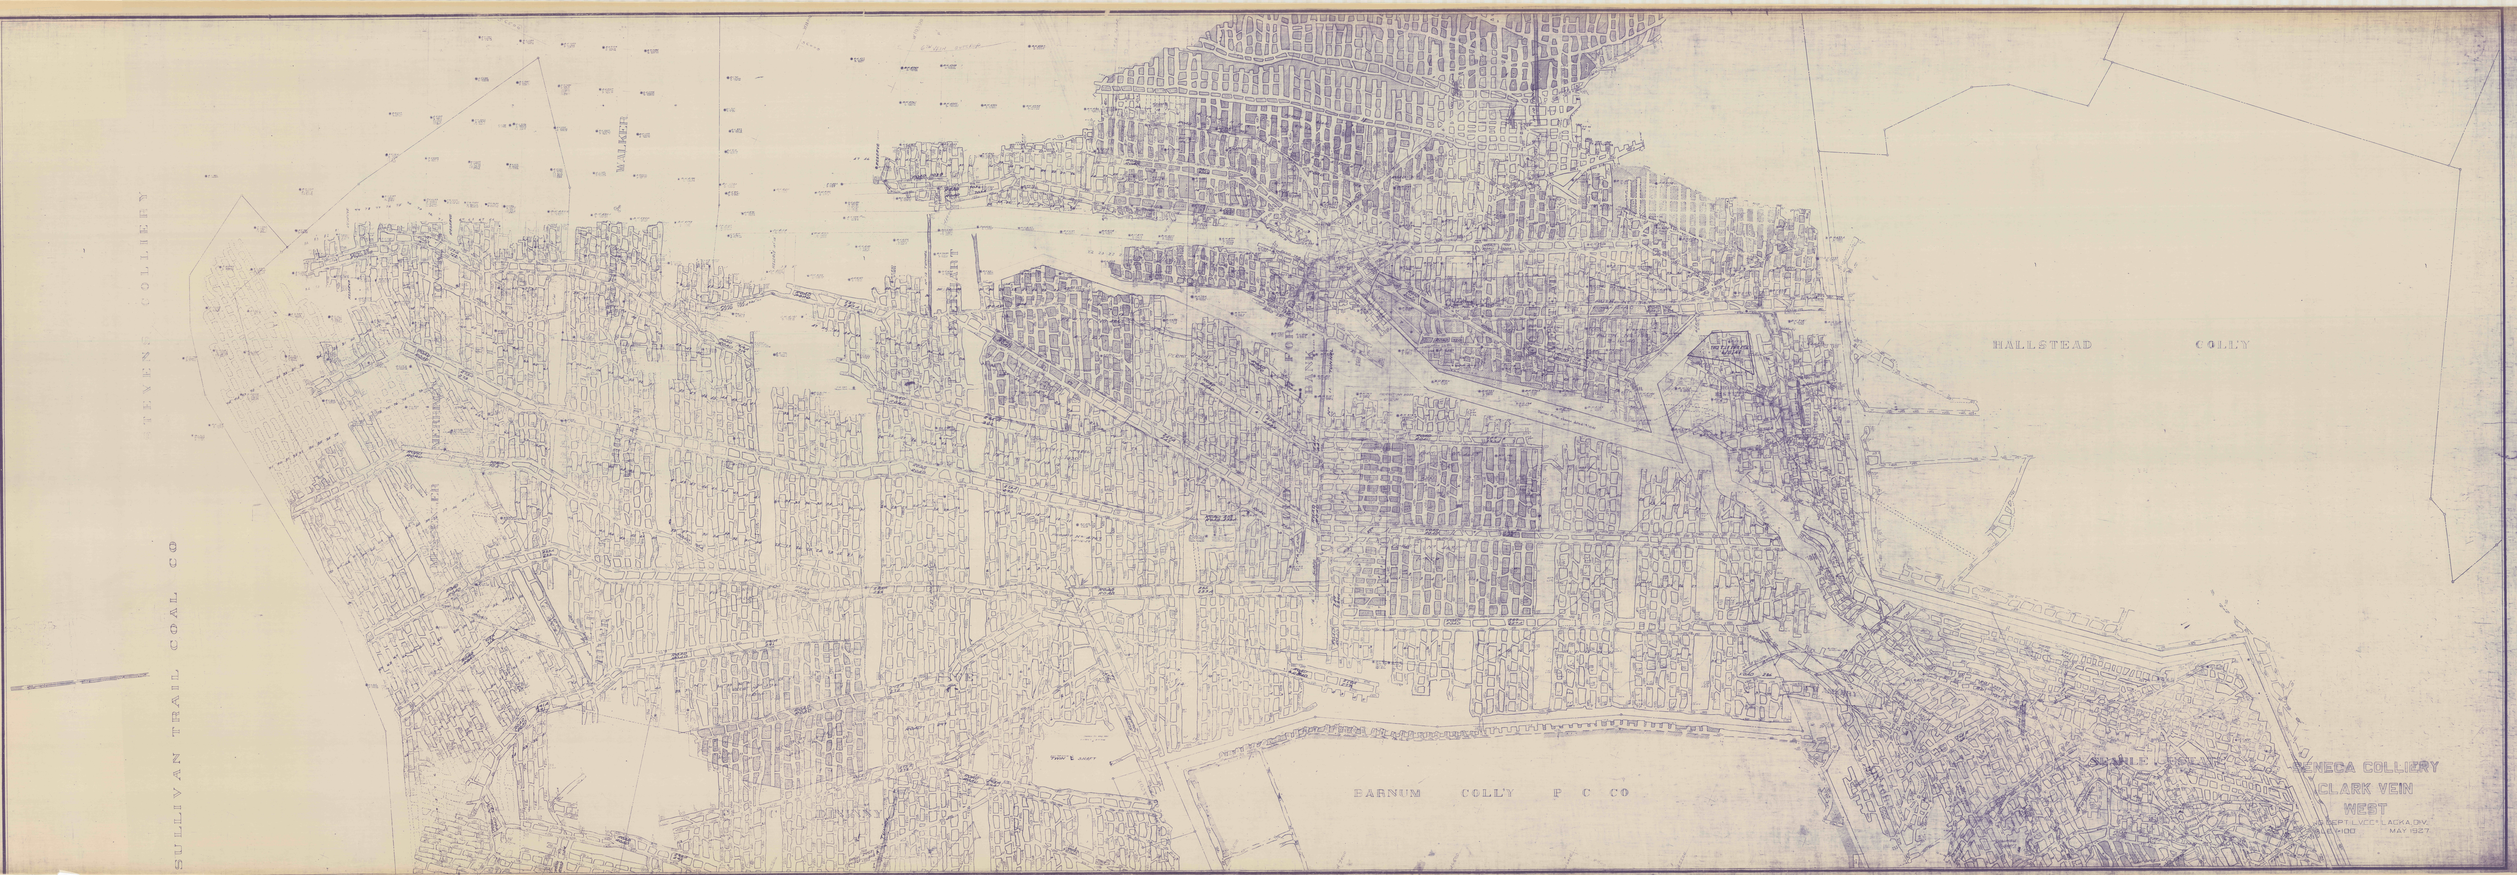
STEVENS COLLIERY
SULLIVAN TRAIL COAL CO
WALKER
HALLSTEAD COLLY
BARNUM COLLY P C CO
SENECA COLLIERY
CLARK VEIN
WEST
DEPT. LVCC LACKA. DIV.
MAY 1927