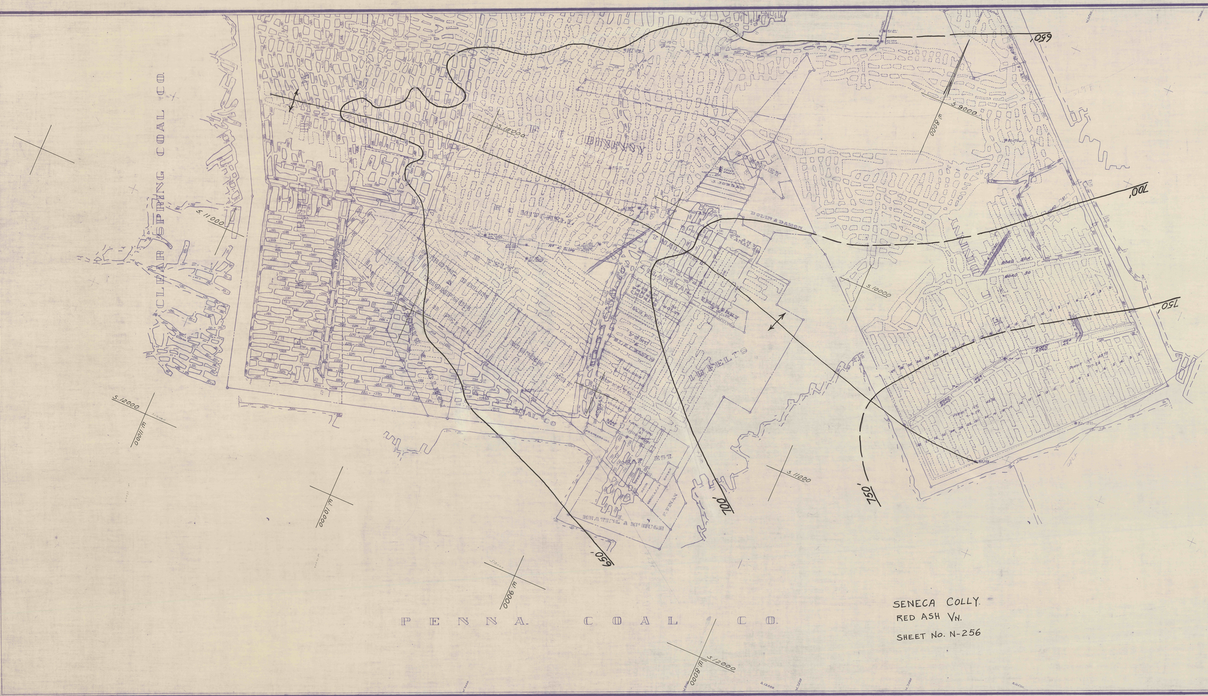
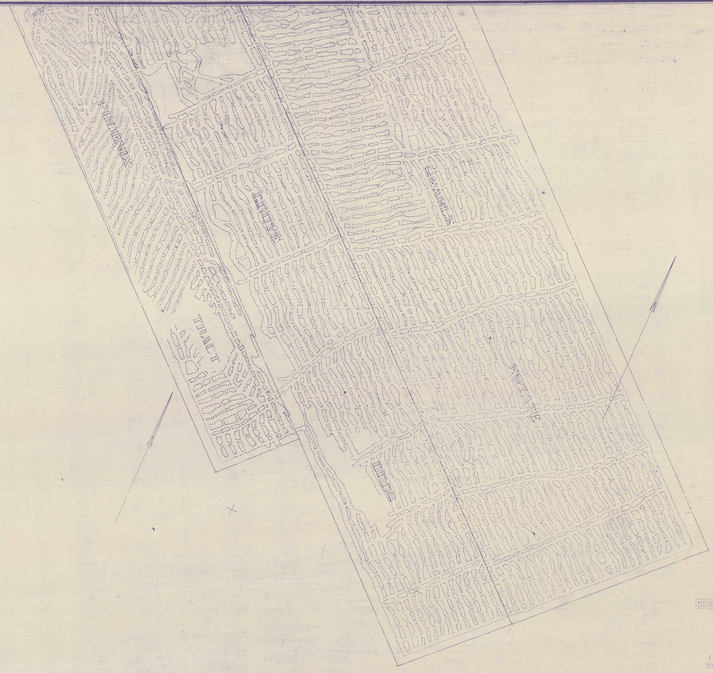

CLEARSPRING COAL CO
PENNA. COAL CO.
SENECA COLLY.
RED ASH VN.
SHEET No. N-256


TRACT
SENECA COLLIERY
SIXTH VEIN
SOUTH