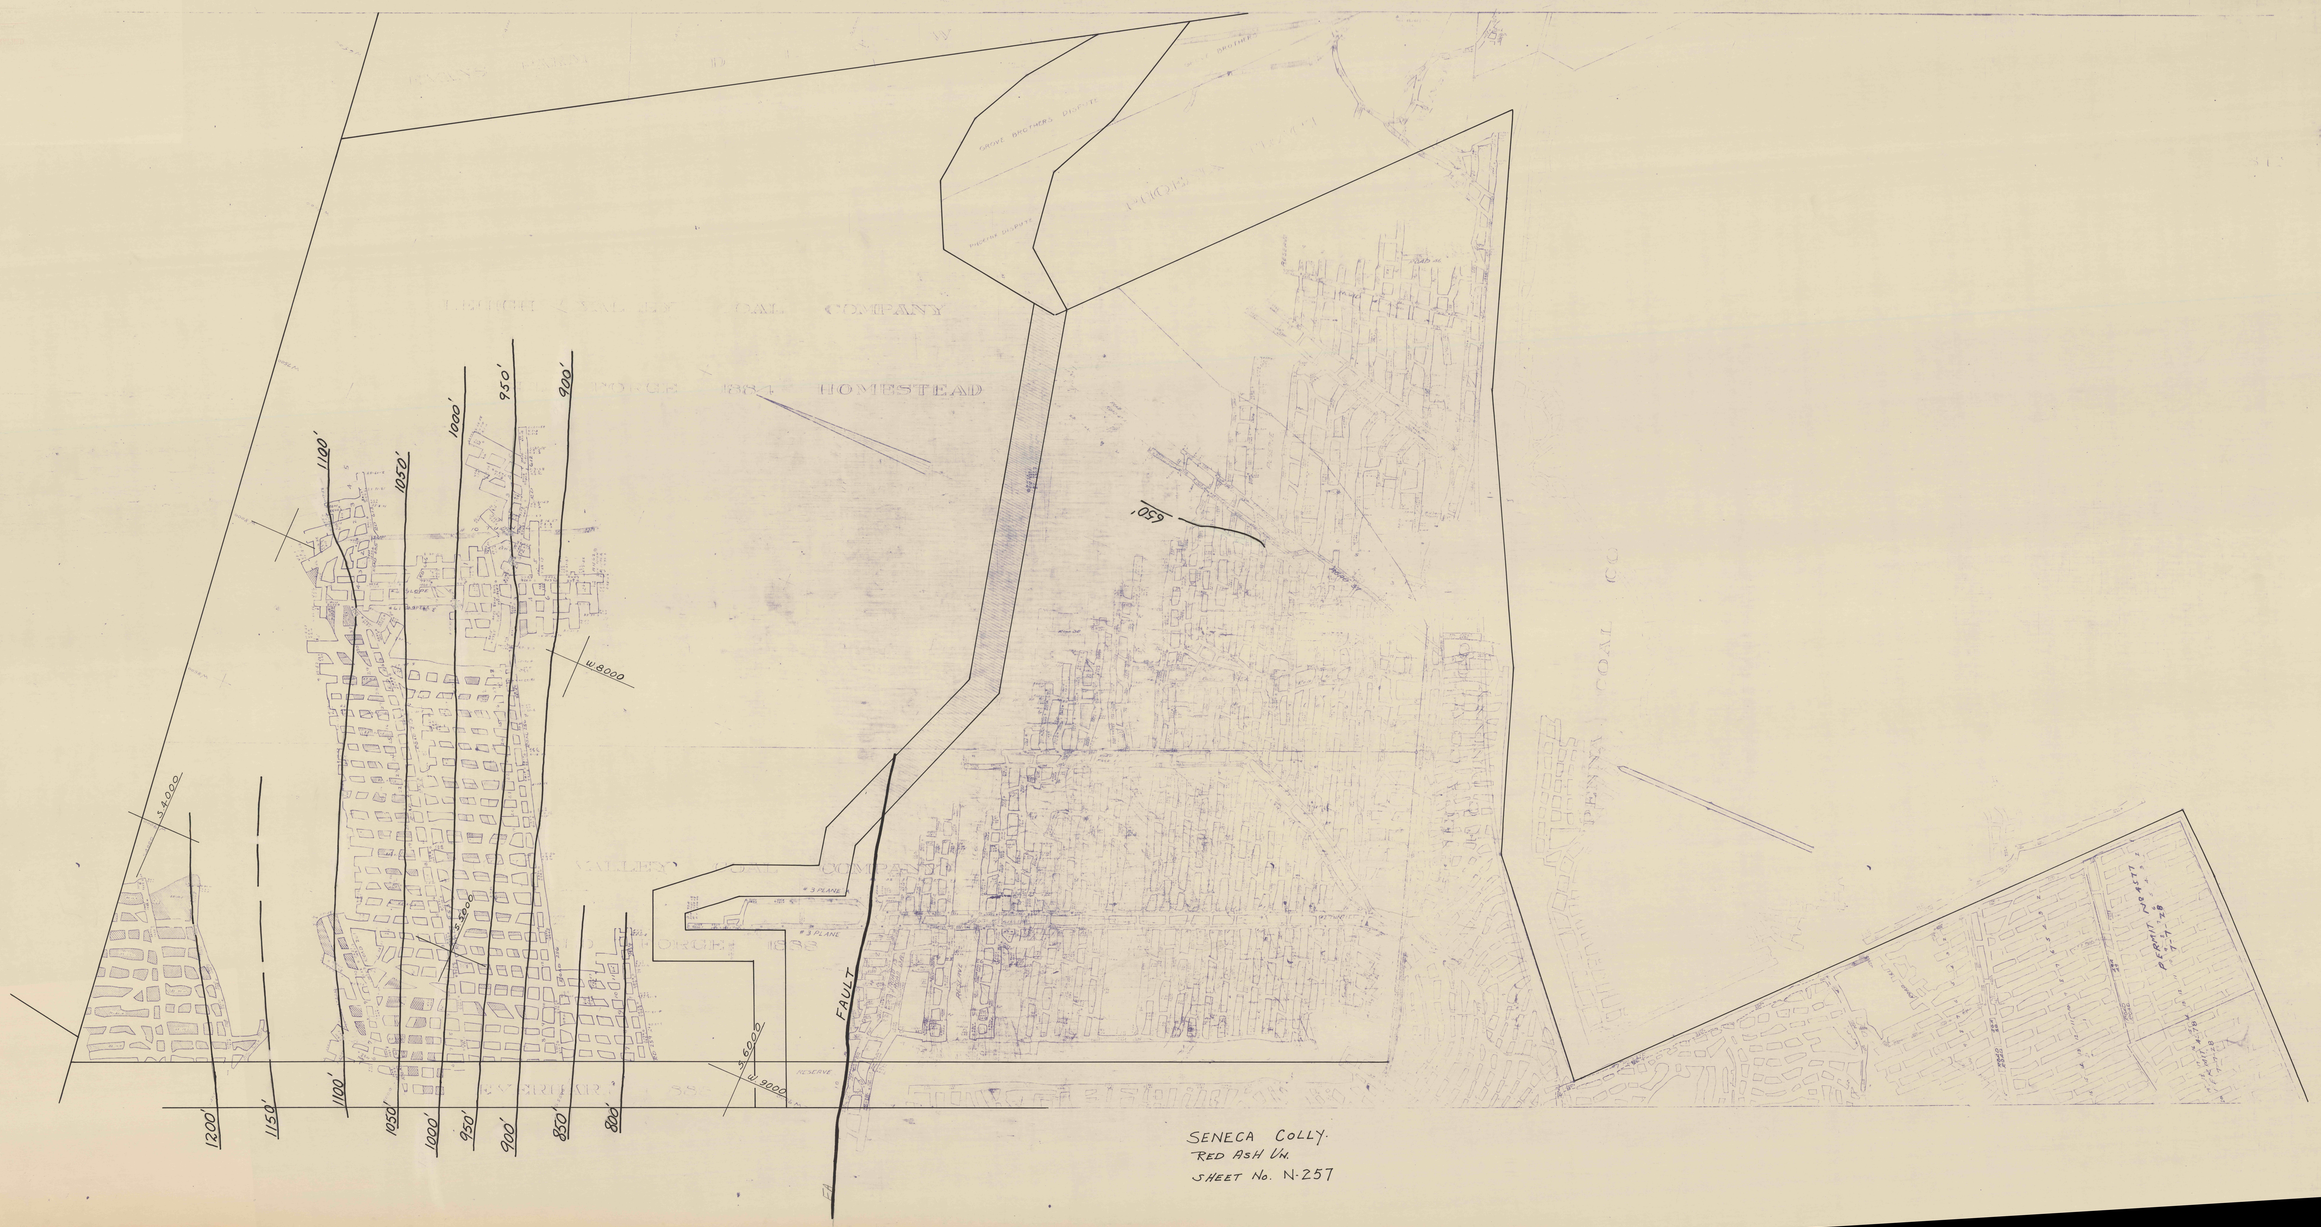

SENECA COLLY.
RED ASH VN.
SHEET No. N-257

SIXTH LEVEL
SENECA