


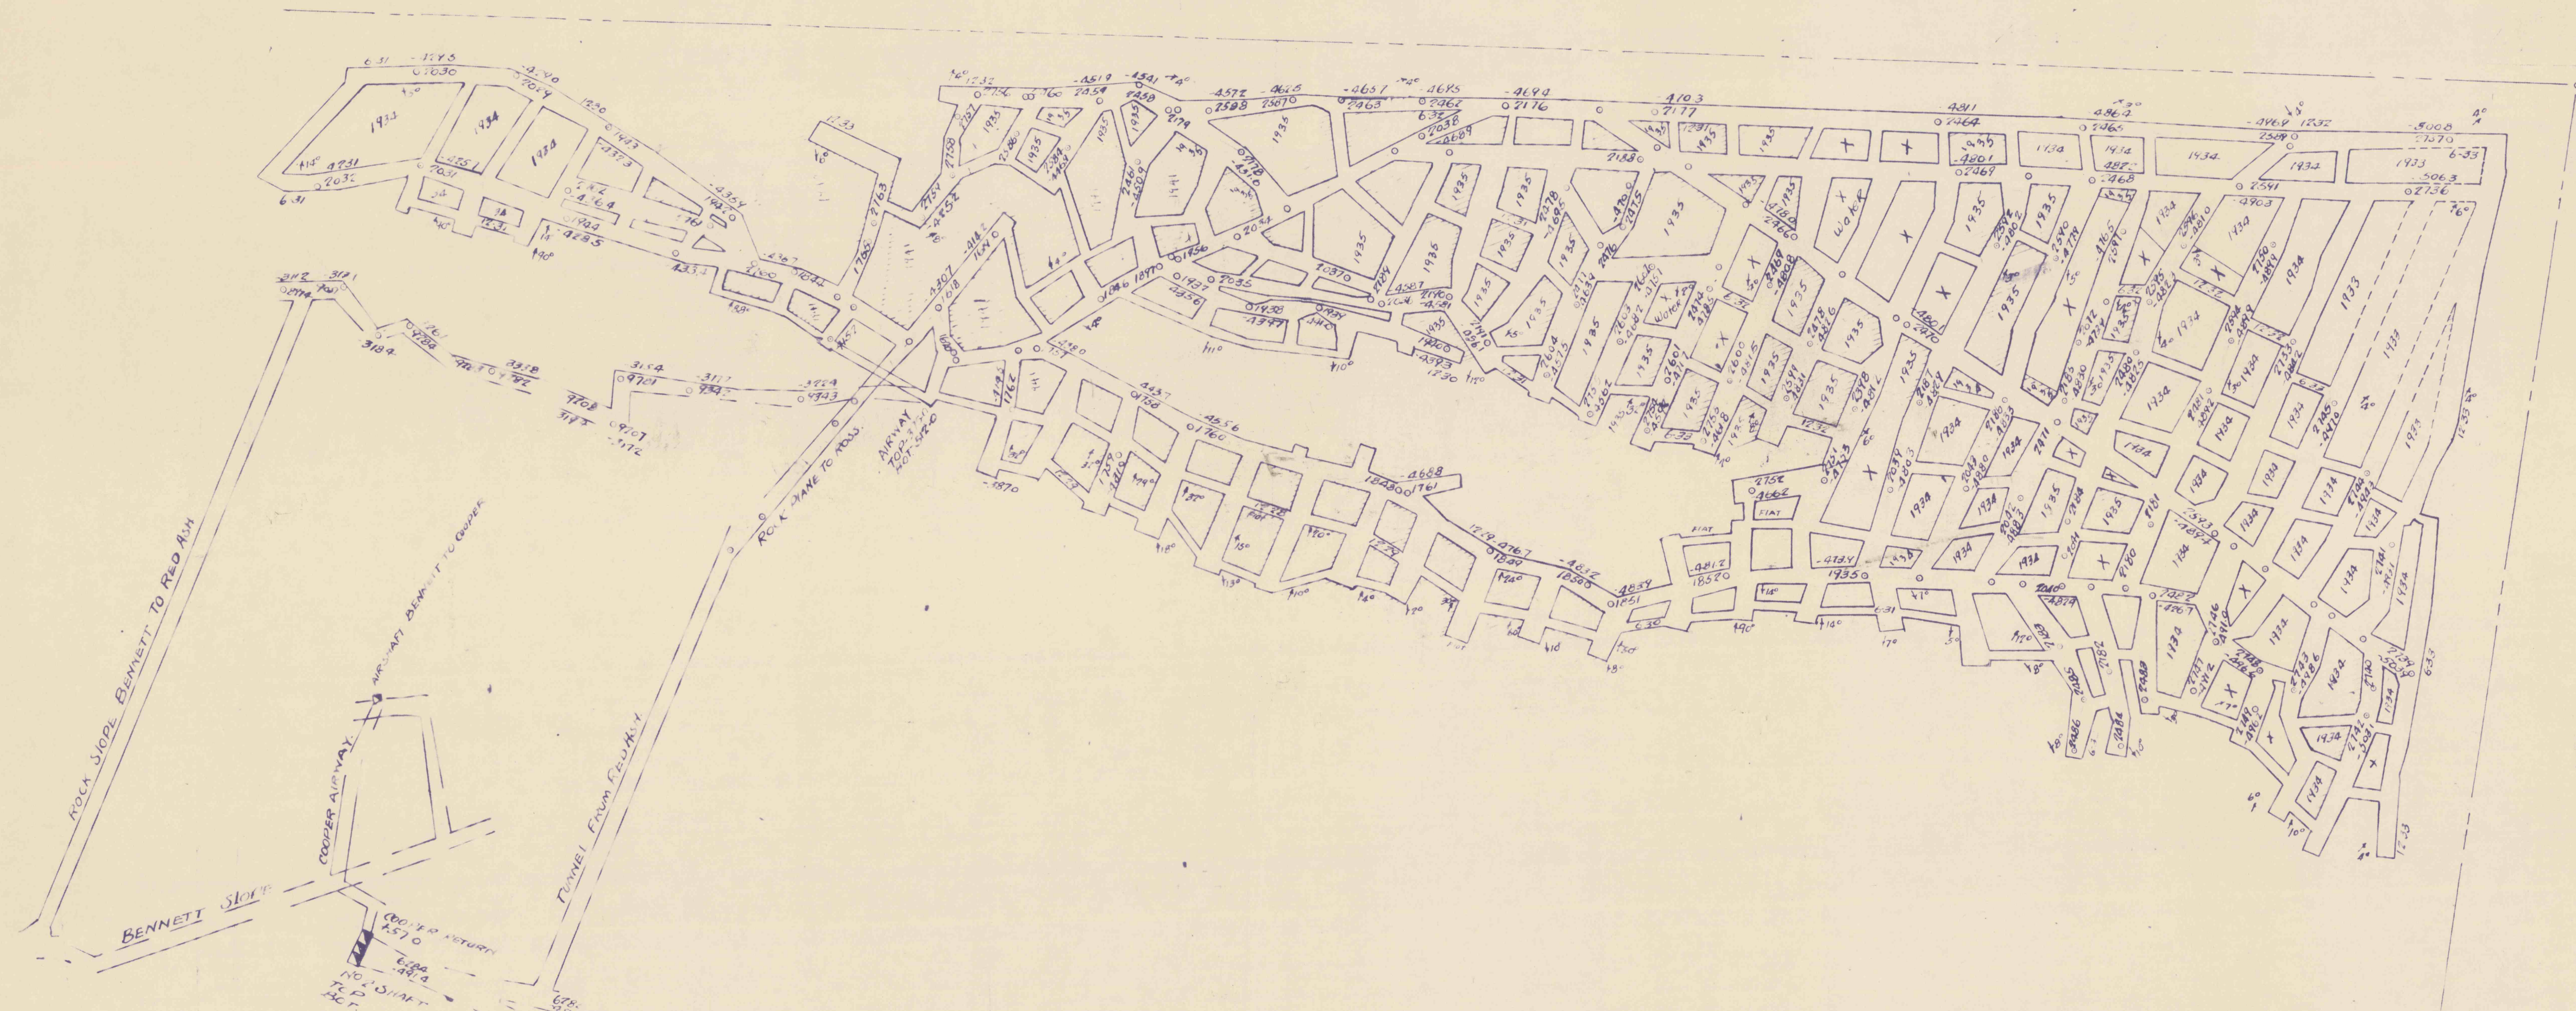

ALDEN
RED ASH UNDERLAP
H. Basin