


SUSQUEHANNA COAL CO.

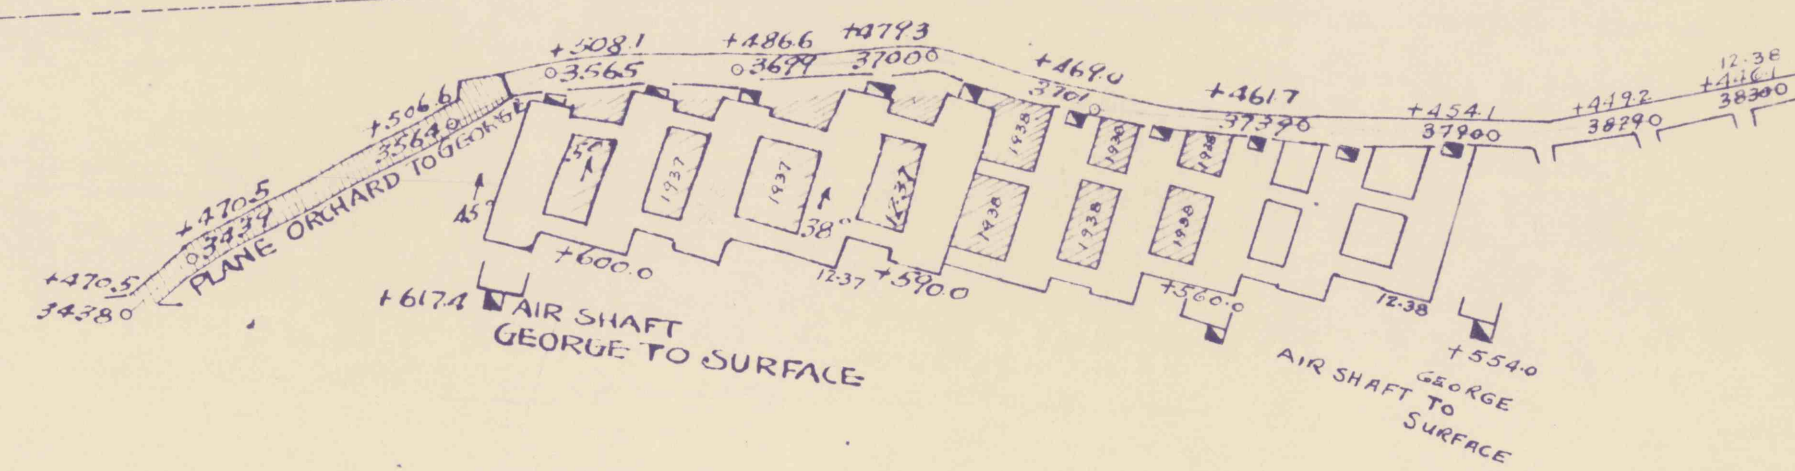

TOP GEORGE