


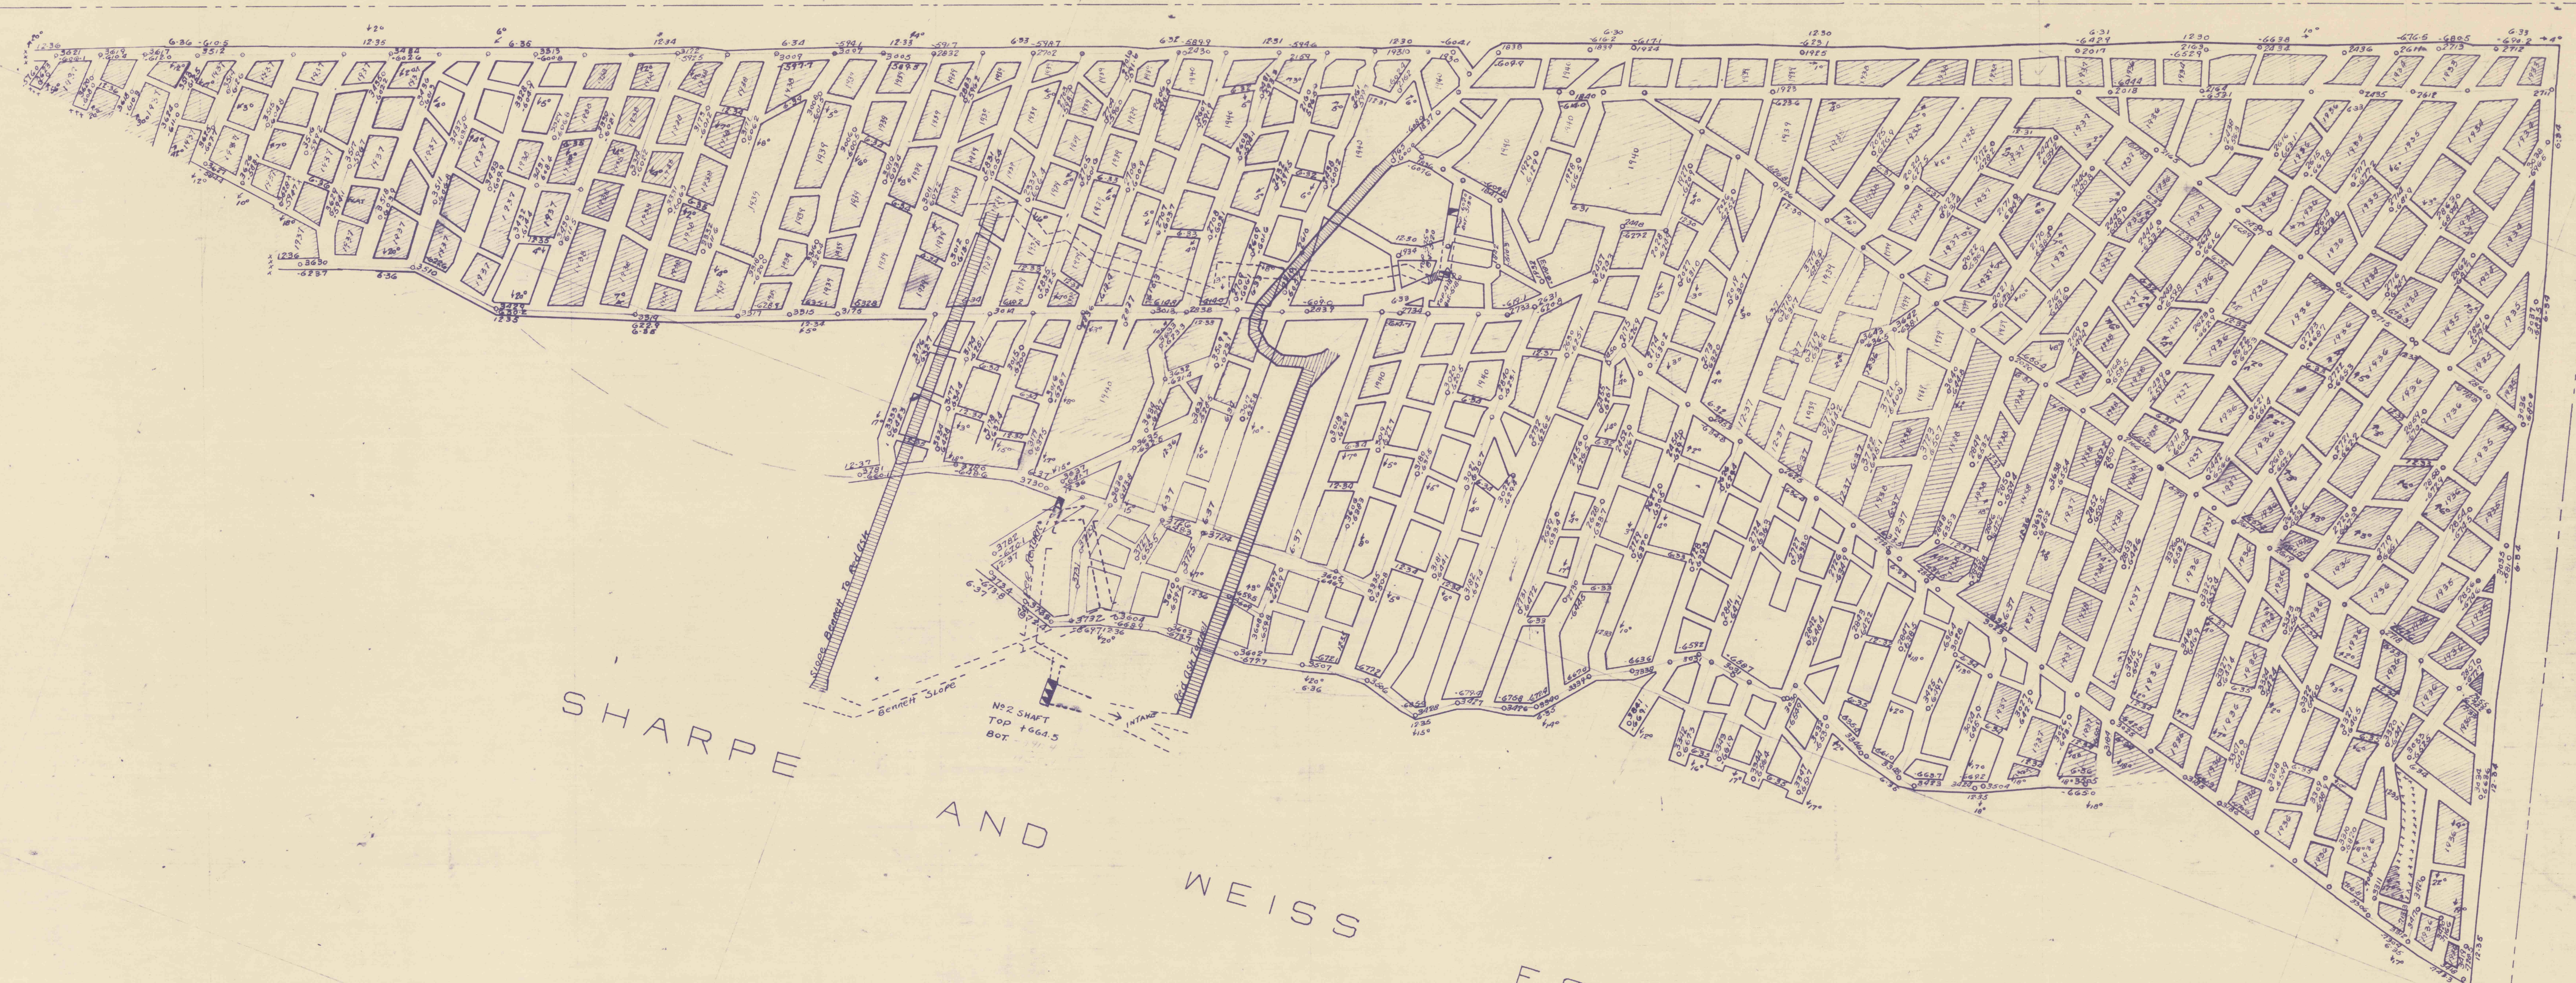

SHARPE
AND
WEISS
ESTATE