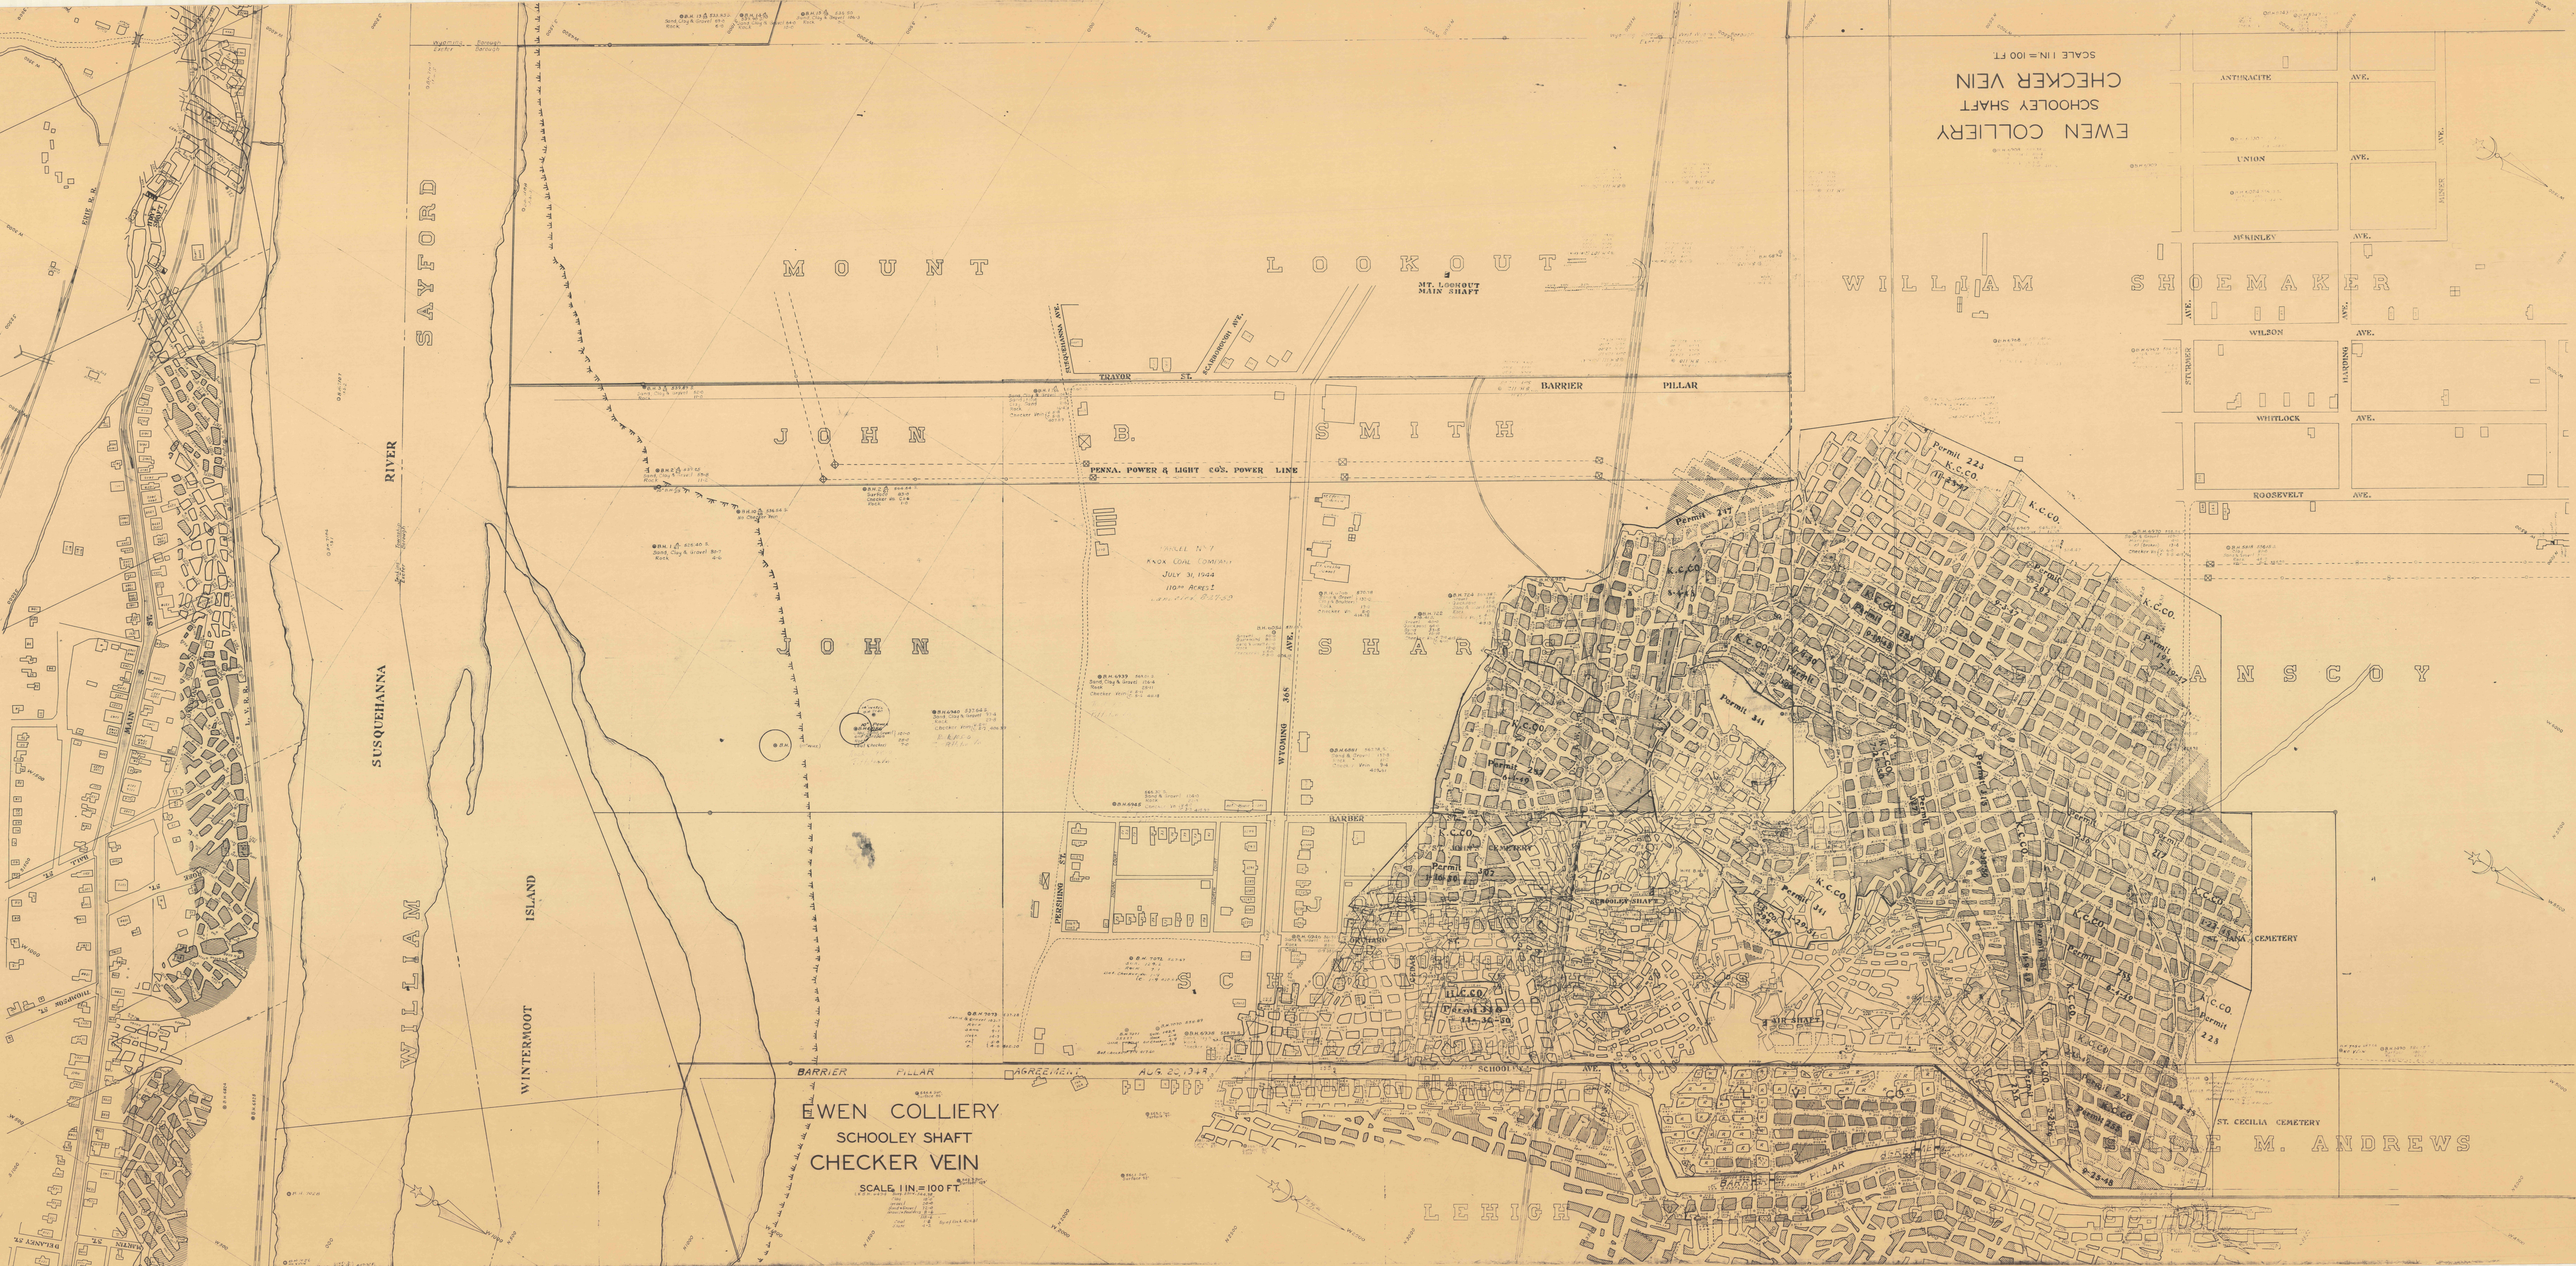

EWEN COLLIERY

SCHOOLEY SHAFT

CHECKER VEIN

SCALE 1 IN.= 100 FT.

EWEN COLLIERY
SCHOOLEY SHAFT
CHECKER VEIN
SCALE 1 IN.= 100 FT.
LEHIGH
M. ANDREWS
ST. CECILIA CEMETERY
BARRIER PILLAR
SCHOOLEY SHAFT
K.C.CO.
VANSCOY
SHARPS
JOHN
WYOMING AVE.
PERSHING ST.
ROOSEVELT AVE.
WHITLOCK AVE.
WILSON AVE.
HARDING AVE.
McKINLEY AVE.
UNION AVE.
ANTHRACITE AVE.
WILLIAM SHOEMAKER
PENNA. POWER & LIGHT CO'S. POWER LINE
JOHN B. SMITH
TRAVOR ST.
SUSQUEHANNA AVE.
MT. LOOKOUT MAIN SHAFT
MOUNT LOOKOUT
WINTERMOOT ISLAND
WILLIAM SAYFORD
SUSQUEHANNA RIVER
MAIN ST.
THOMPSON ST.
DELANEY ST.
L.V.R.R.
ERIE R.R.