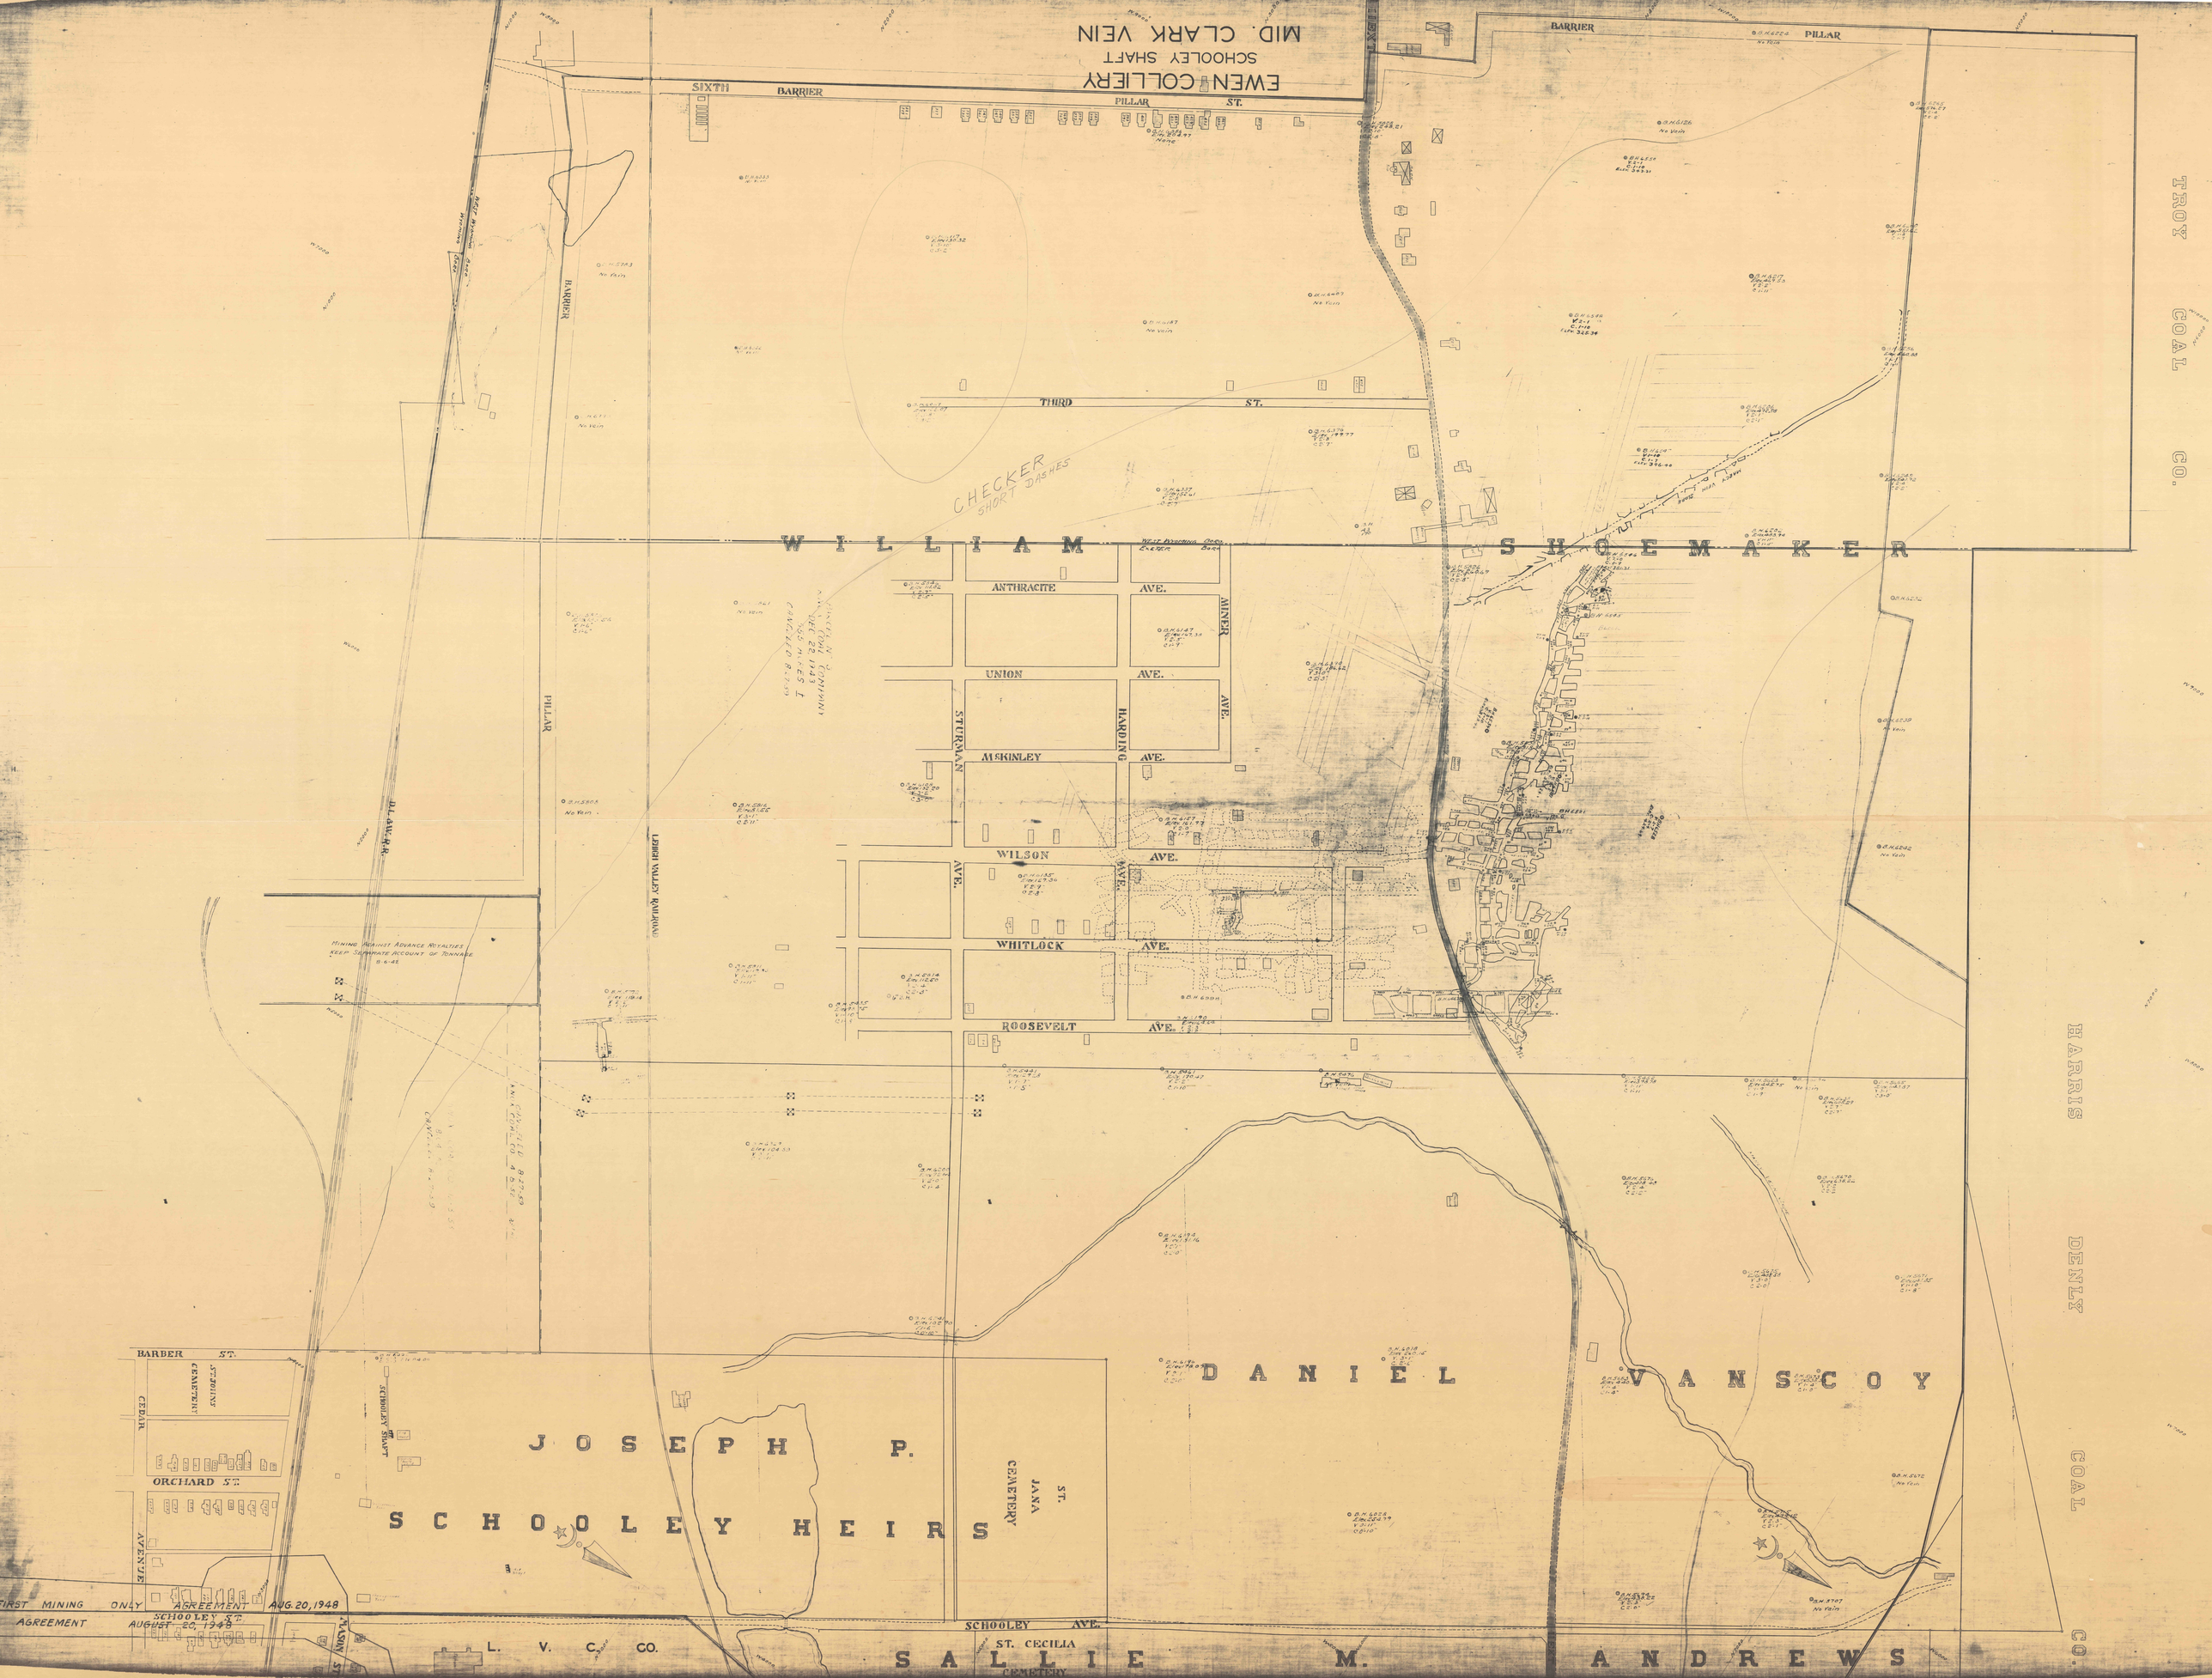
EWEN COLLIERY
SCHOOLEY SHAFT
MID. CLARK VEIN
SIXTH
BARRIER
PILLAR
ST.
THIRD
ST.
CHECKER
SHORT DASHES
W I L L I A M
S H O E M A K E R
ANTHRACITE
AVE.
UNION
AVE.
MINER
AVE.
STURMAN
AVE.
HARDING
AVE.
McKINLEY
AVE.
WILSON
AVE.
WHITLOCK
AVE.
ROOSEVELT
AVE.
PILLAR
BARRIER
D.L.&W.R.R.
DELAWARE VALLEY RAILROAD
MINING AGAINST ADVANCE ROYALTIES
KEEP SEPARATE ACCOUNT OF TONNAGE
BARBER ST.
CEDAR
CEMETERY
STORIES
ORCHARD ST.
AVENUE
SCHOOLEY AVENUE
J O S E P H P.
S C H O O L E Y H E I R S
ST. JANA CEMETERY
D A N I E L V A N S C O Y
FIRST MINING ONLY AGREEMENT AUG. 20, 1948
AGREEMENT SCHOOLEY ST. AUGUST 20, 1948
SCHOOLEY AVE.
L. V. C. CO.
ST. CECILIA CEMETERY
S A L L I E M. A N D R E W S
TROY COAL CO.
HARRIS
DENLY
COAL CO.