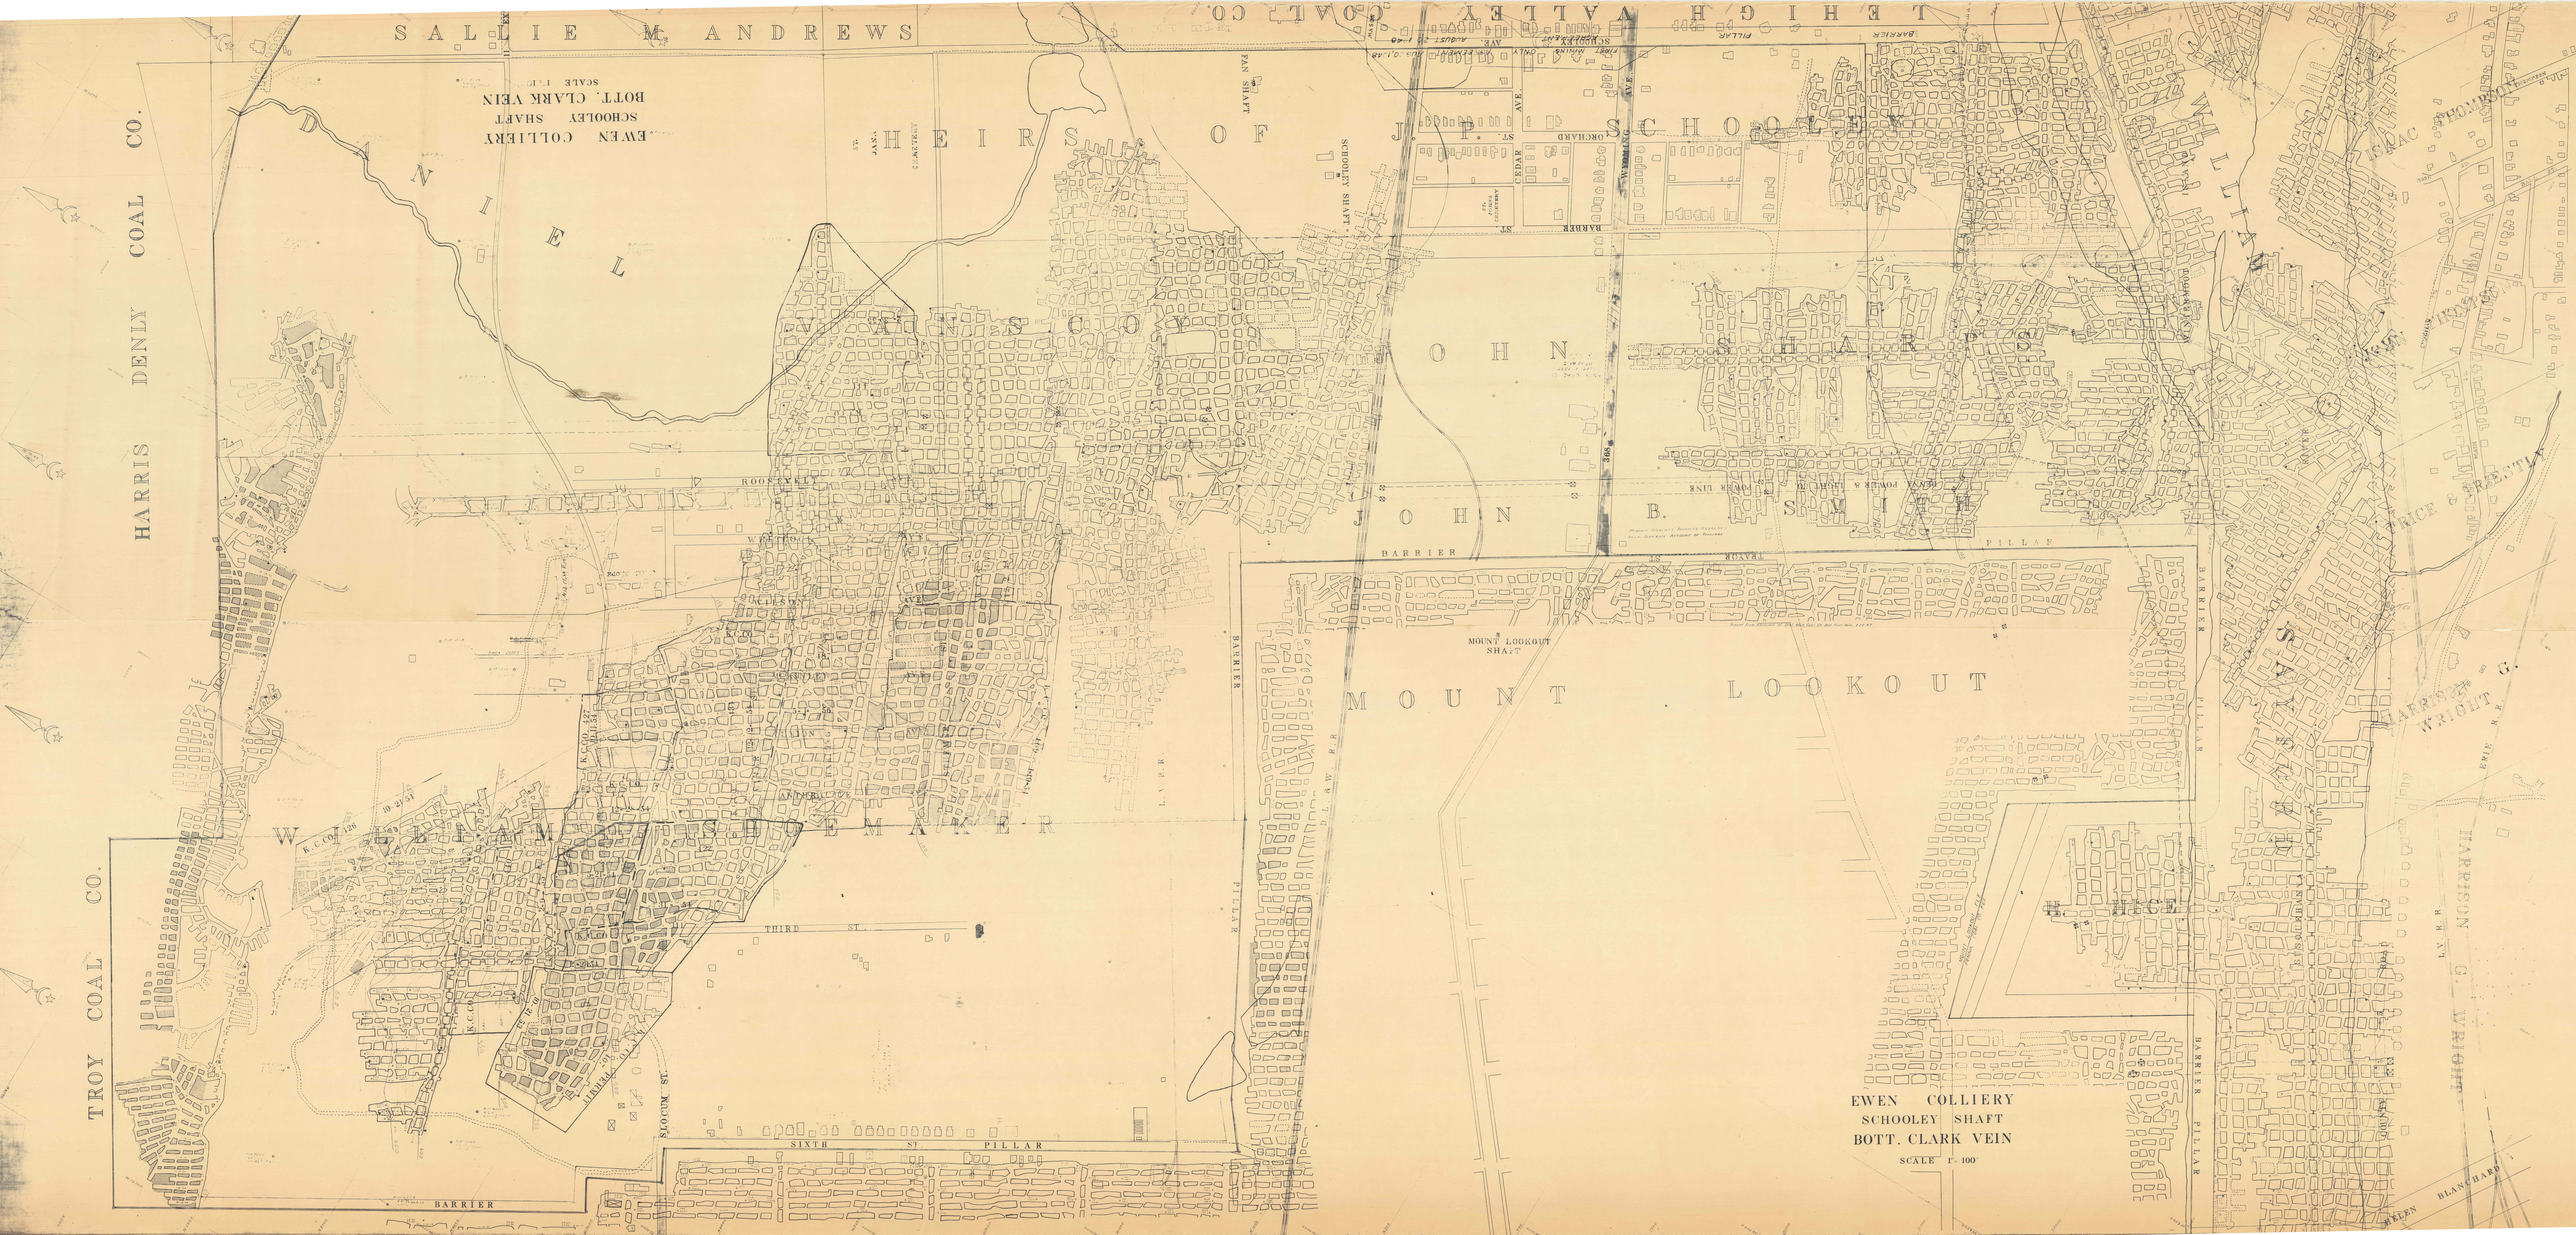
SALLIE M. ANDREWS
TEHIGH VALLEY COAL CO.
HARRIS DENLY COAL CO.
TROY COAL CO.
DANIEL
HEIRS OF
JOHN
JOHN B. SMITH
WILLIAM
MOUNT LOOKOUT
MOUNT LOOKOUT SHAFT
WILLIAM METTLESHEMAKER
ROOSEVELT
WASHINGTON
THIRD ST.
SIXTH ST
PILLAR
BARRIER
EWEN COLLIERY
SCHOOLEY SHAFT
BOTT. CLARK VEIN
SCALE 1"-100'
HARRISON G. WRIGHT
ISAAC THOMPSON
PRICE & REESIDE
ERIE R.R.
L.V.R.R.