


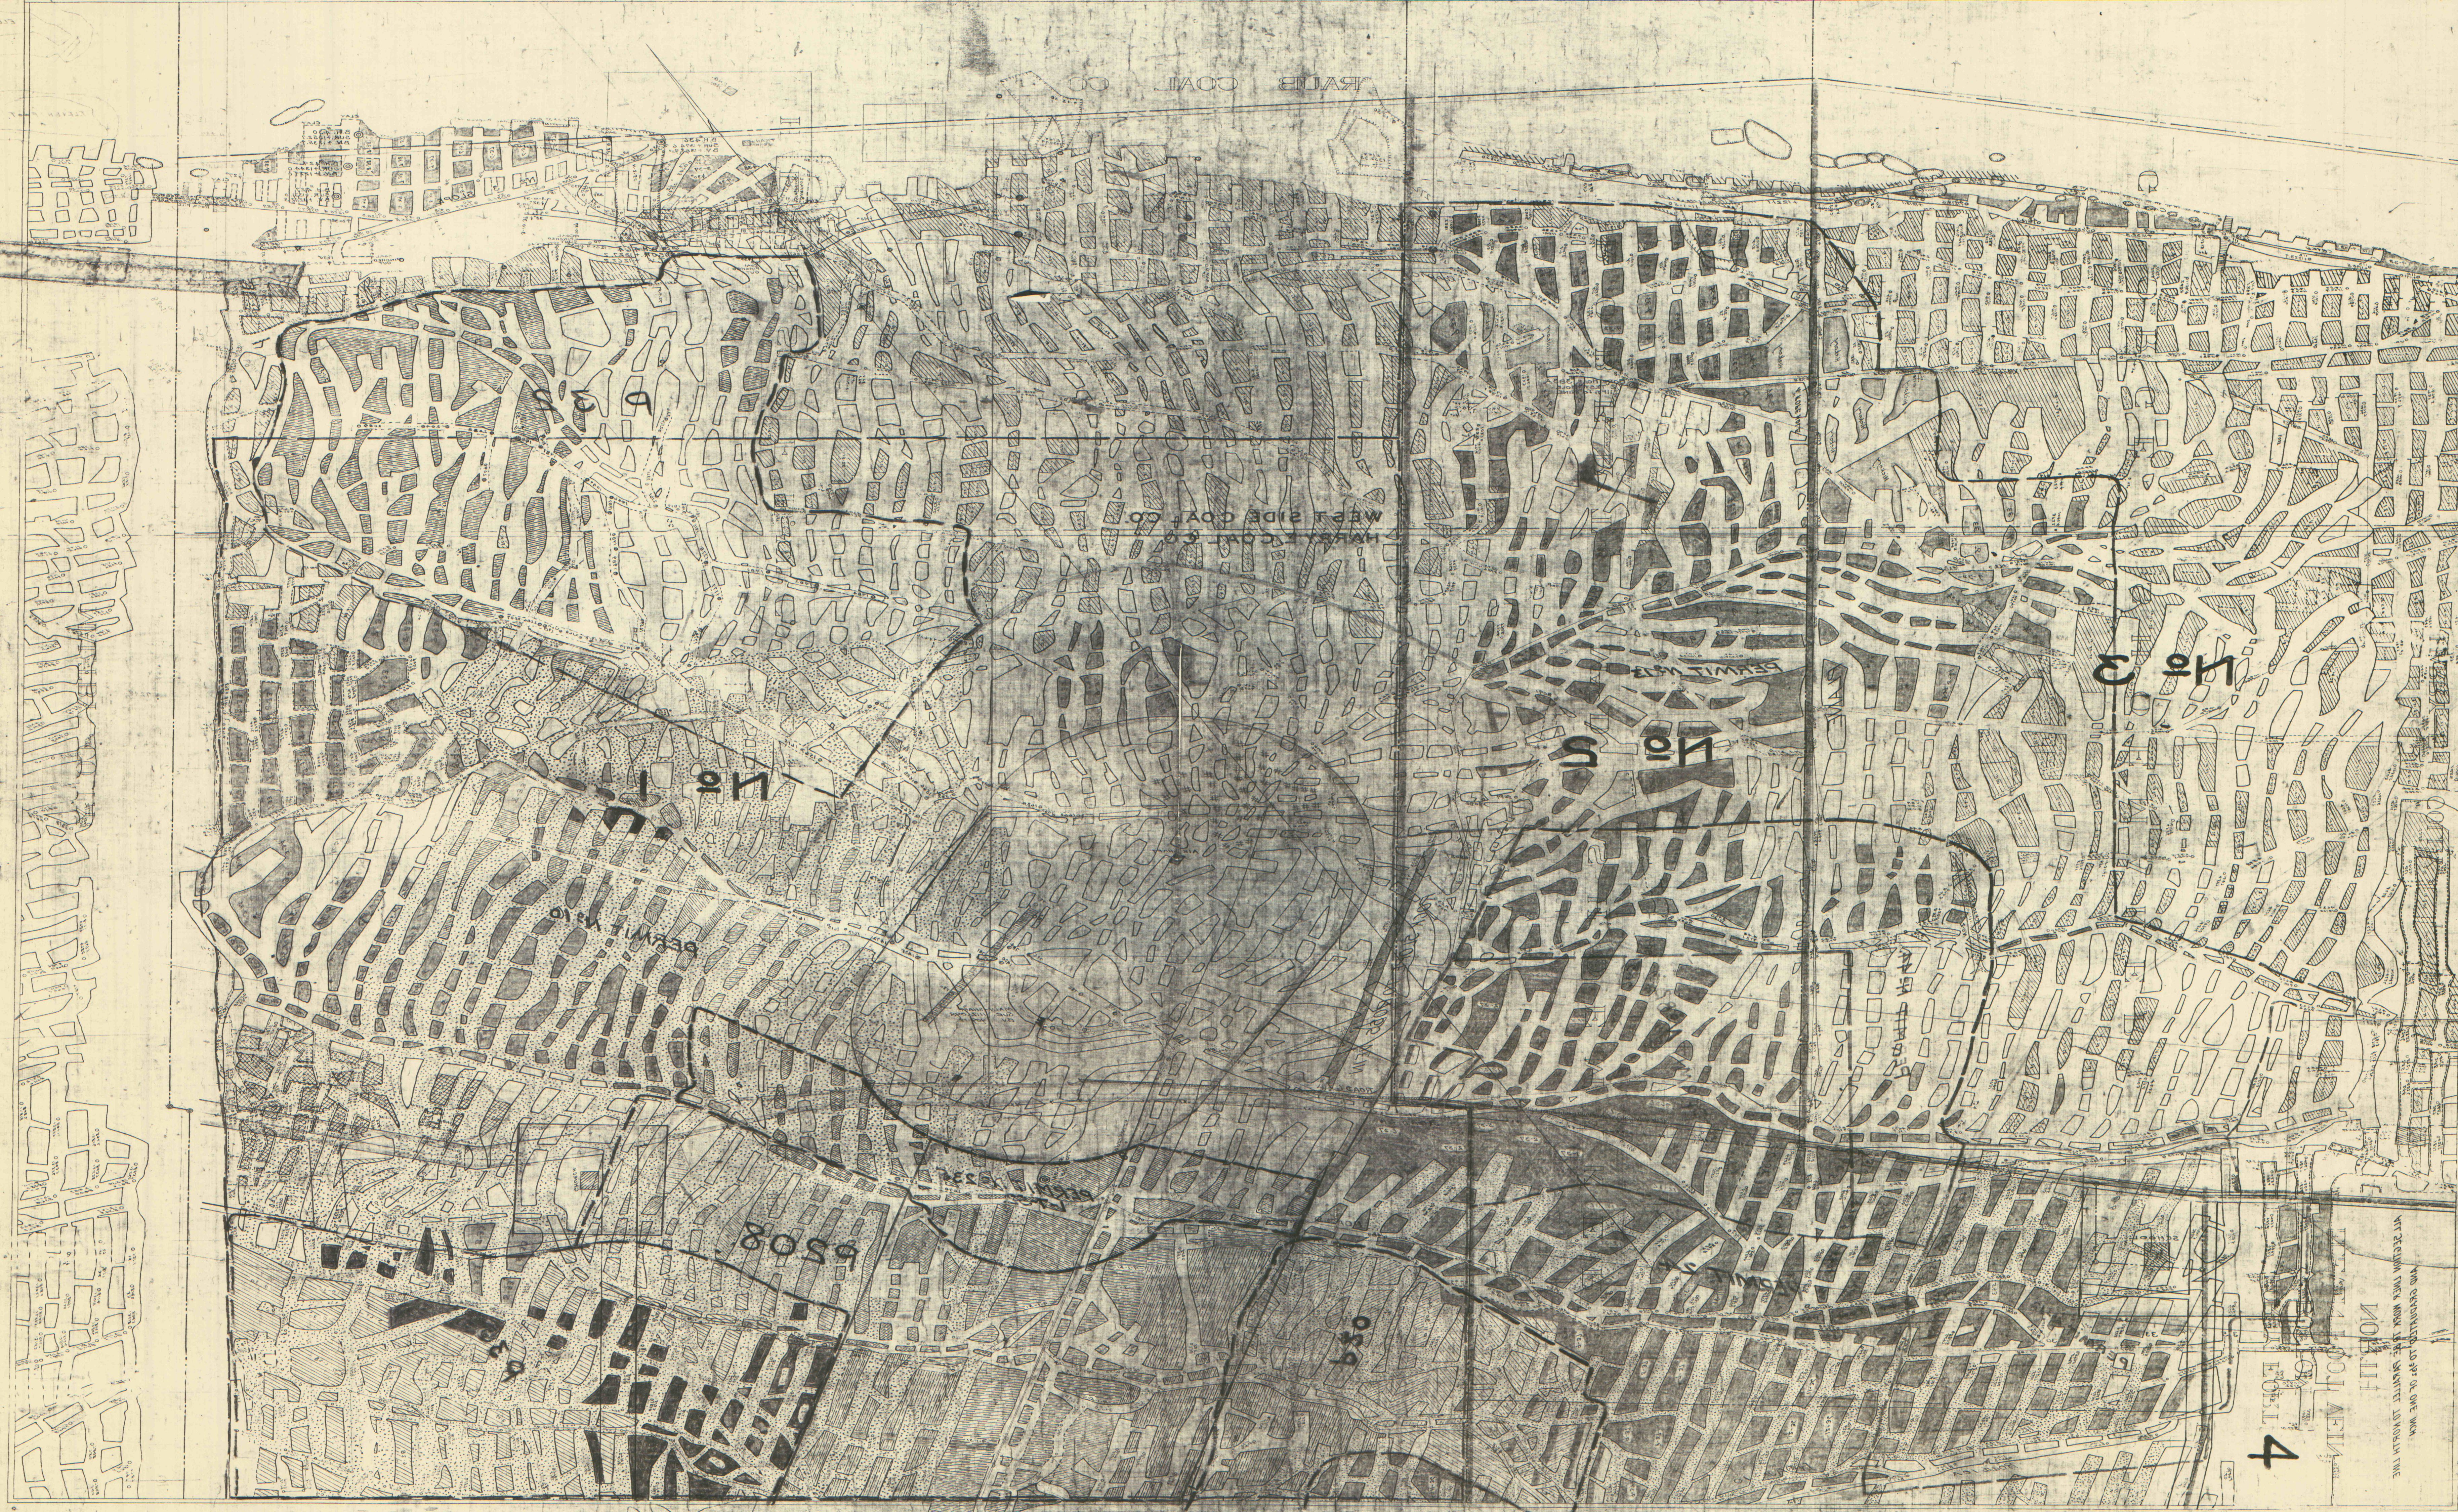

FOOT 4

NO. 11

