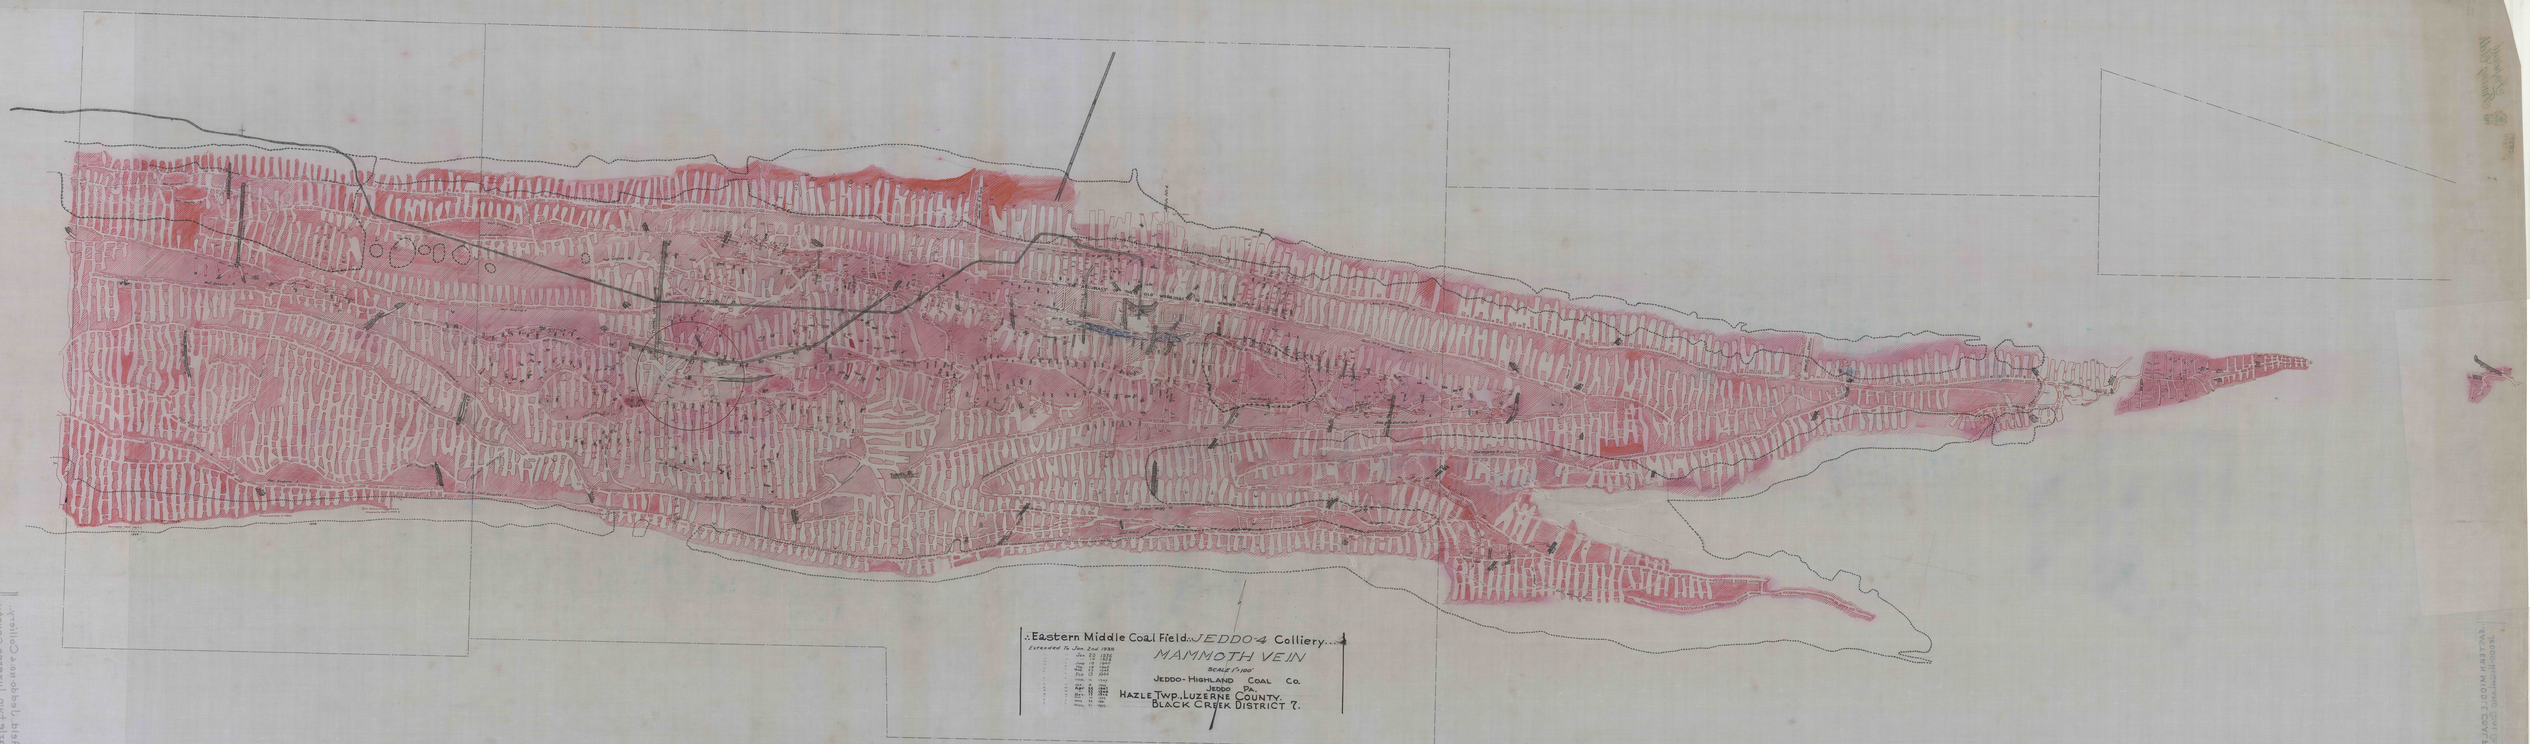

Eastern Middle Coal Field.
JEDDO 4 Colliery.
Extended To Jan. 2nd 1935
MAMMOTH VEIN
SCALE 1"=100'
JEDDO-HIGHLAND COAL CO.
JEDDO PA.
HAZLE TWP., LUZERNE COUNTY.
BLACK CREEK DISTRICT 7.