


Principal Basins	Surface acres	Area collected	Area stripped	Area submerged
Eckley No. 1 Basin	87 acres	13 acres	29 acres	25 acres
Eckley No. 2 Basin	177 "	8 "		17 "
Eckley No. 3 Basin	211 "	12 "		76 "
Eckley No. 5 Basin	268 "	13 "	7 "	191 "
Total Eckley	743 acres	46 acres	36 acres	309 acres
Buck No. 1 Basin	67 acres		10 acres	16 acres
Buck No. 2 Basin	195 "			35 "
Total Buck No.	511 acres	14 acres	16 acres	97 acres

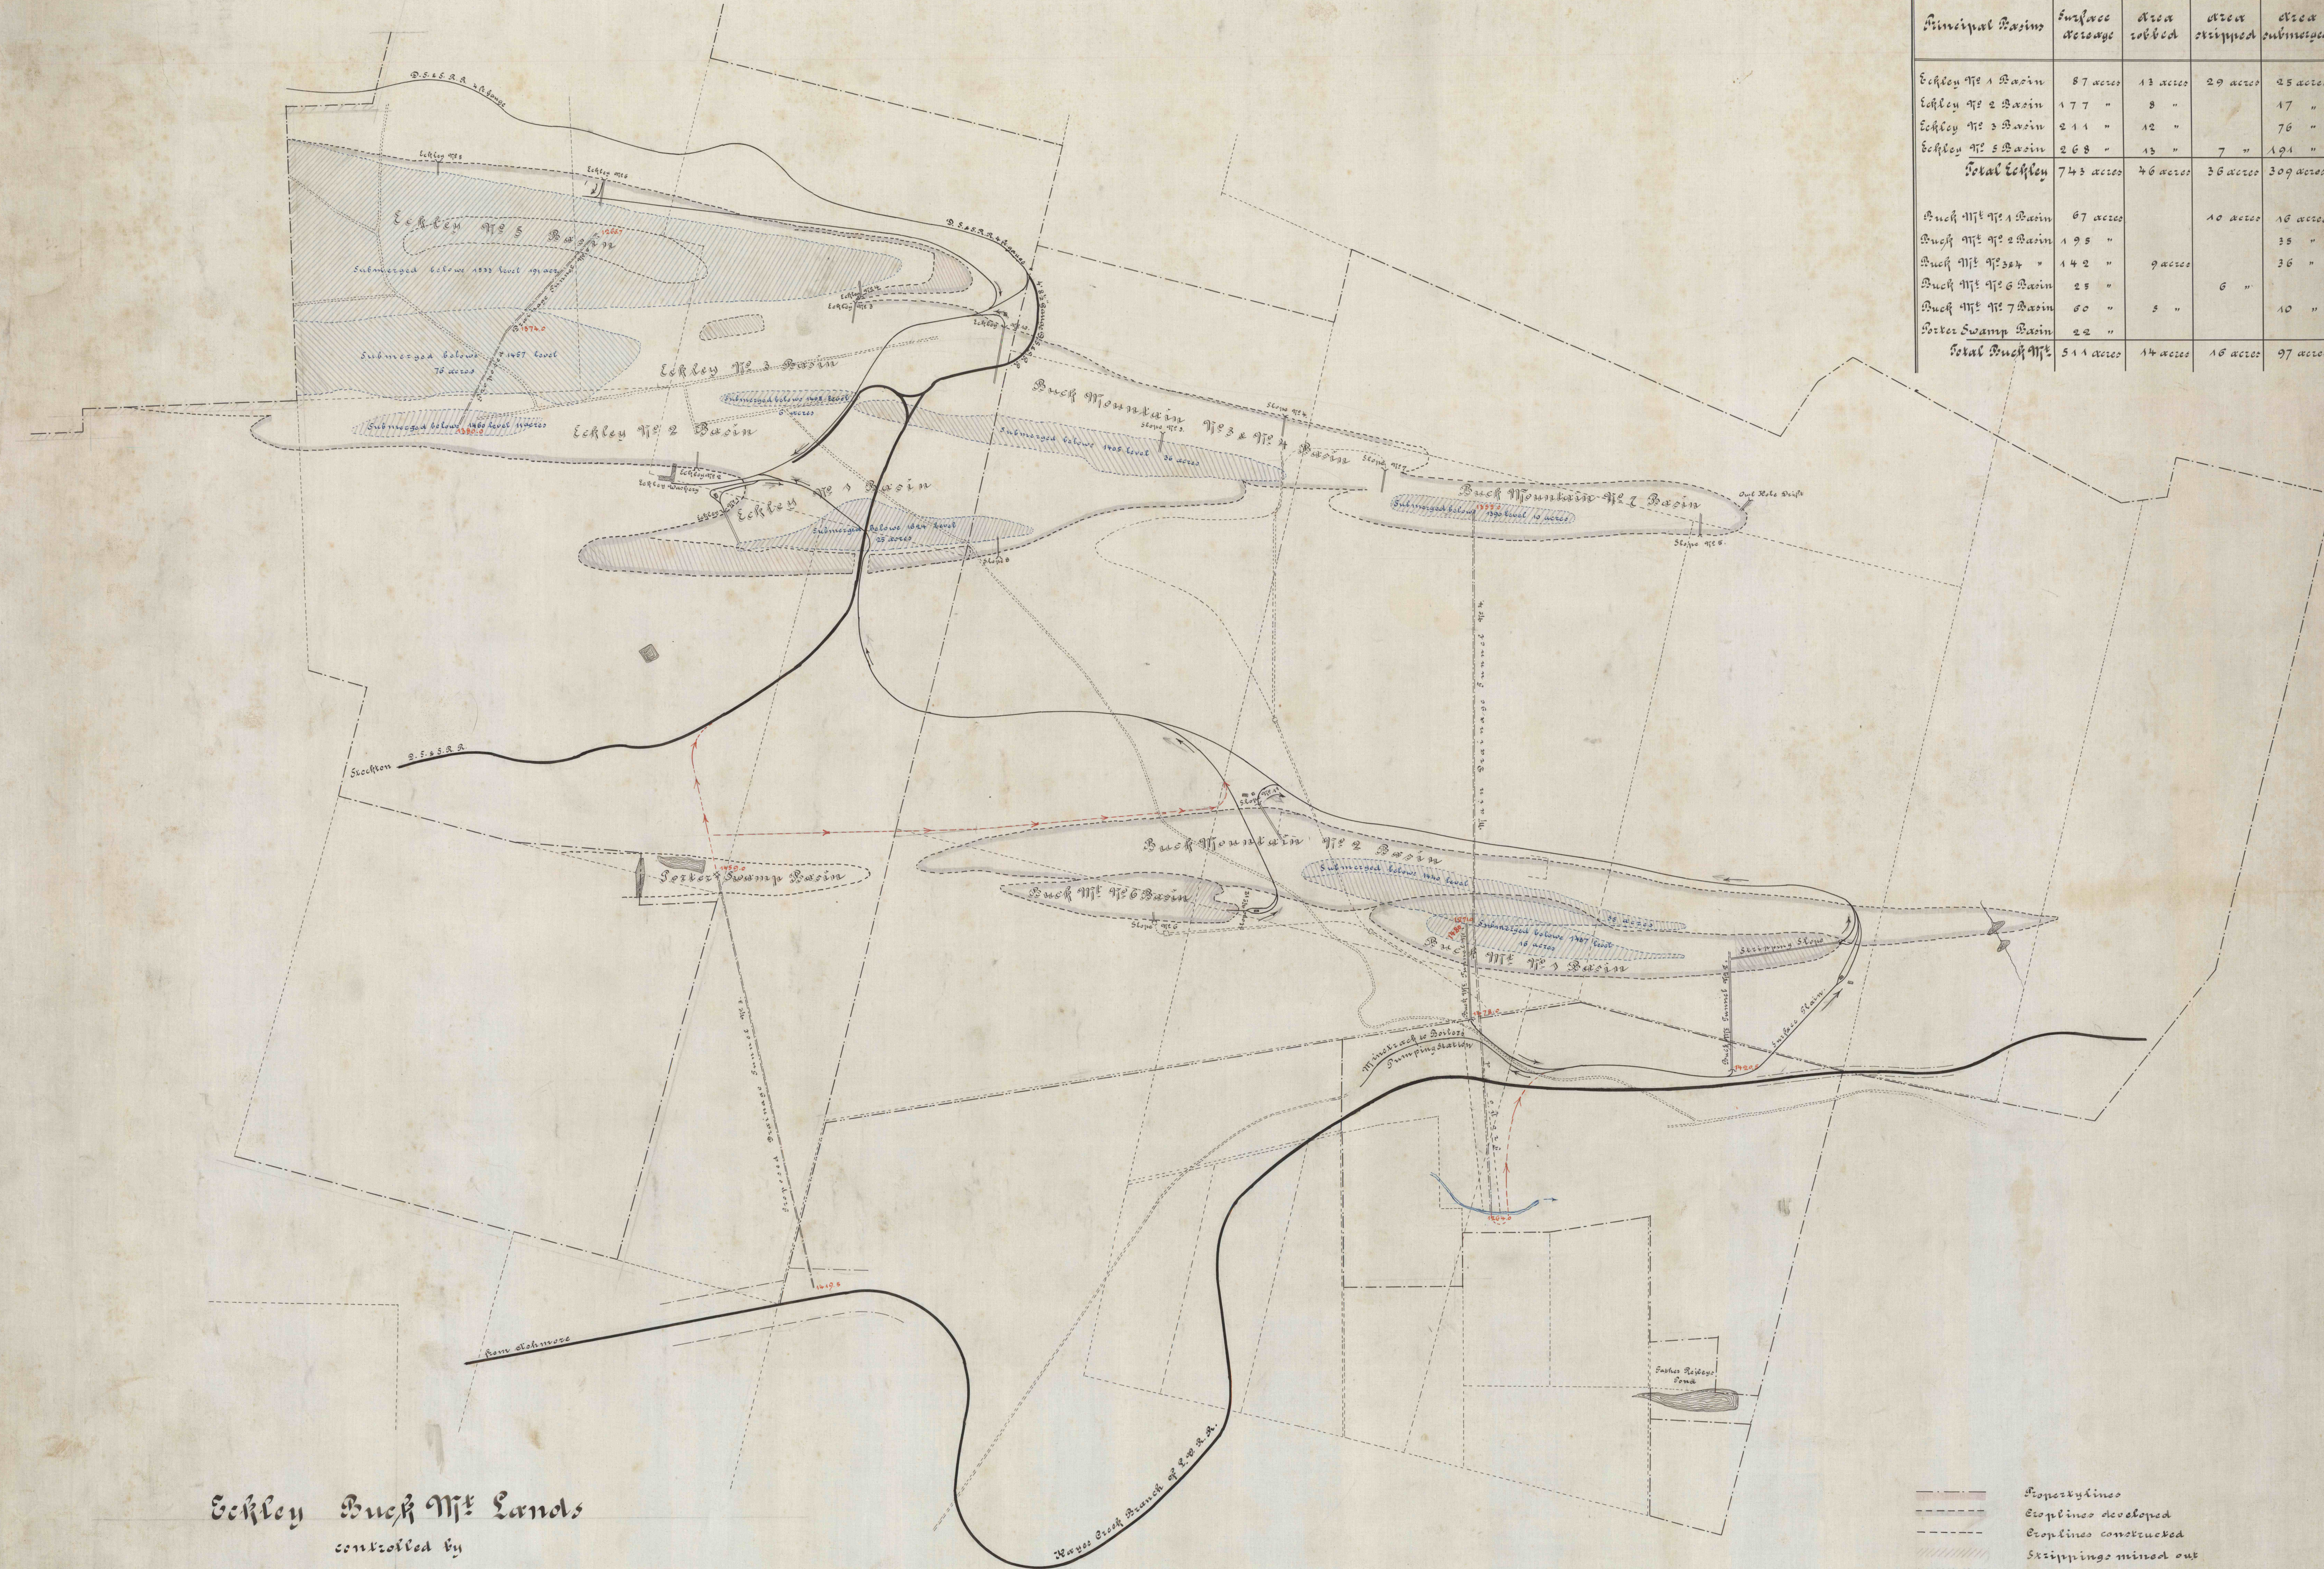

Eckley Buck Mt. Lands
 controlled by
 Cox Brothers & Co. Inc.
 showing
 General conditions of Coal Basins
 and
 Transportation Lines.
 Scale: 1" = 800 ft.

- Property lines
- /// Strippings mined out
- ▨ Areas submerged
- 4' 8 1/2" gauge tracks
- 4' gauge tracks
- Movement of loaded cars
- additional tracks