



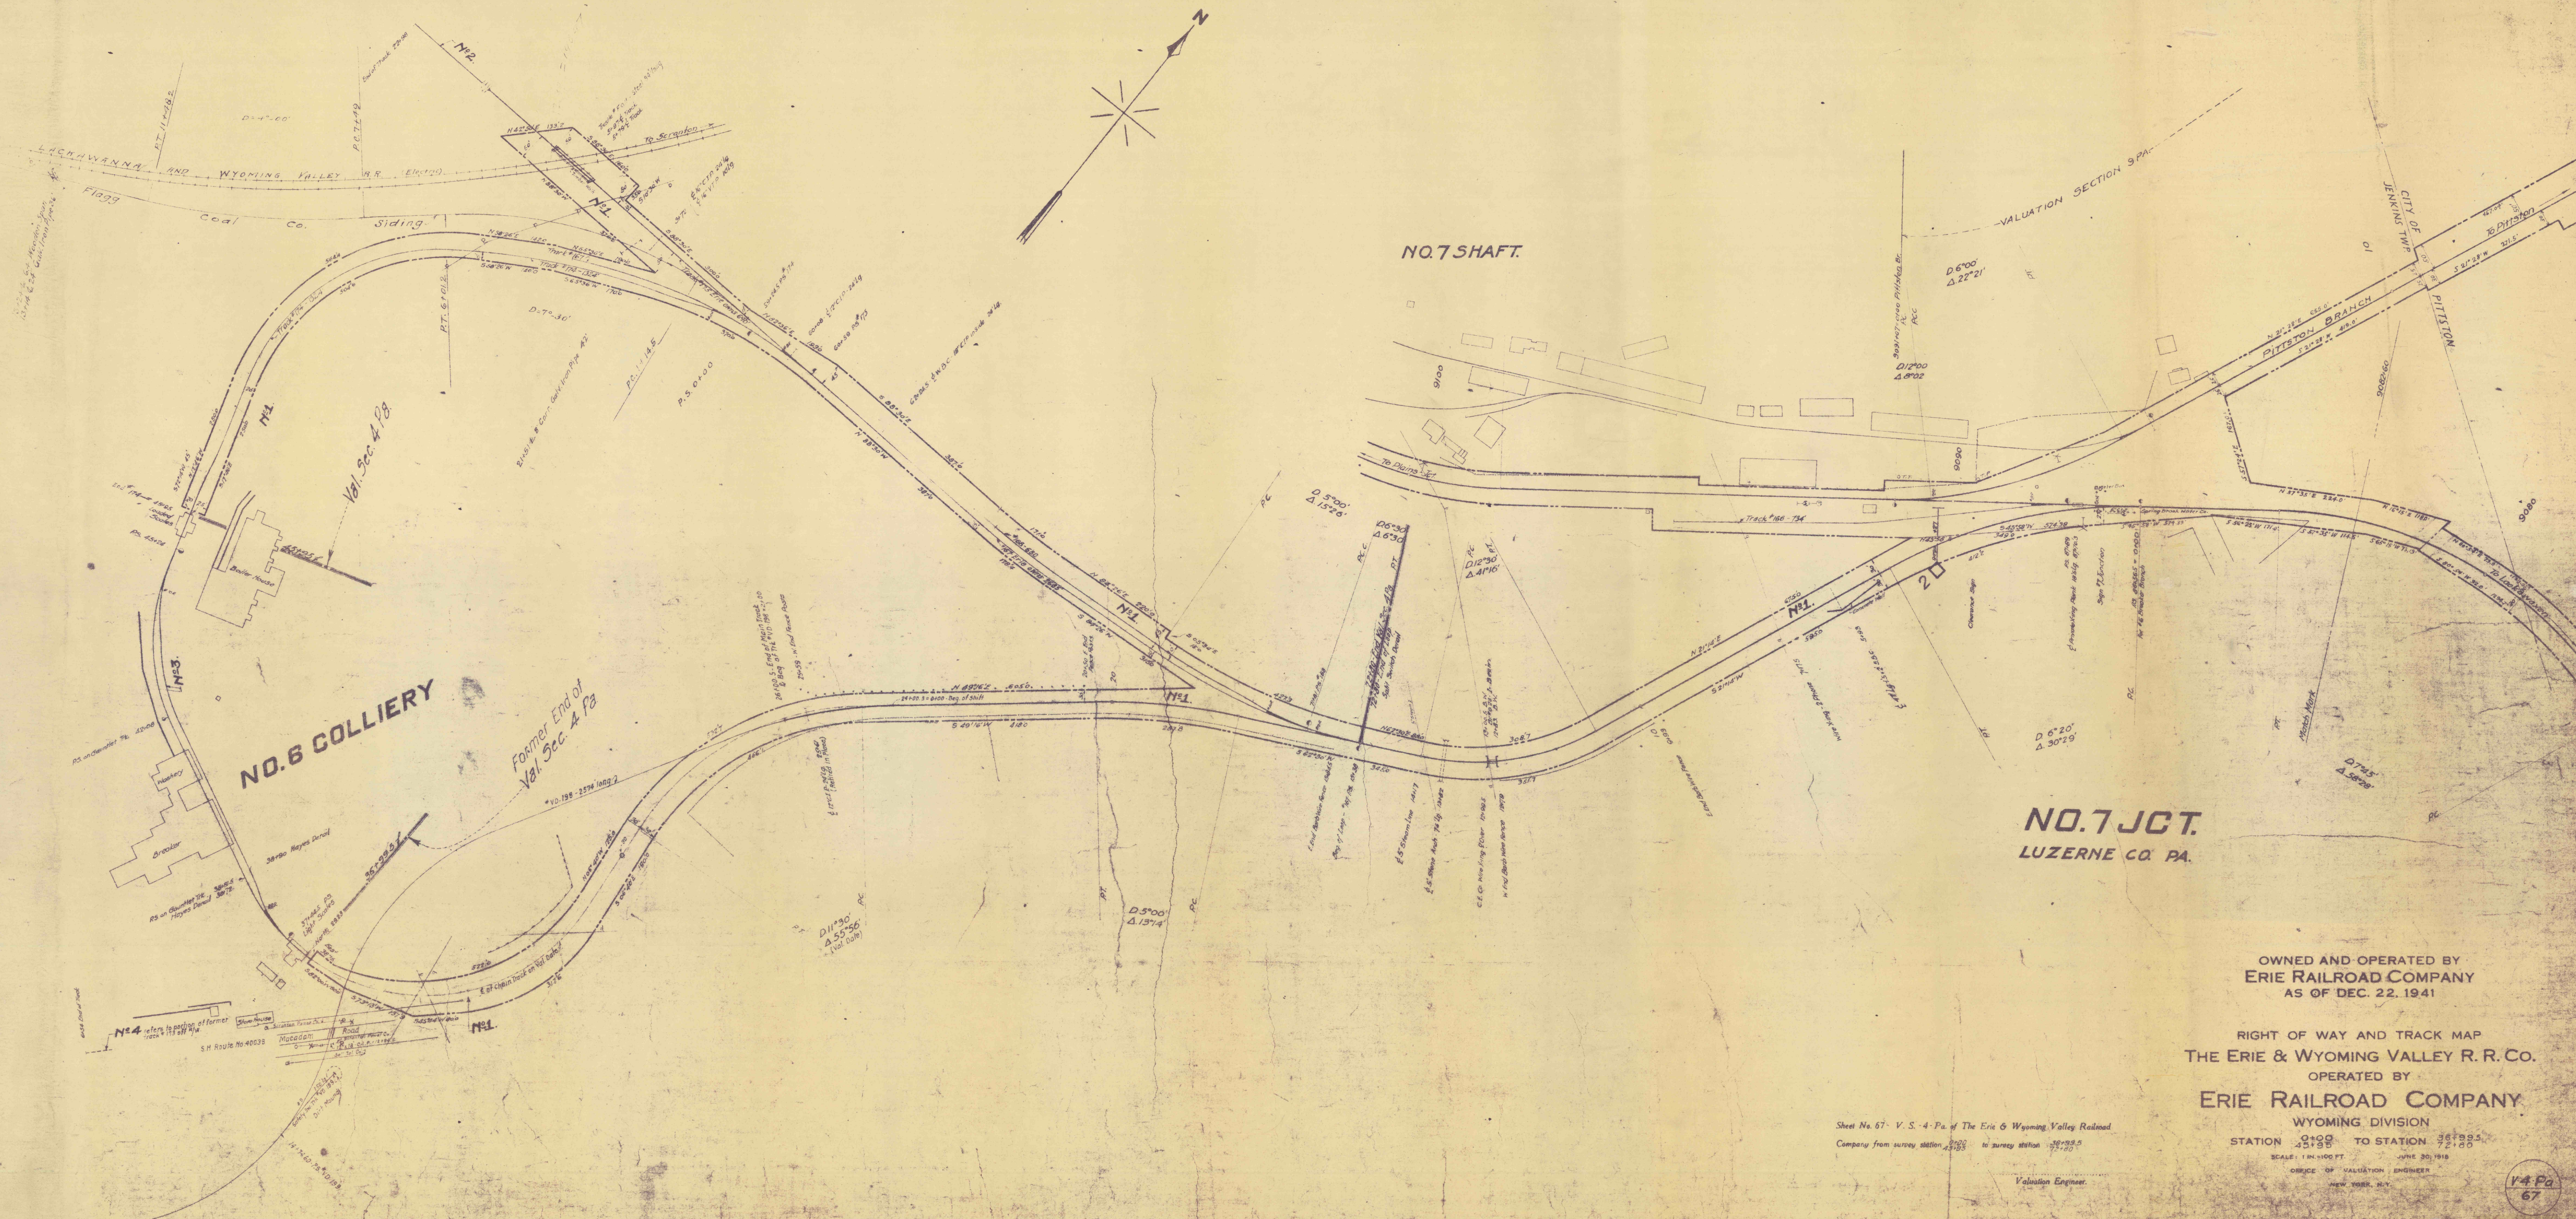

OWNED AND OPERATED BY
ERIE RAILROAD COMPANY
AS OF DEC. 22, 1941

RIGHT OF WAY AND TRACK MAP
THE ERIE & WYOMING VALLEY R. R. Co.
OPERATED BY
ERIE RAILROAD COMPANY
WYOMING DIVISION

Sheet No. 67- V. S. - 4 - Pa. of The Erie & Wyoming Valley Railroad
Company from survey station $\frac{9700}{4995}$ to survey station $\frac{36+99.5}{771.80}$

STATION 9+00 TO STATION 36+99.5
45+95 72+80
SCALE: 1 IN.=100 FT. JUNE 30, 1918
OFFICE OF VALUATION ENGINEER
NEW YORK, N.Y.

V-4-Pa
67