


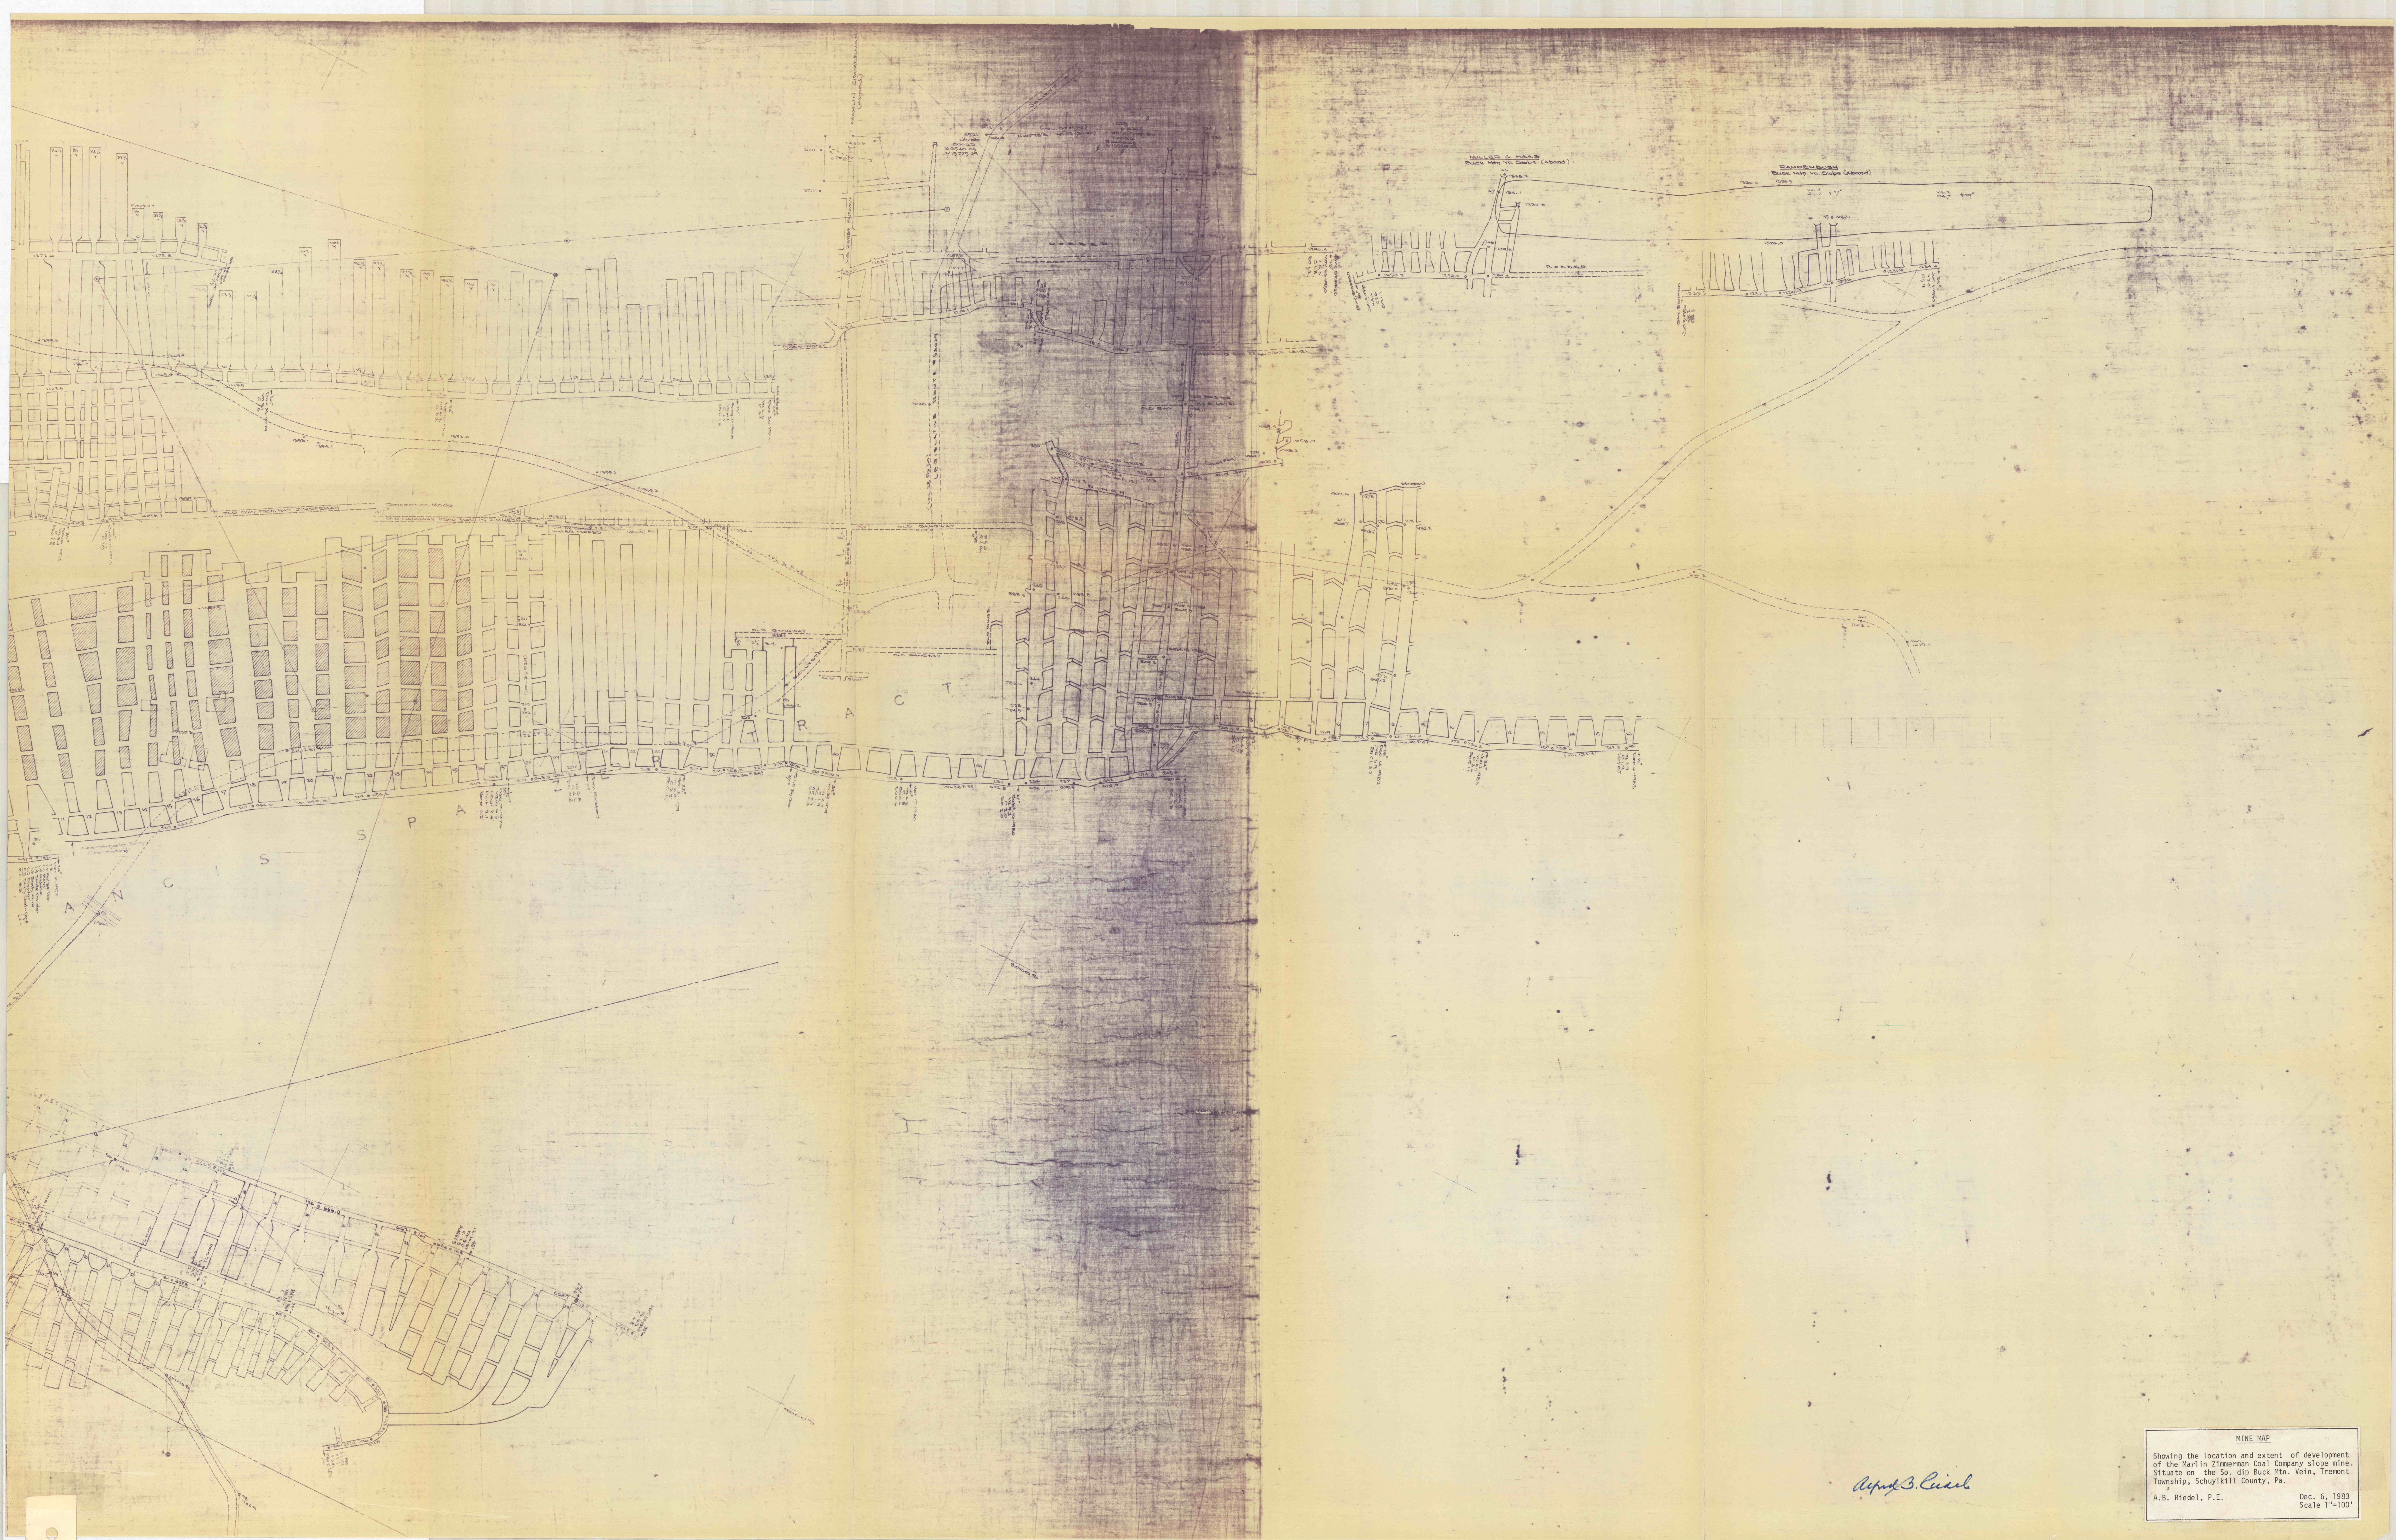


MINE MAP
Showing the location and extent of development
of the Marlin Zimmerman Coal Company slope mine.
Situate on the So. dip Buck Mtn. Vein, Tremont
Township, Schuylkill County, Pa.
Scale 1"=100'