



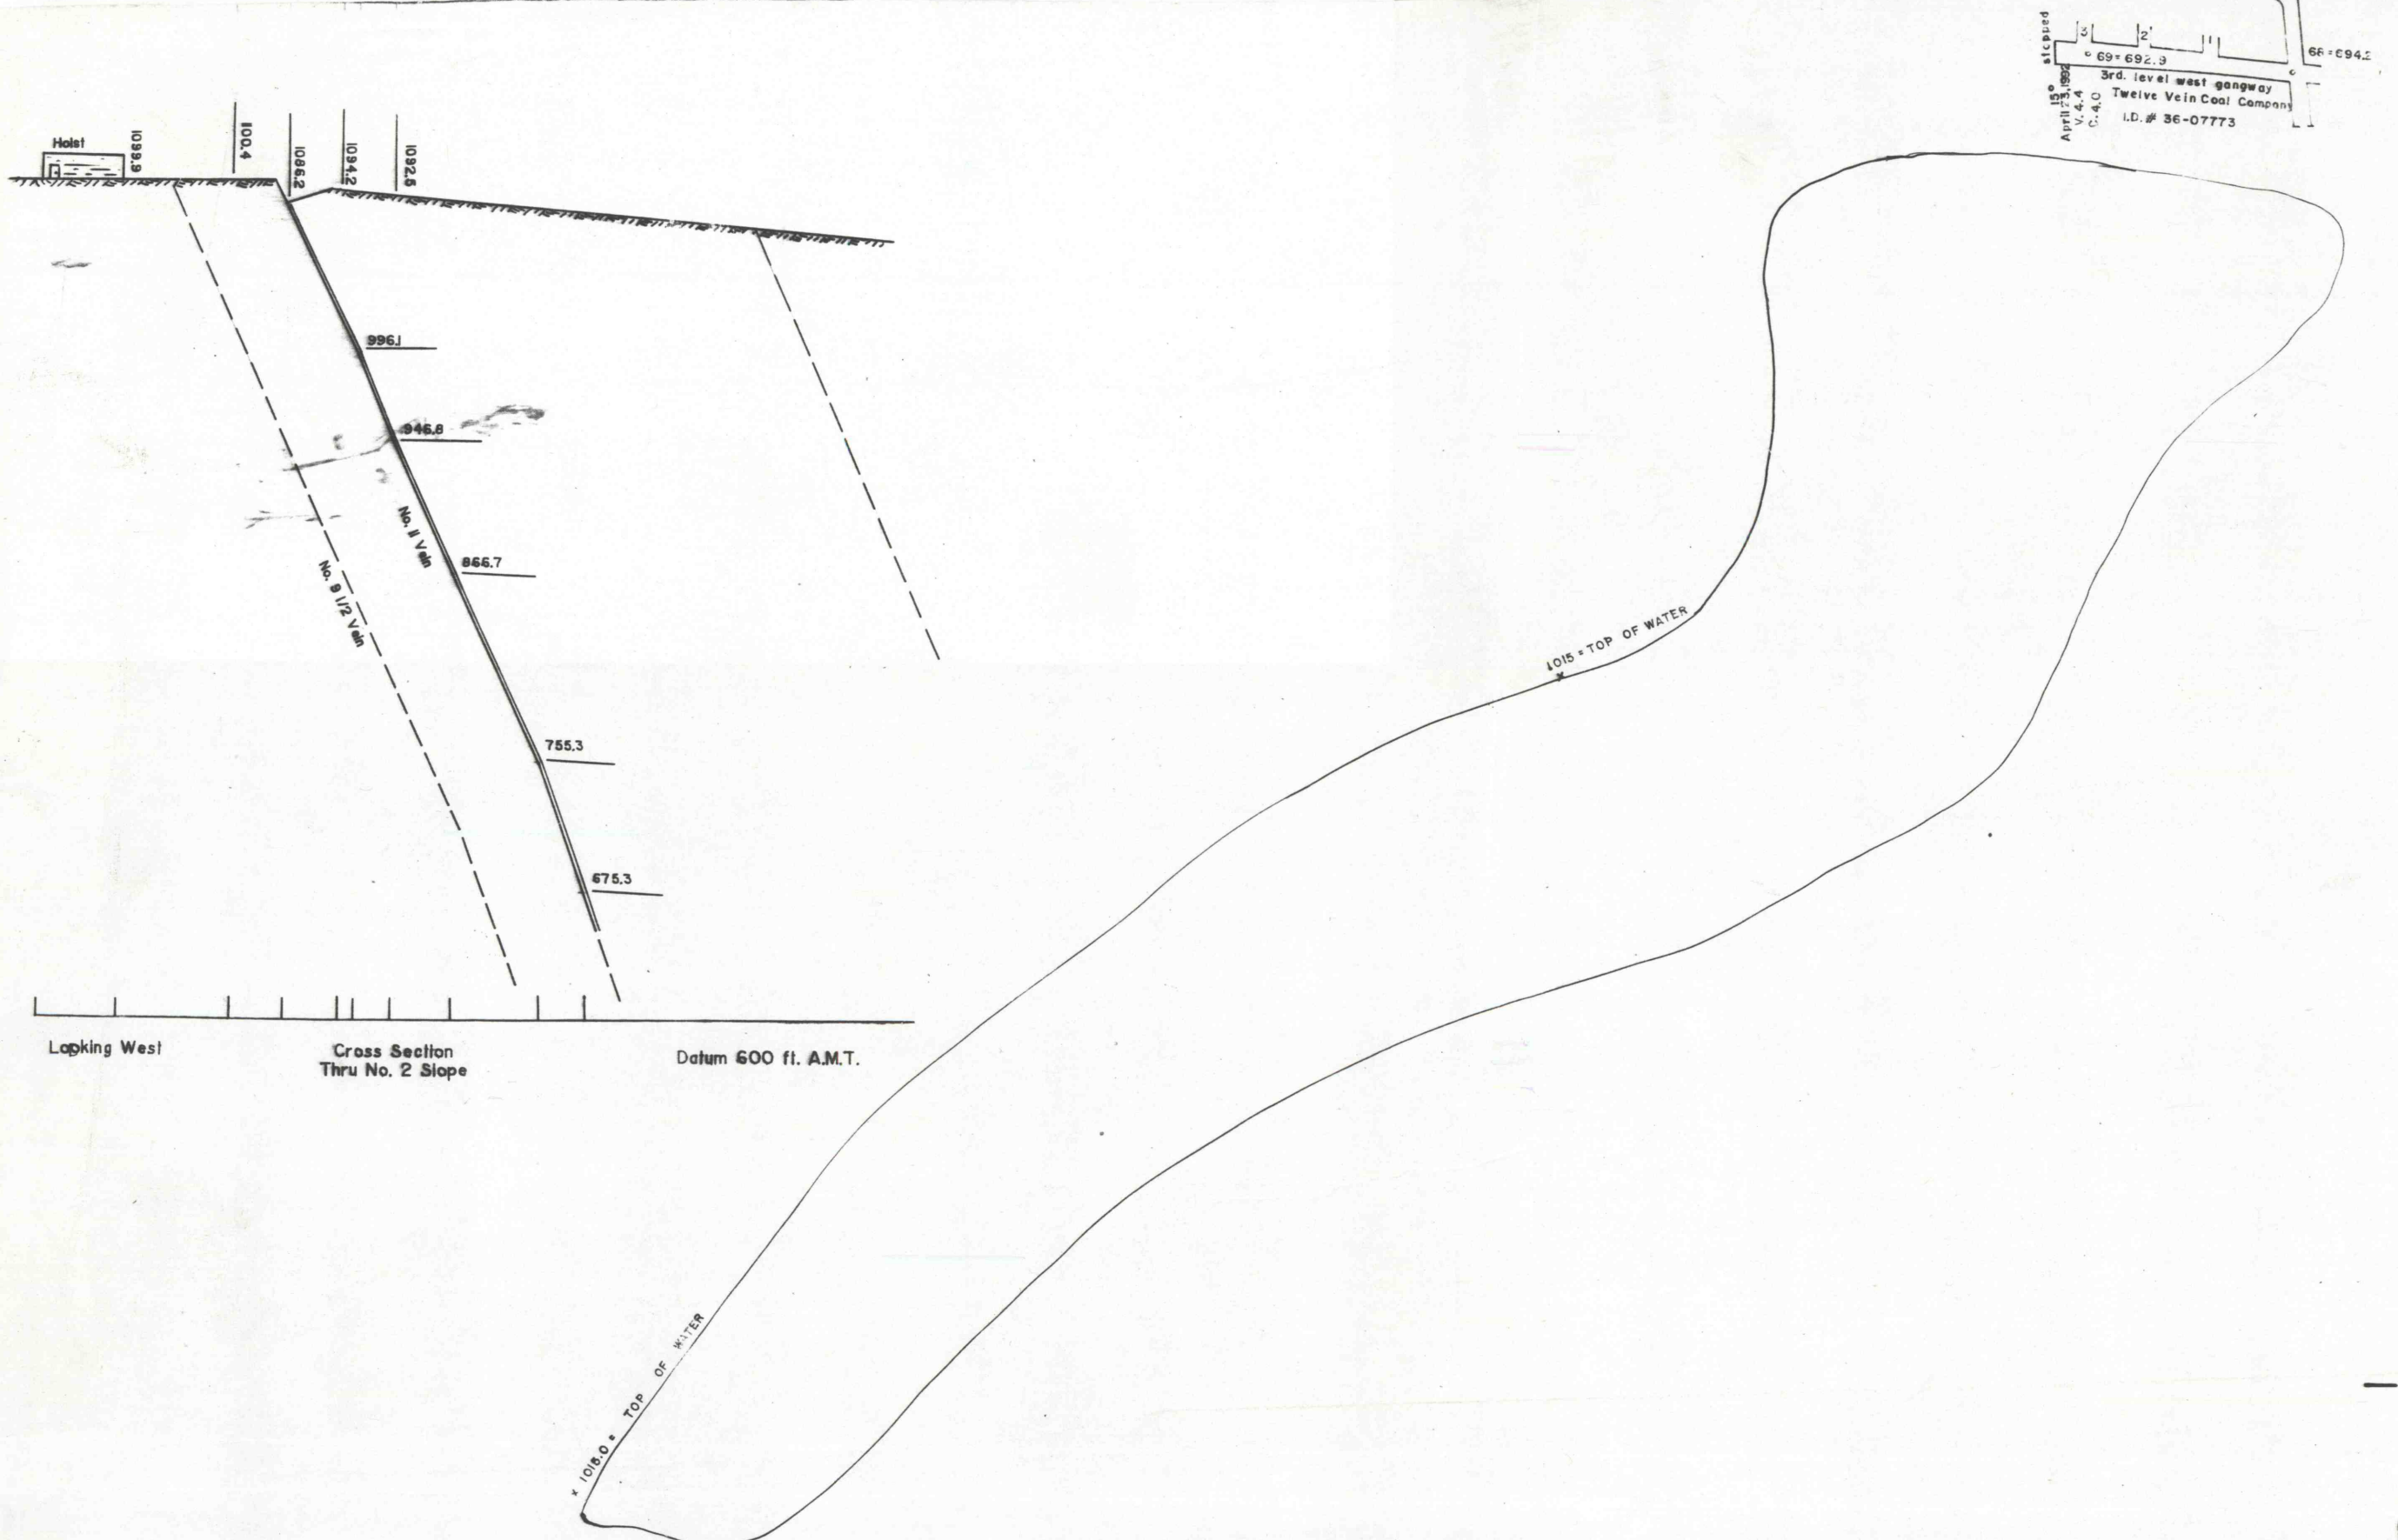

PETER MAURER TRACT

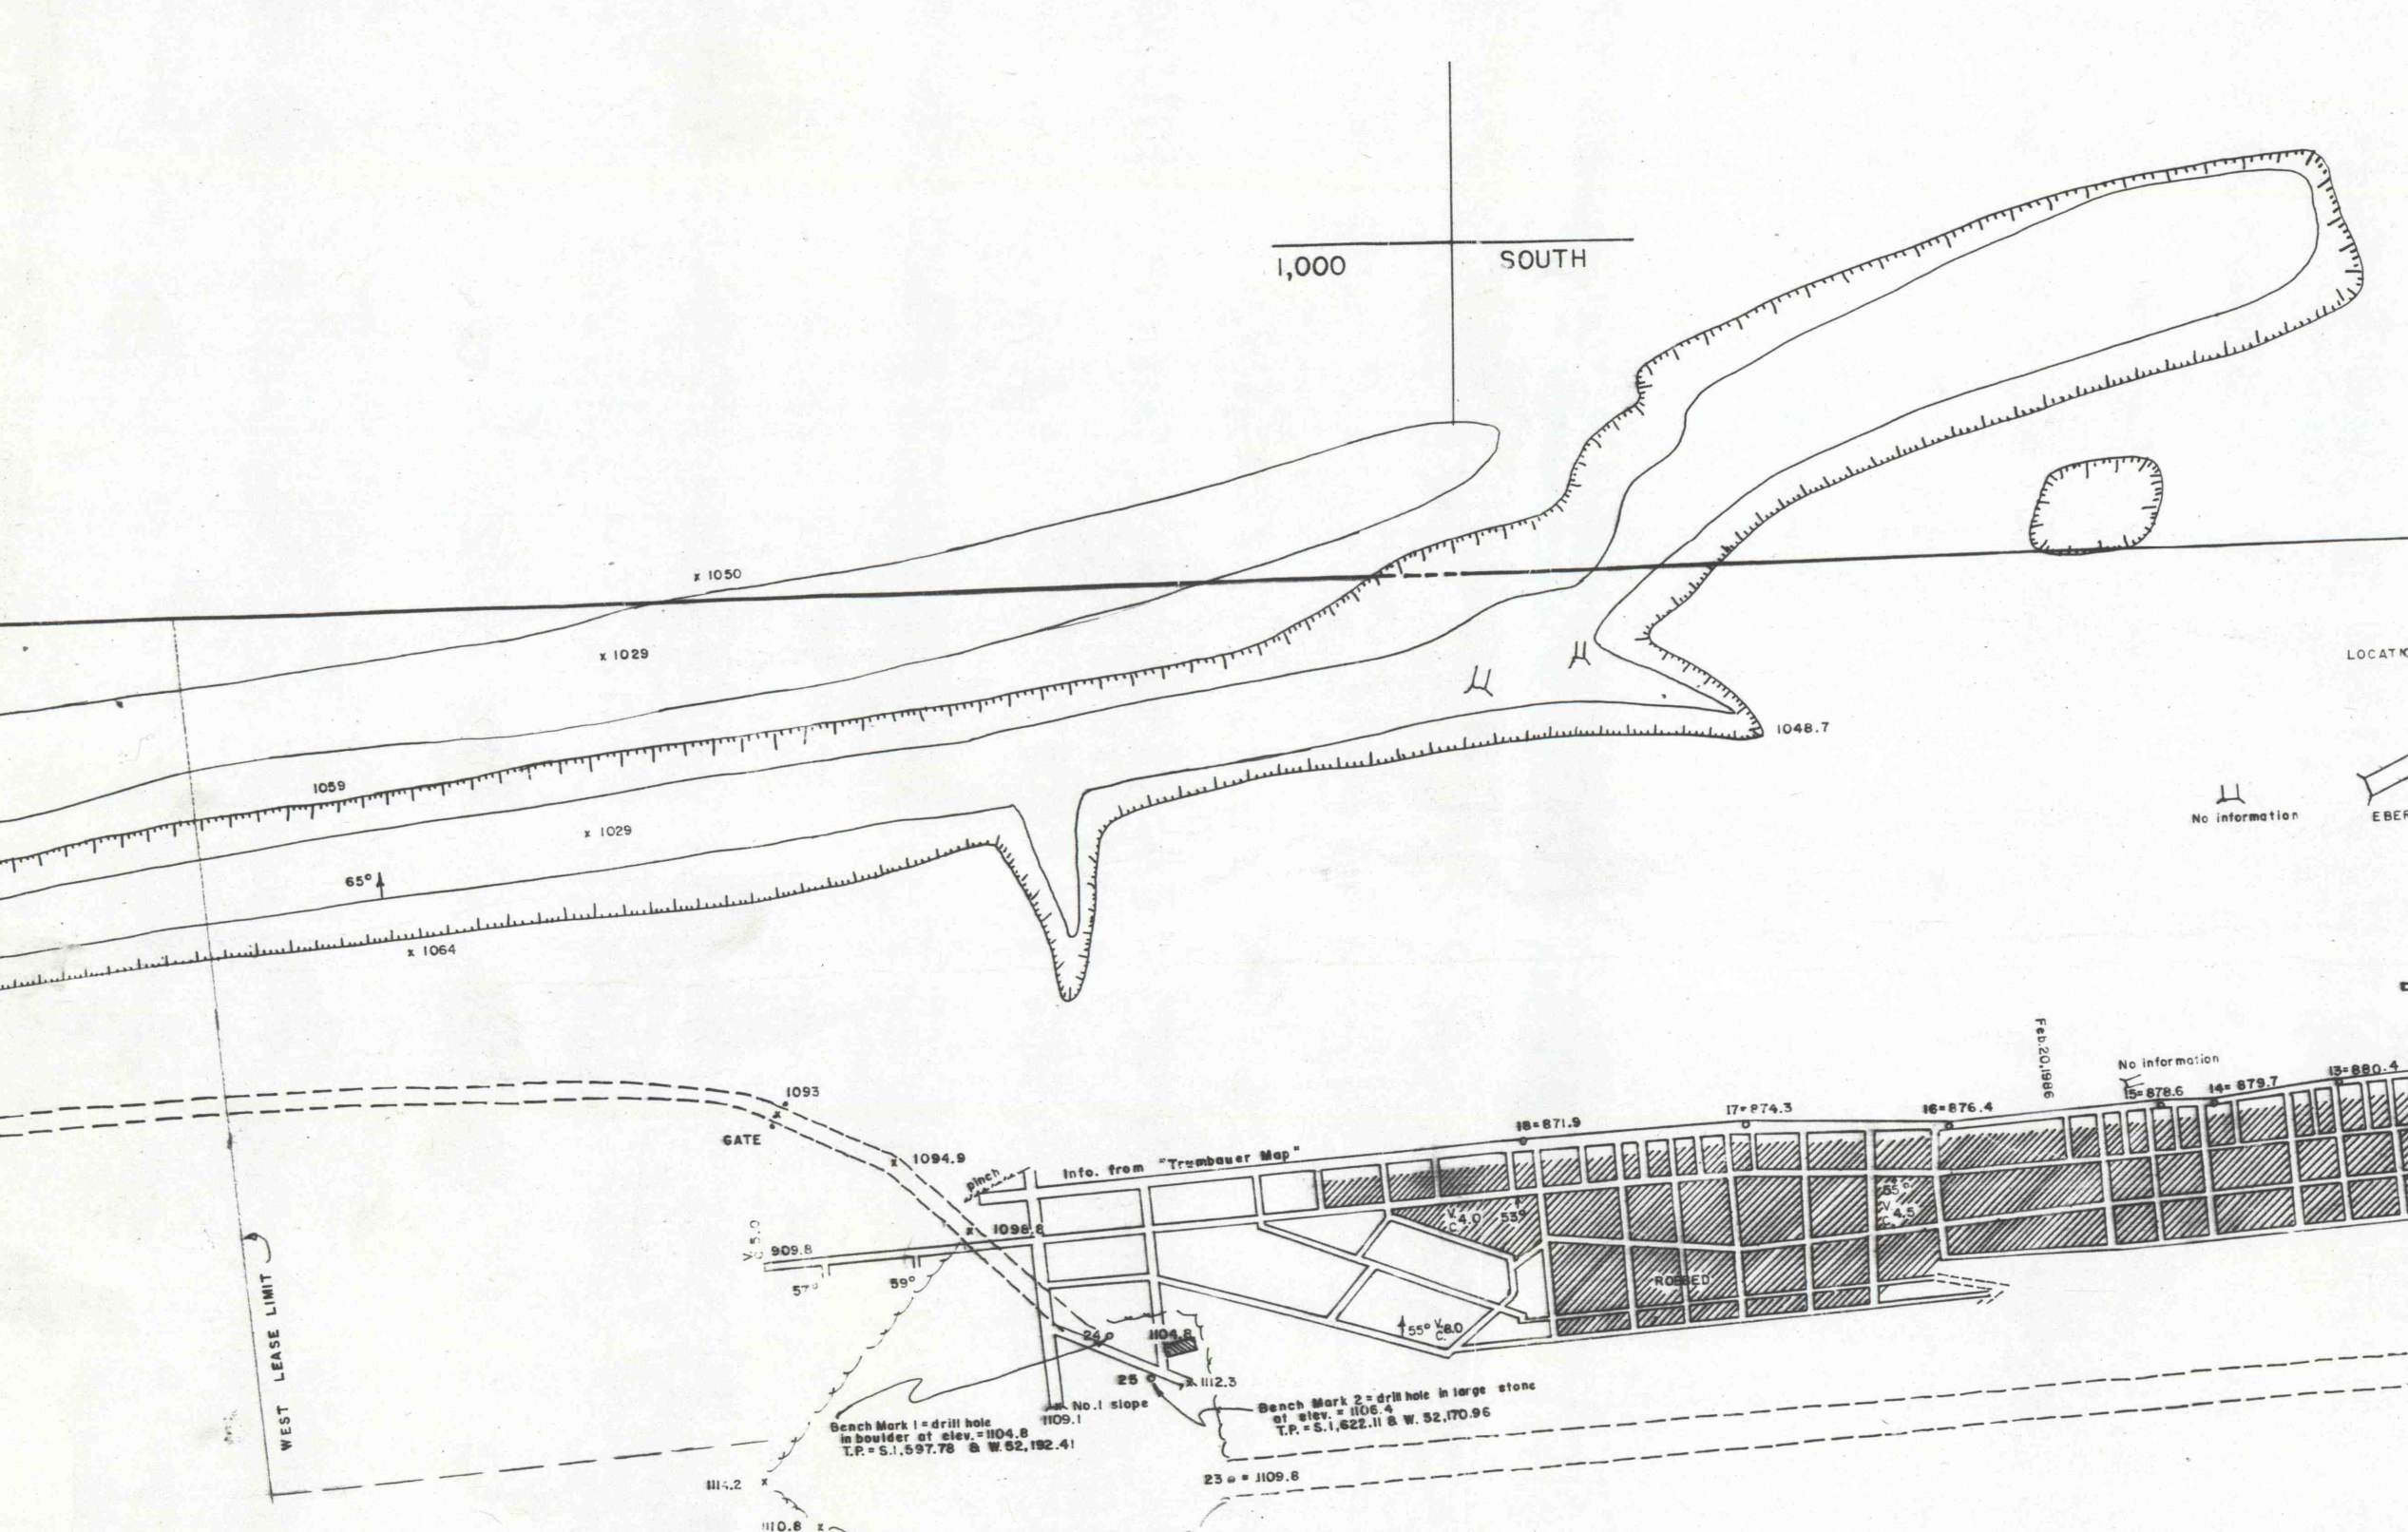


PETER SASSAMAN TRACT

FINAL CLOSURE MAP

Rothermel Coal Company
R.D.#1 - Box 33A, Klingers town, PA 17941

No. 11 Vein Slope
I.D.#36-08415

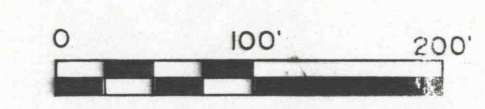

Bar Scale: 1" = 100'
Survey: Aug. 12, 1992
Posted: Dec. 3, 1992
POSTED: Nov. 11, 1993
POSTED: April 13, 1994
POSTED: April 5, 1995
Survey: May 29, 1996
Posted: Oct. 1, 1997

1. No gas or oil wells exist within mining area.

Surveyor's Certification


I hereby certify that to the best of my knowledge that the areas that I have surveyed are true and correct as to the requirements of 30 CFR Part 75.200. All other information shown has been derived from the best available information but can not be field checked. Therefore, surveyor makes no certification to their accuracy.

David L. Williams, P.E.

Mine Operator's Certification

I depose and say that the mine ventilation information shown on this map meets the requirement of 30 CFR Part 75.372 and was prepared by me or under my direction for which I accept full responsibility.

Mine Foreman

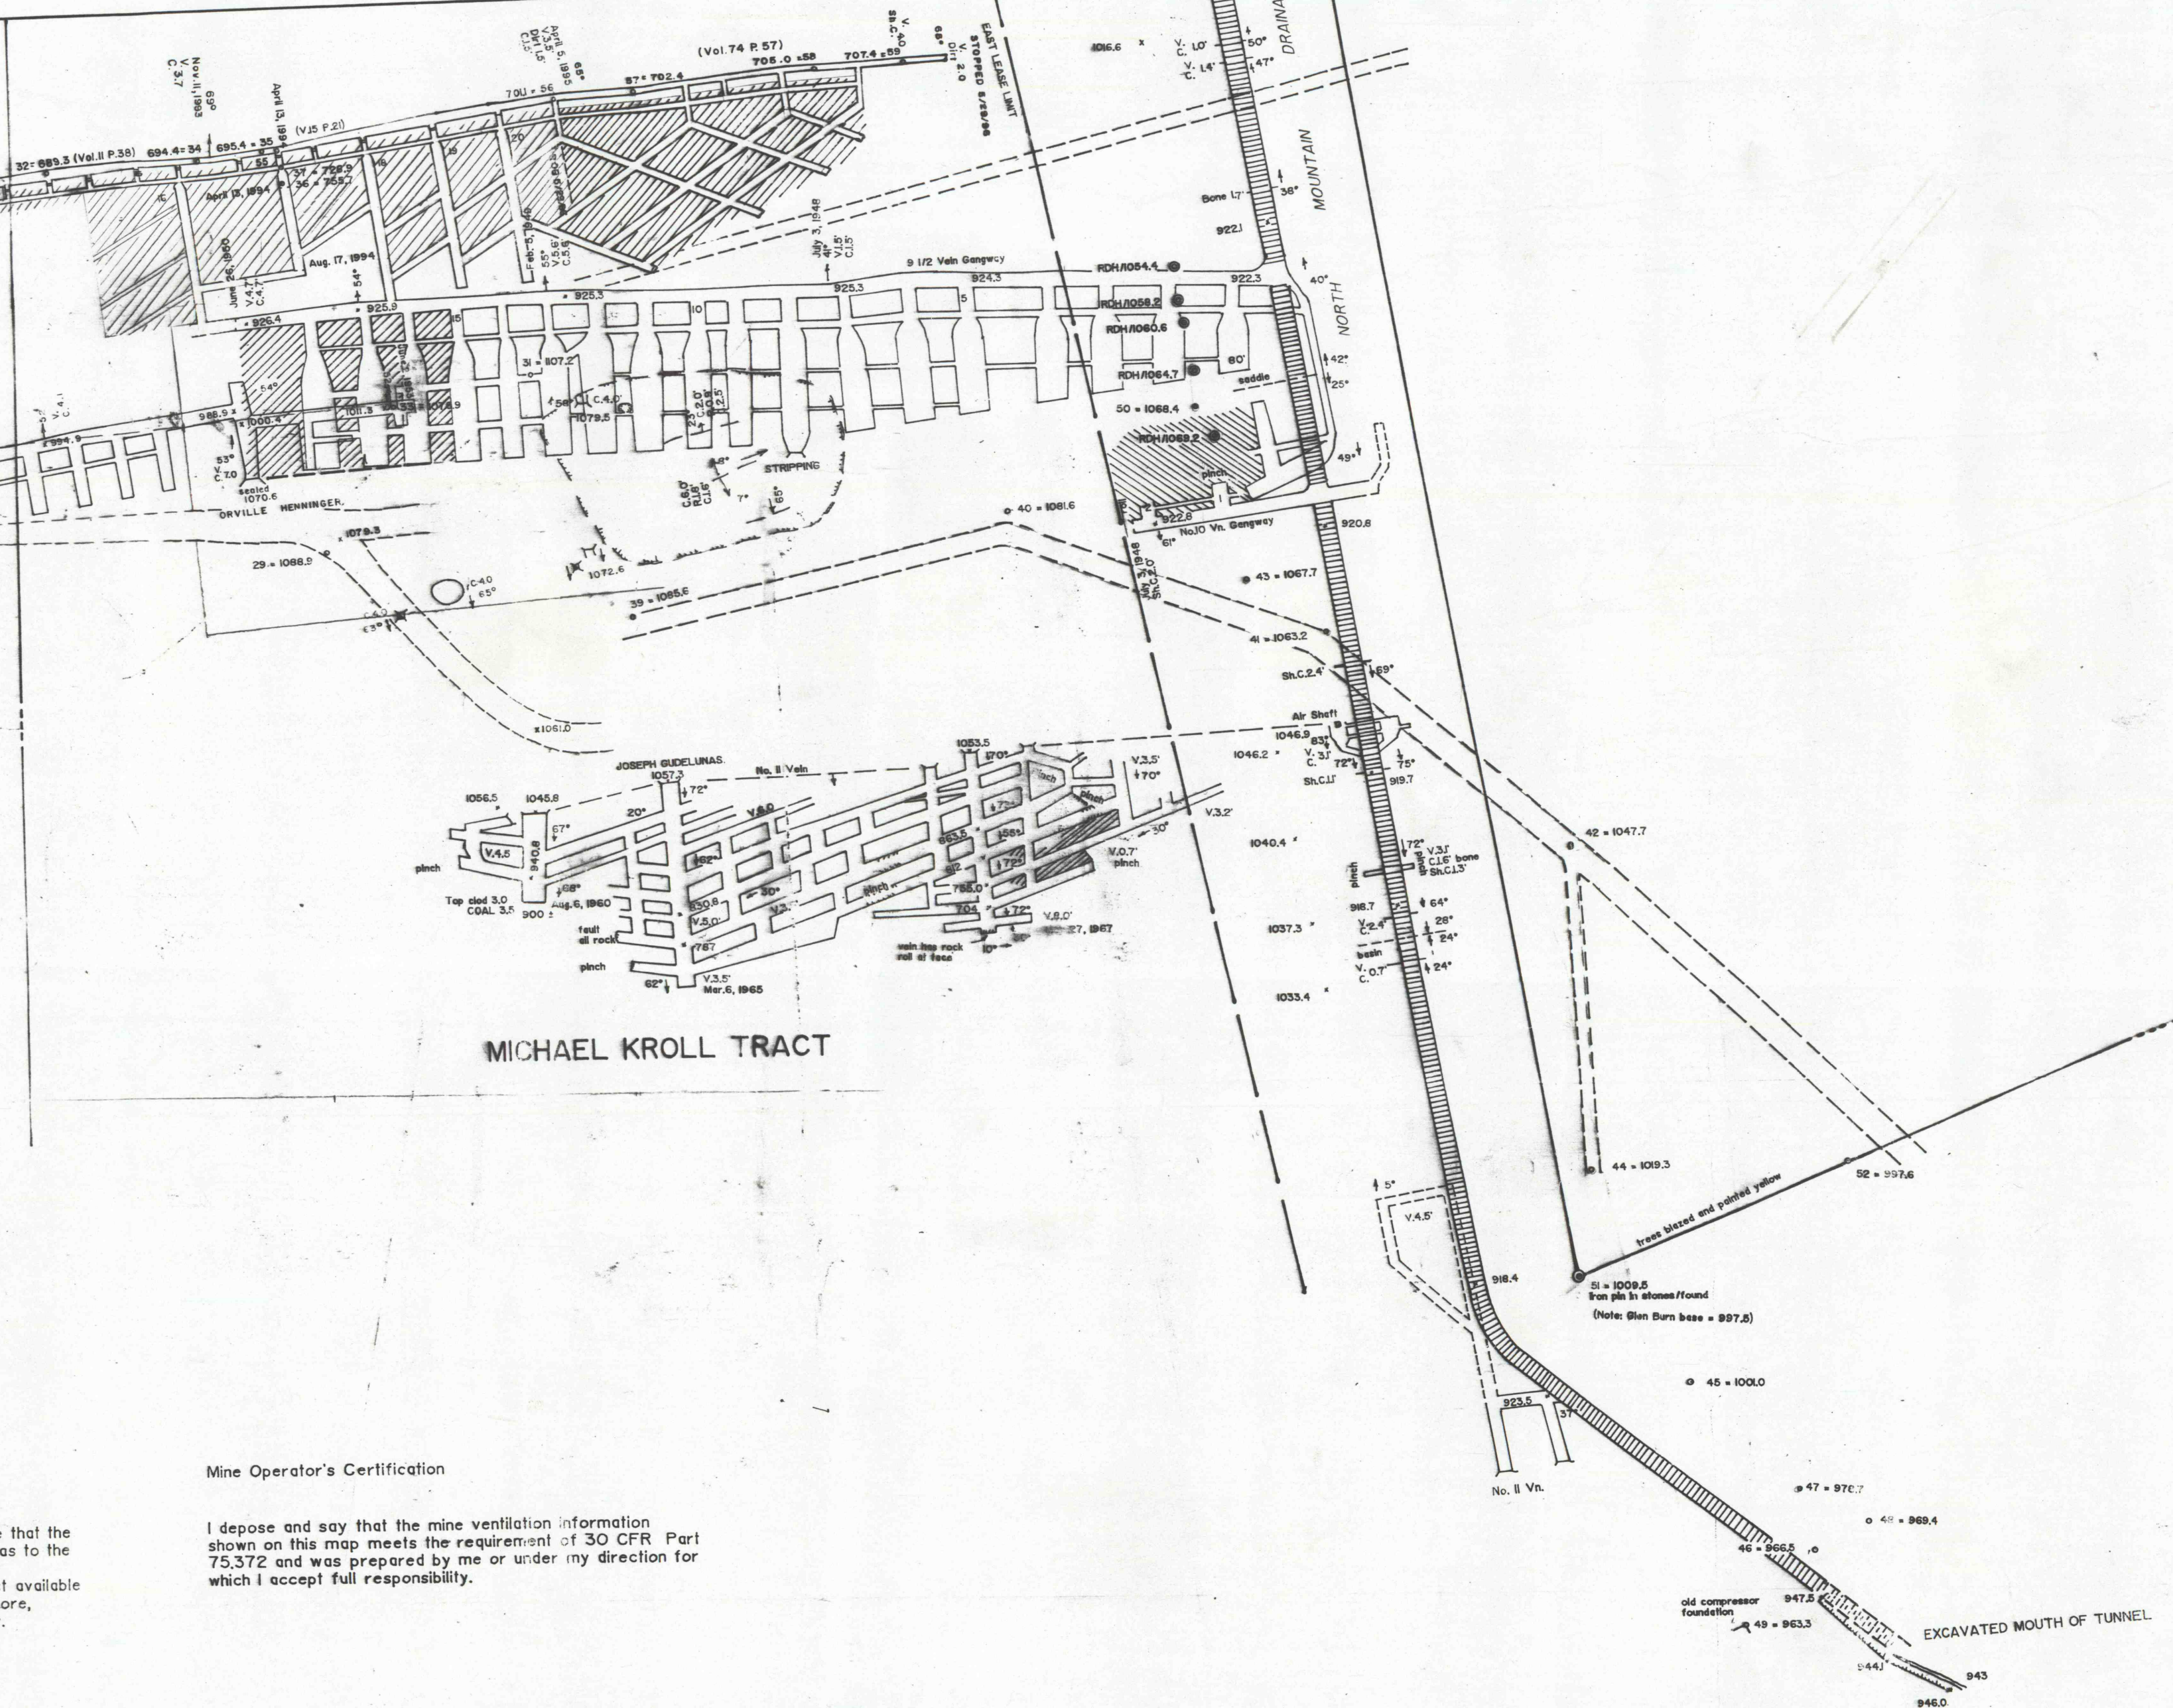

MICHAEL KROLL TRACT

EXCAVATED MOUTH OF TUNNEL