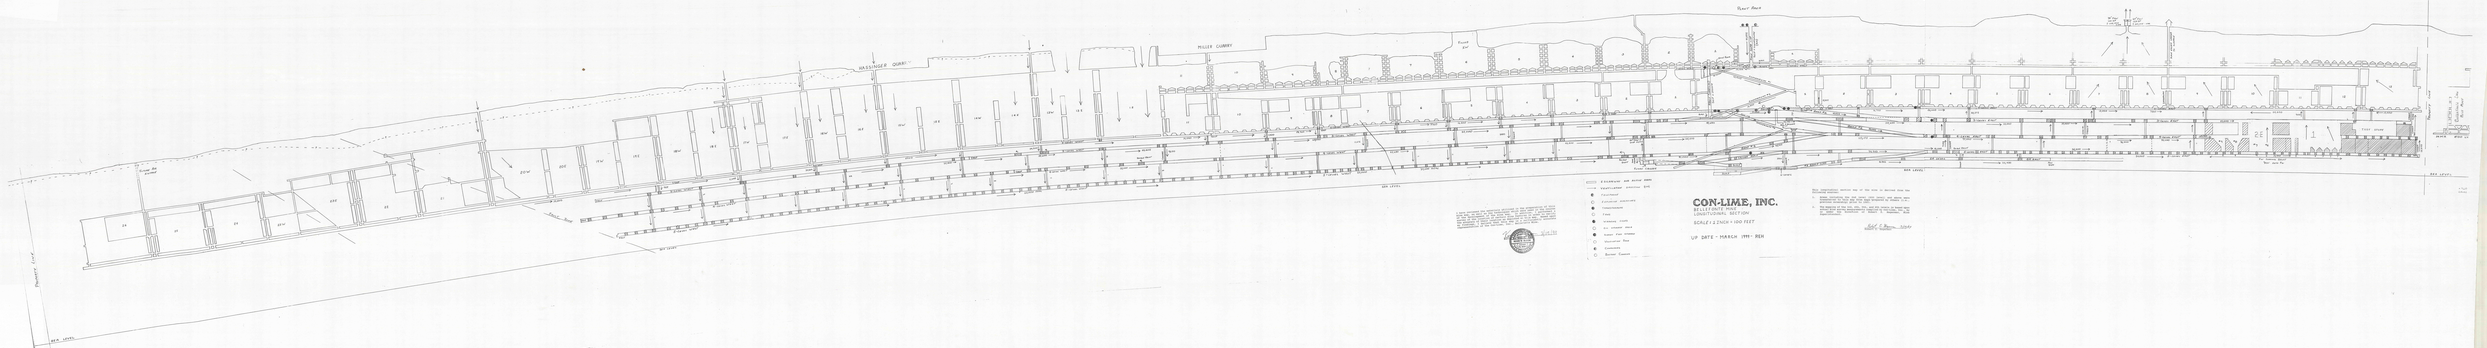
HASSINGER QUARRY
MILLER QUARRY
Plant Road
Present Grade
SEA LEVEL
Grade Elev. 1000'
Grade Elev. 1100'
Grade Elev.