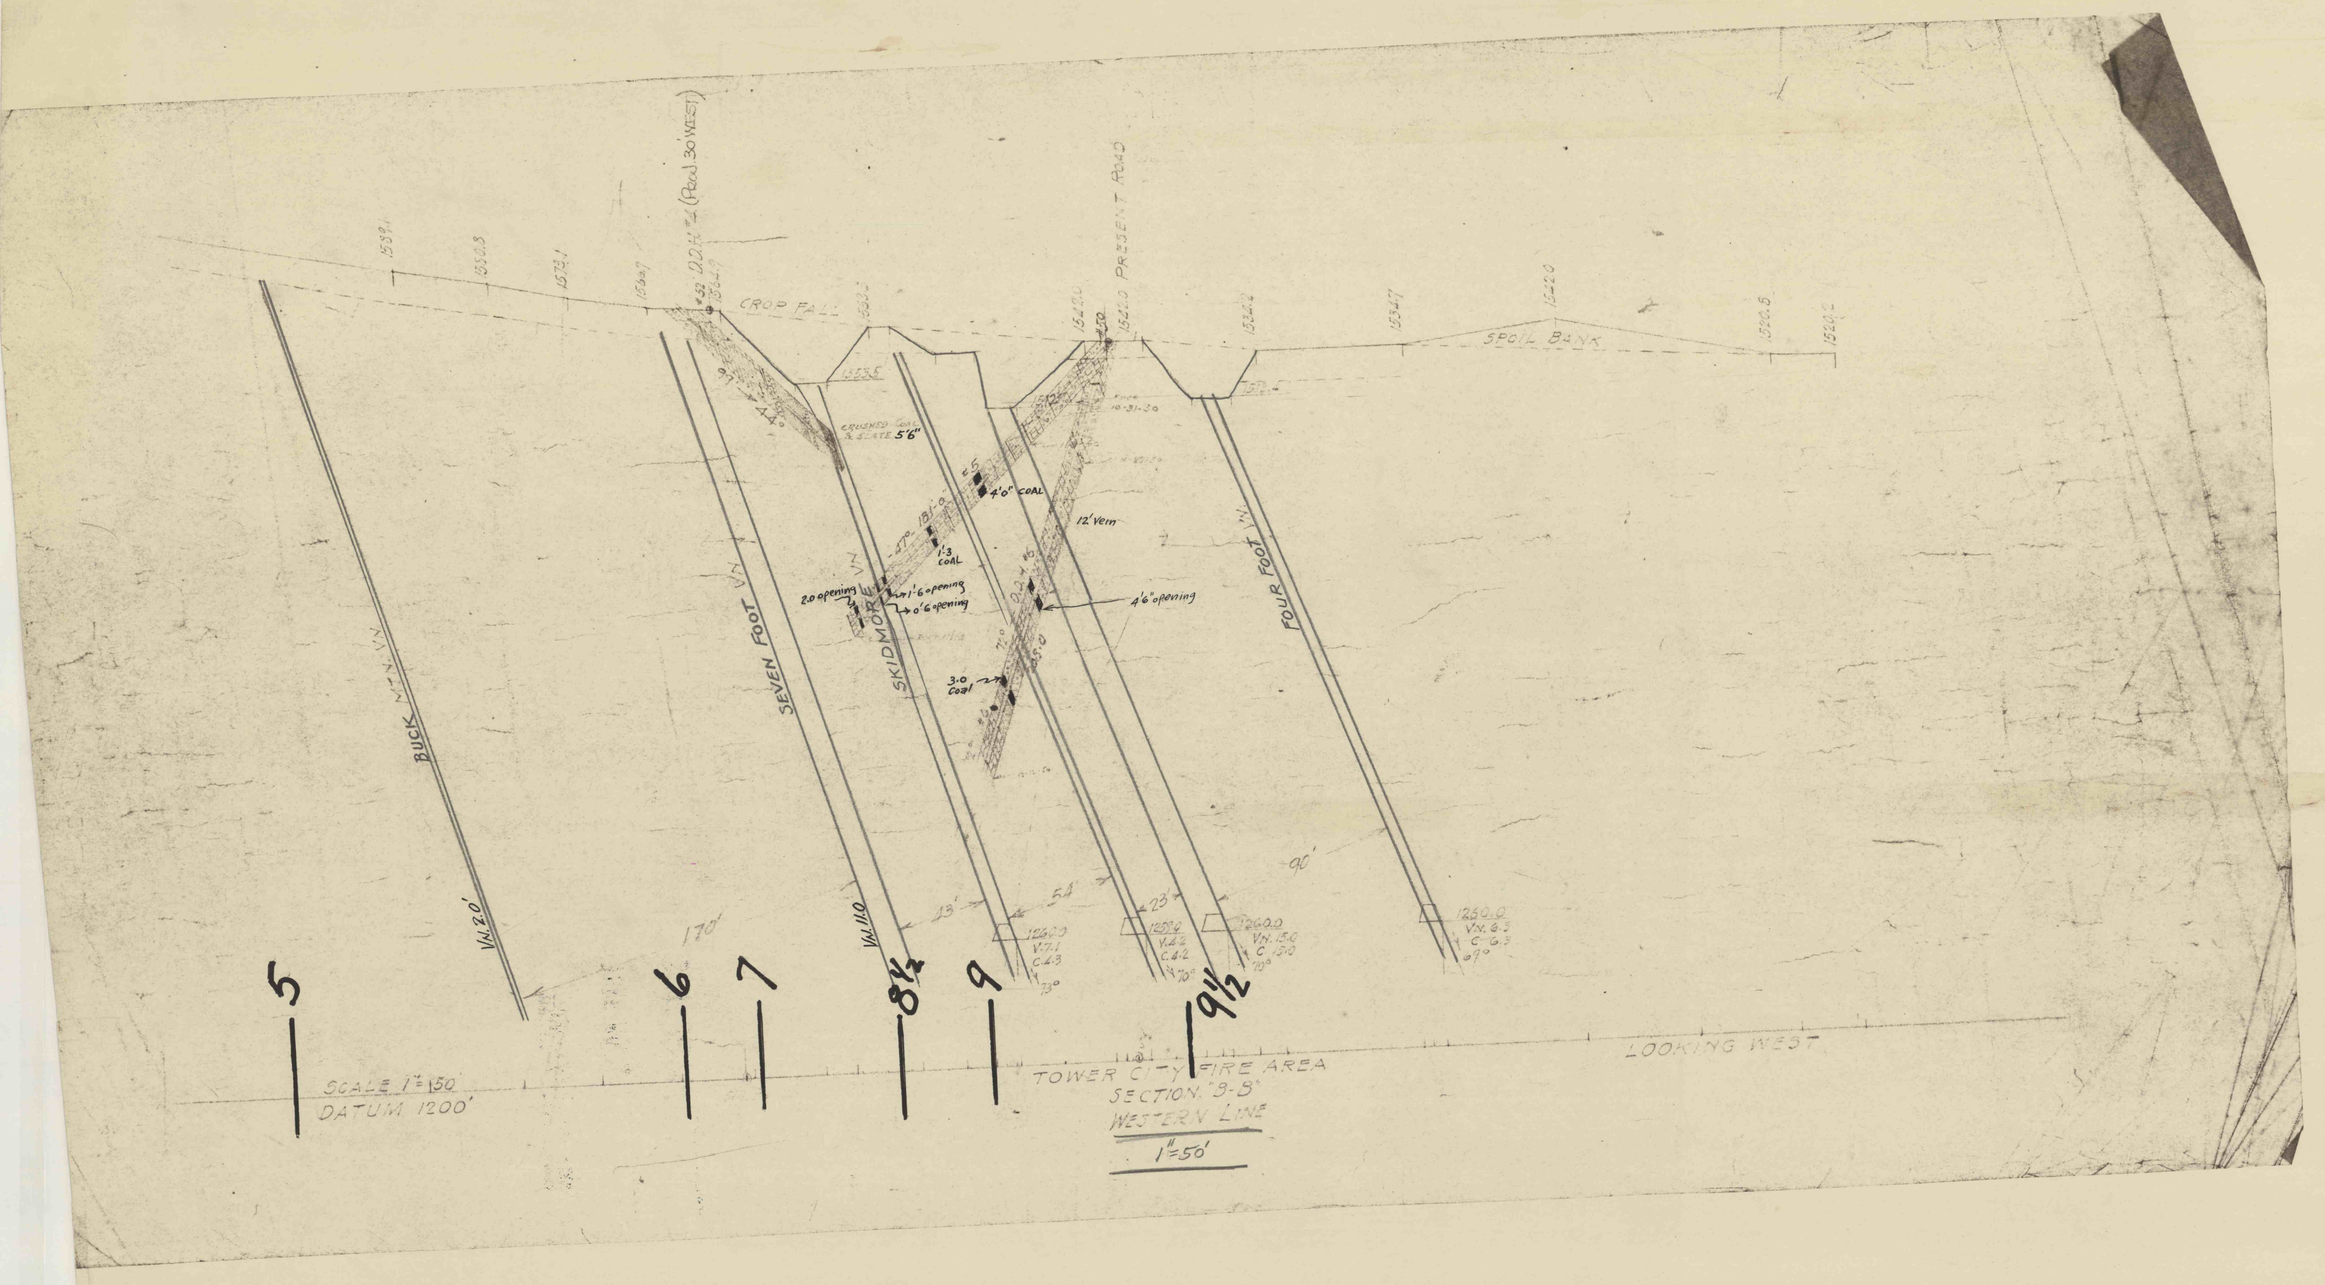
D.D.H. #2 (Road 30' WEST)
CROP FALL
PRESENT ROAD
SPOIL BANK
CRUSHED COAL & SLATE 5'6"
4'0" COAL
12' Vein
1'3 COAL
2.0 opening
1'6 opening
0'6 opening
4'6" opening
3.0 Coal
BUCK MTN. VN.
SEVEN FOOT VN.
SKIDMORE VN.
FOUR FOOT VN.
VN. 120'
VN. 110
170'
13'
54'
23'
90'
5
6
7
8½
9
9½
SCALE 1" = 50'
DATUM 1200'
TOWER CITY FIRE AREA
SECTION "B-B"
WESTERN LINE
1" = 50'
LOOKING WEST

1" = 50'