


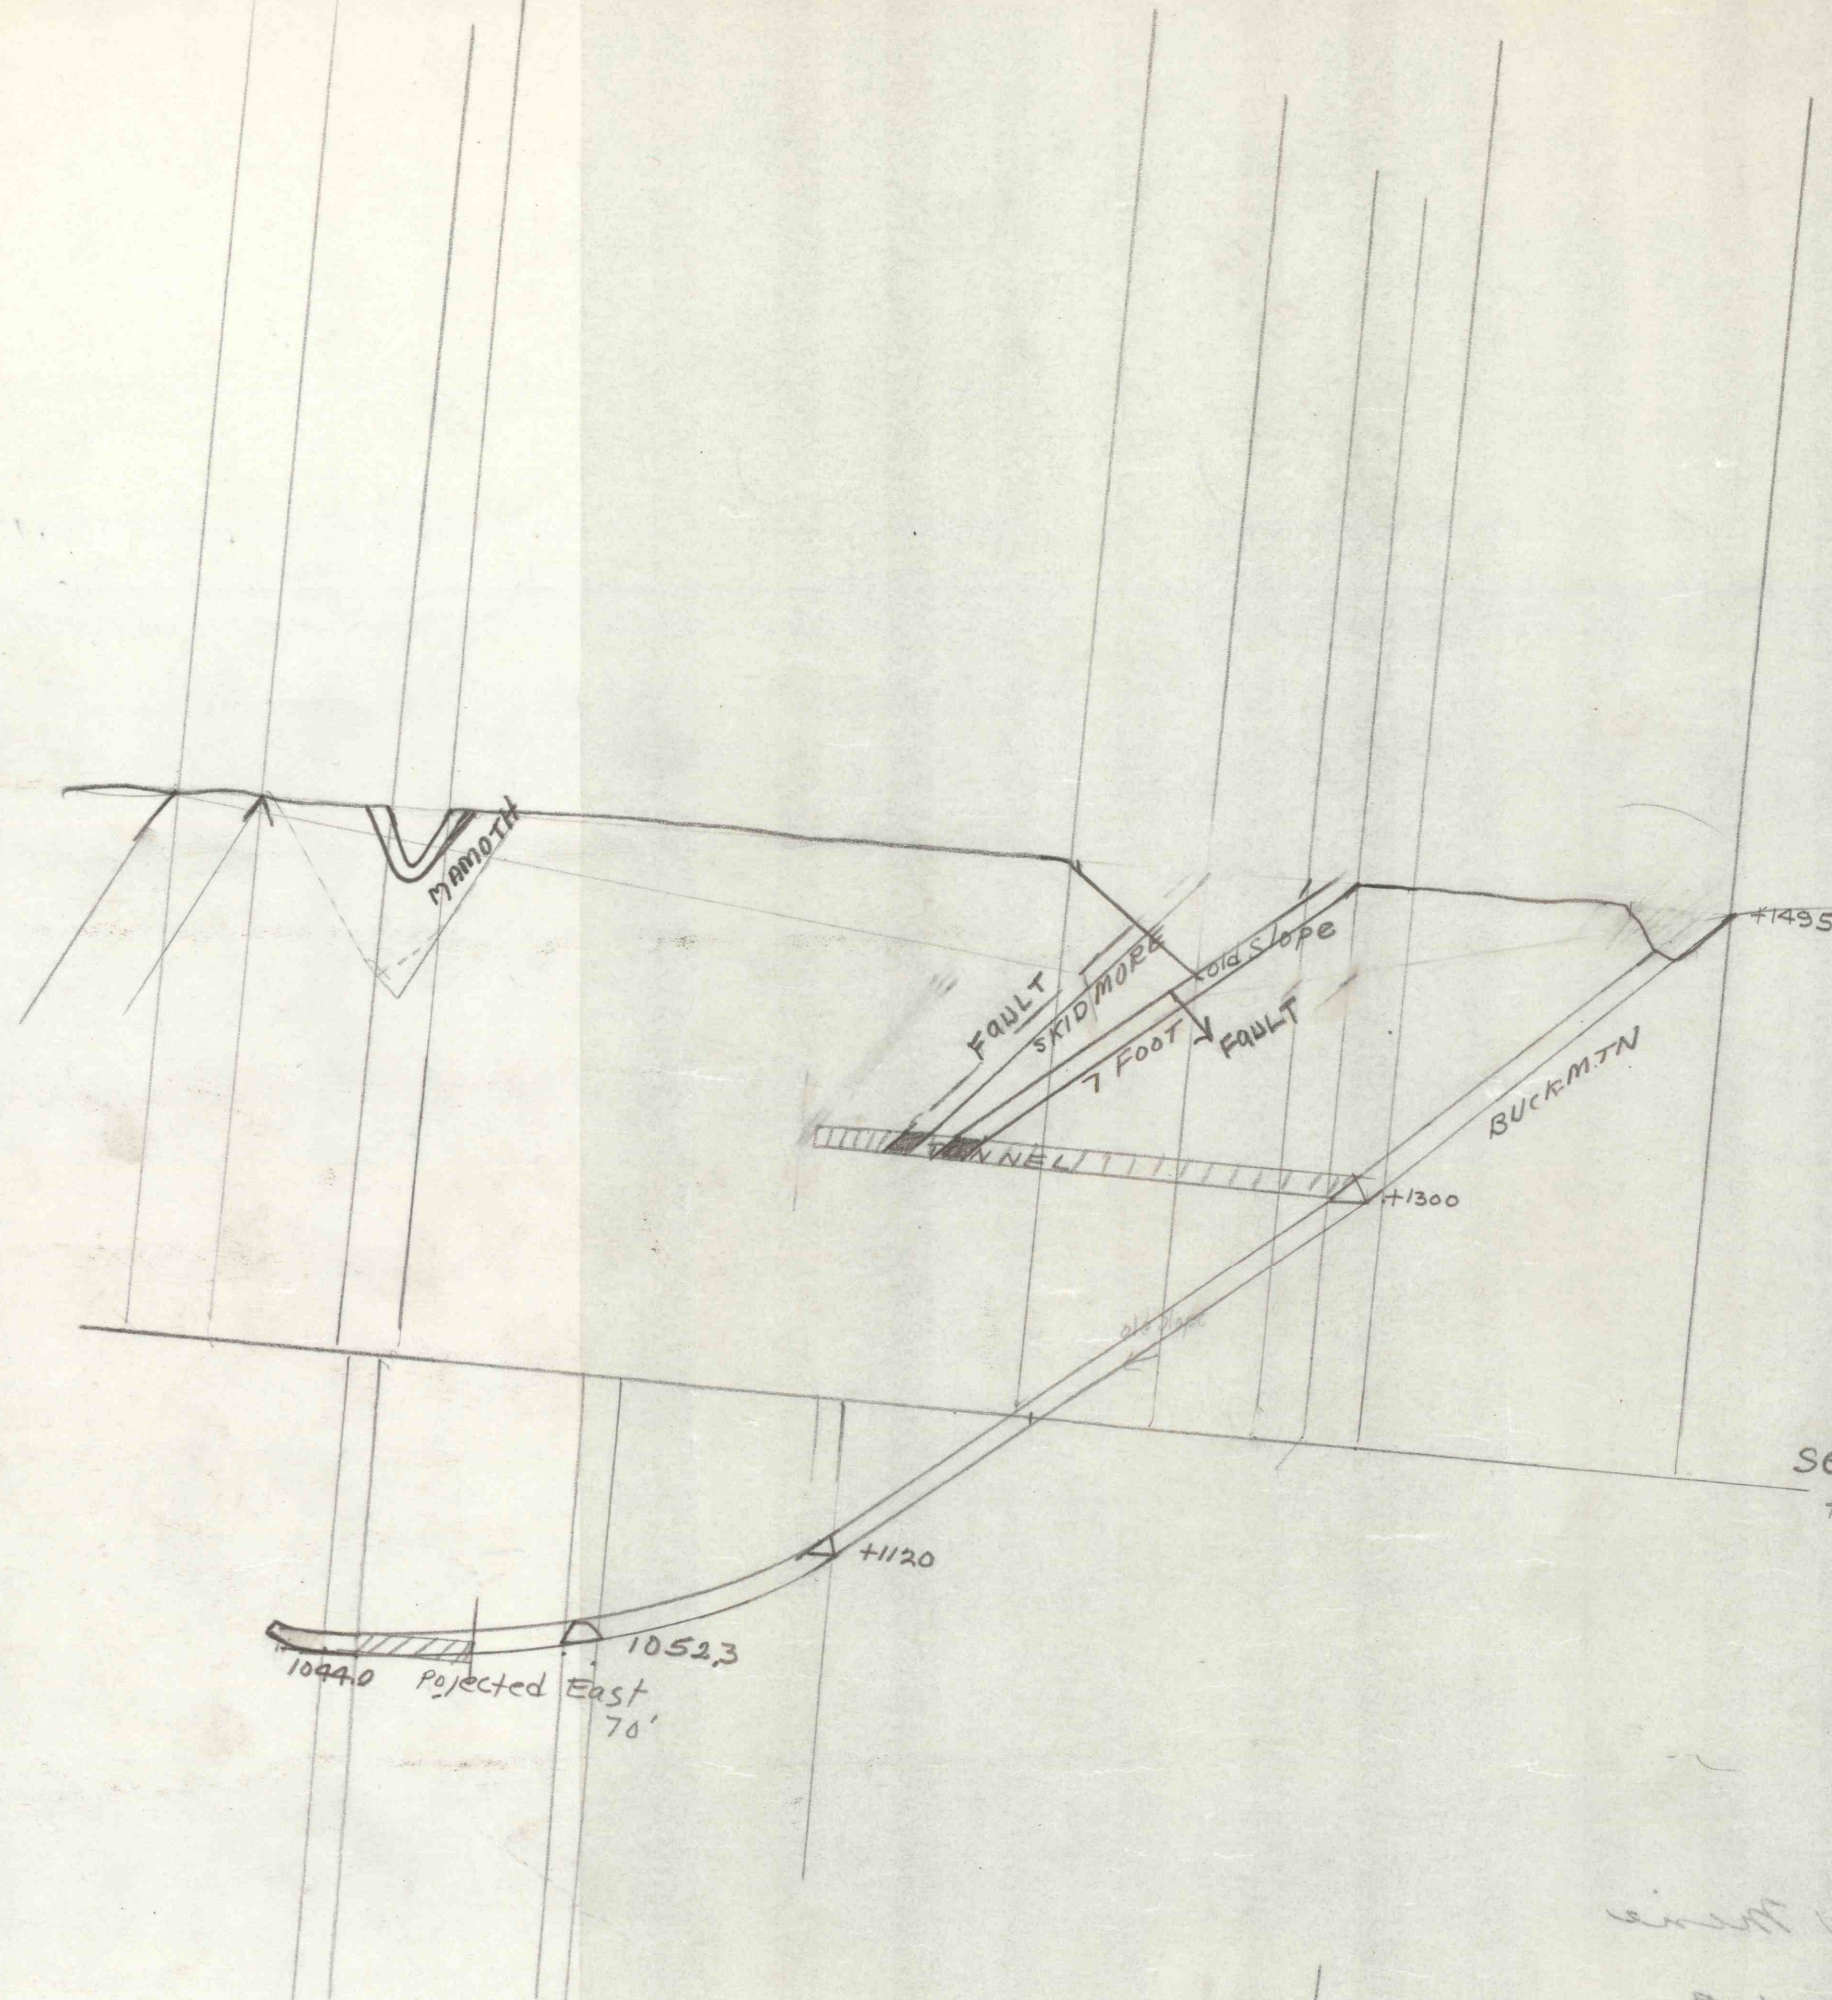

Copyrighted by Mine
Section No. 1-9

CROSS SECTION FILE

TUBE NO. X-16A

SHEET NO. X-322

00065
W8000

Copyrighted by Mine
Section No. 1-9

CROSS SECTION FILE

TUBE NO. X-16A

SHEET NO. X-322