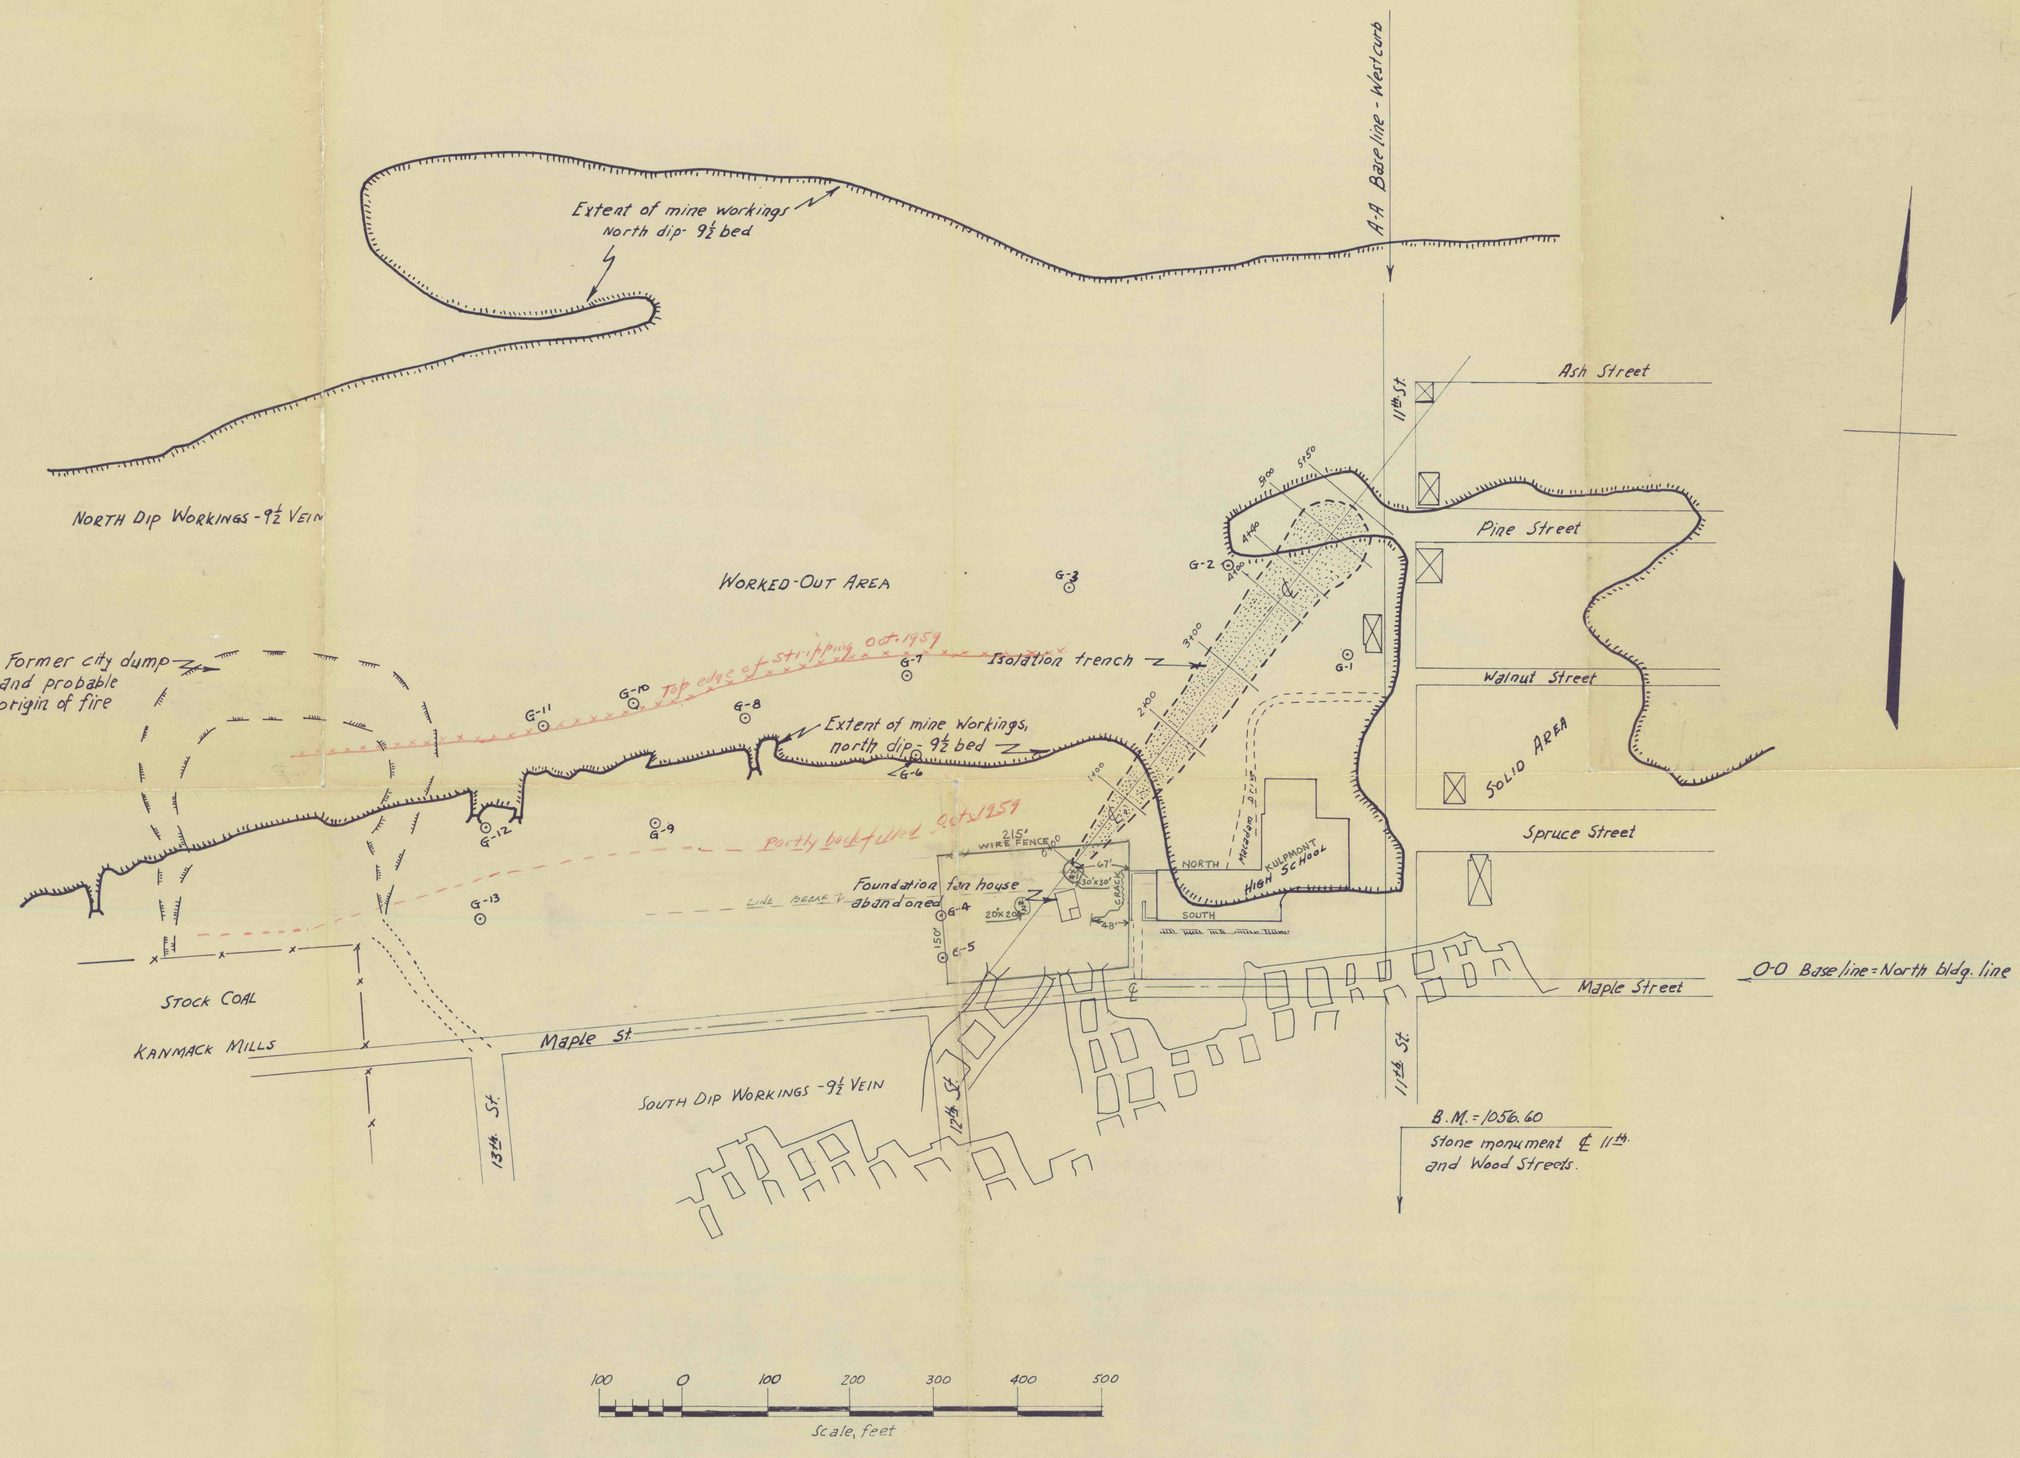

Map of fire area near high school, Kulpmont, Northumberland Co., Penna.