


WILLIAM P. BRADY TRA

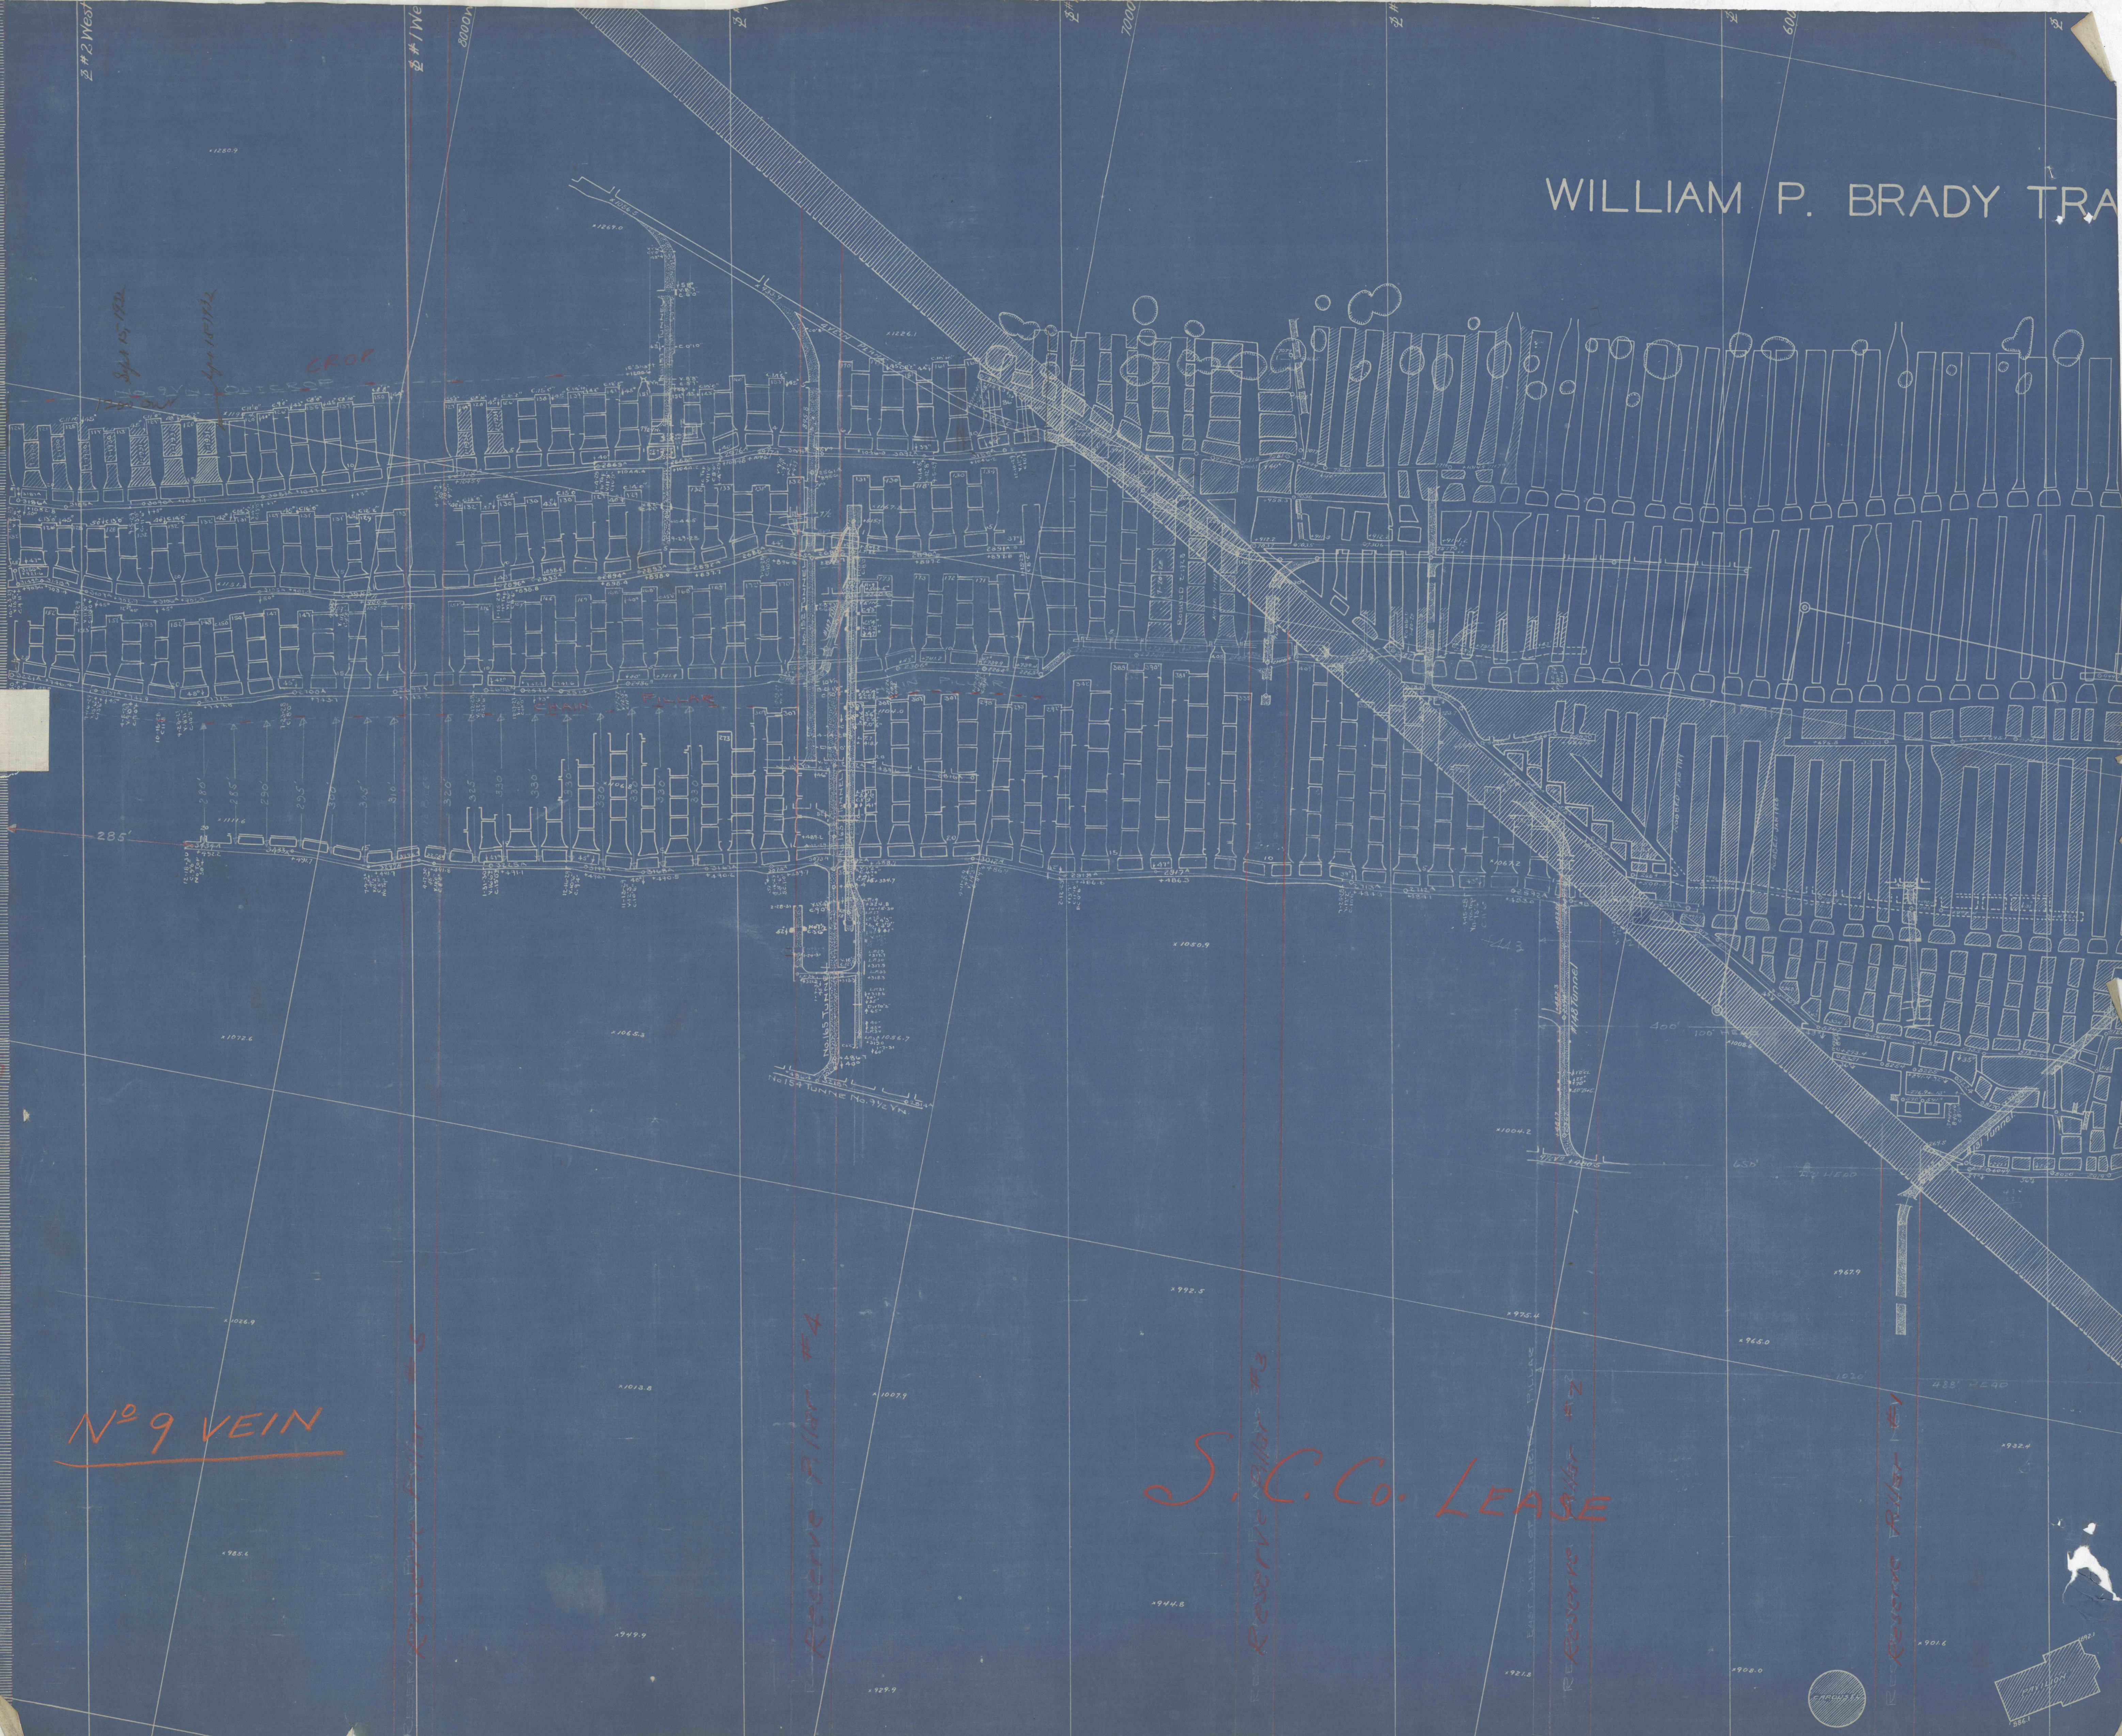

Nº 9 VEIN

Reserve Pillar #4

S.C. Co. LEASE

Reserve Pillar #2

Reserve Pillar #1

