


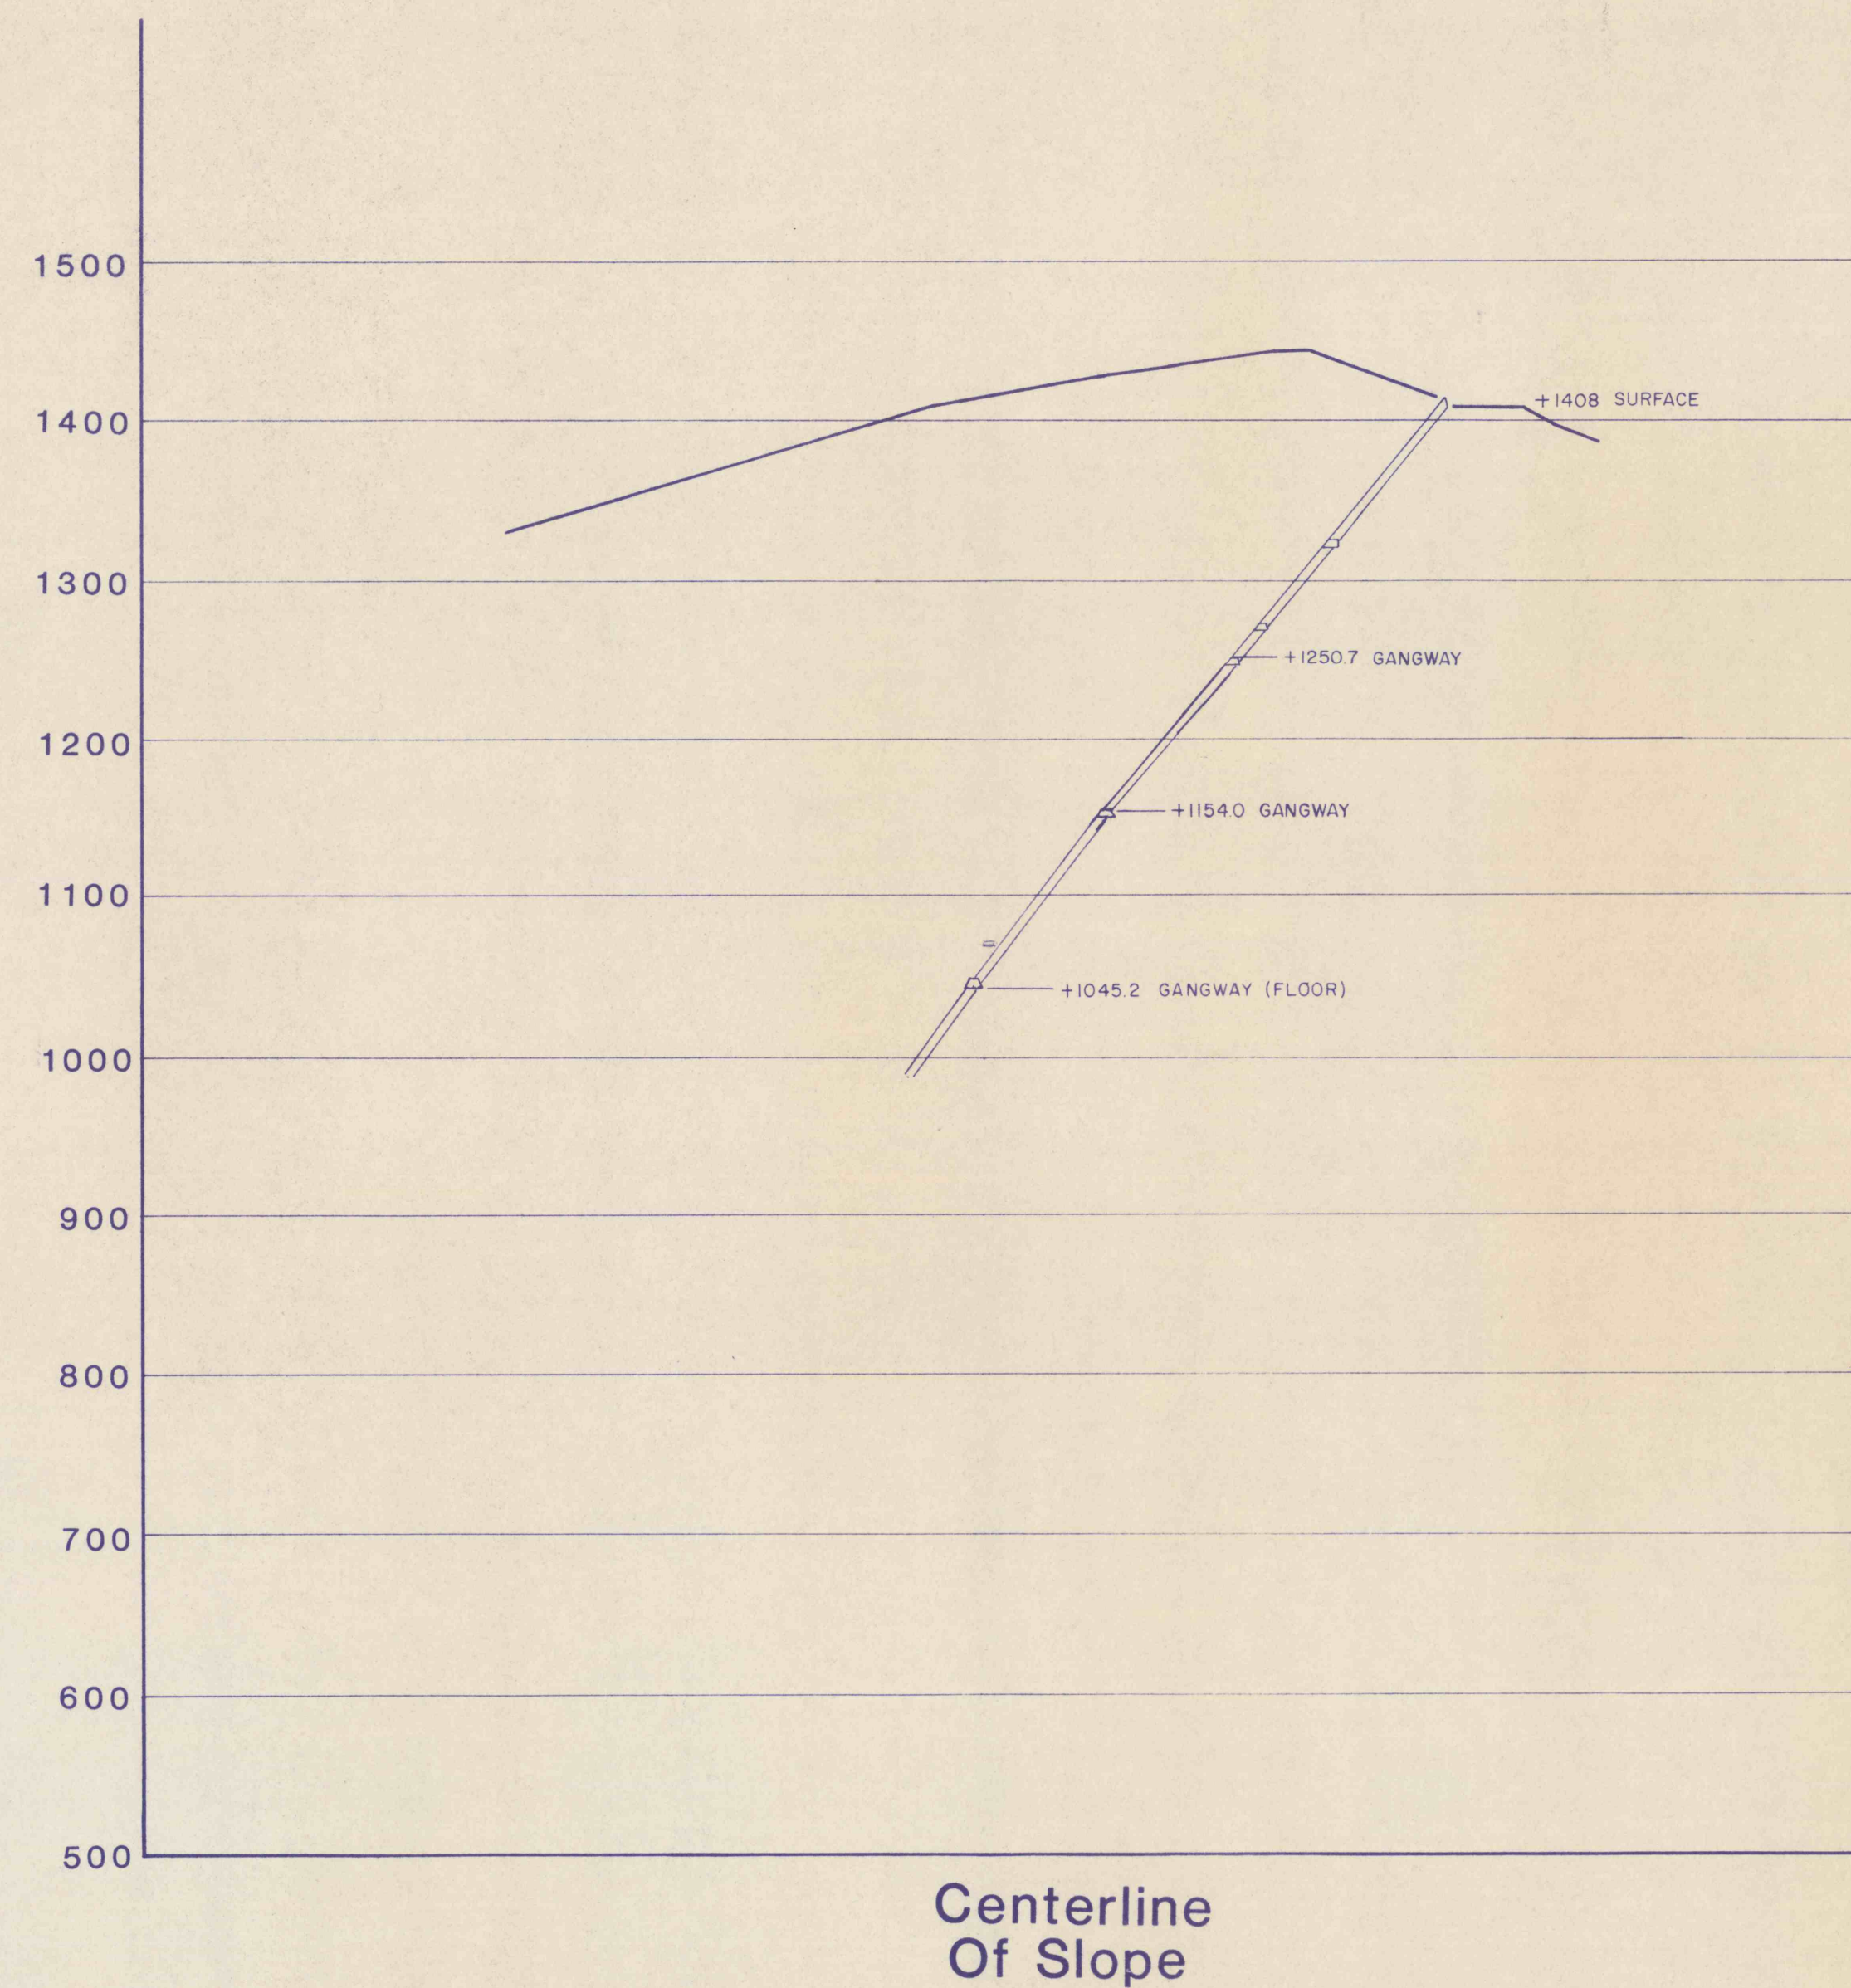


No. 2 Vein - South Dip


MINE SURVEY FOR
NORTH MOUNTAIN COAL CO.
 COAL TOWNSHIP, NORTHUMBERLAND COUNTY
 PENNSYLVANIA

SCALE: VERTICAL - 1 INCH = 100 FEET
 HORIZONTAL - 1 INCH = 100 FEET
 M.S.H.A. I.D. #36-05873

OCTOBER 16, 1985
 REVISED: NOV. 6, 1987
 MAY 15, 1990

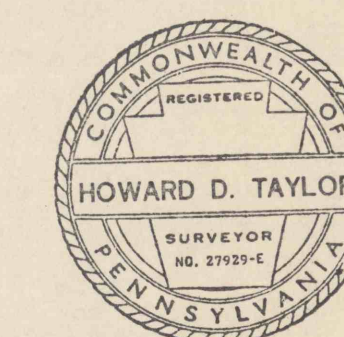

Taylor-Doberk Associates
 PROFESSIONAL LAND SURVEYORS
 RD #1 BOX 659
 SHAMOKIN, PA. 17872

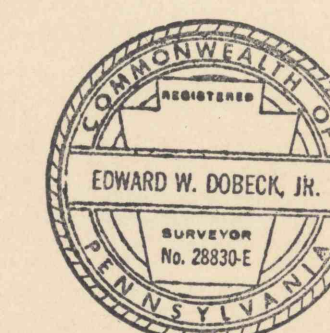

Howard D. Taylor, P.L.S.

Cross-Sections
 SHEET NO. 3 OF 4