

Horizontal Control Data Sub-Surface		
Station No. 45 Spad In Ceiling N = 900.27 (N) E = -8,985.72 (W)	Station No. 63 Eye Hook N = 970.08 (N) E = -8,782.21 (W)	Station No. 123 P.K. In Plank On Gangway Floor N = 662.72 (N) E = -8,839.10 (W)
Station No. 46 Spad In Ceiling N = 885.44 (N) E = -8,923.50 (W)	Station No. 71 Chisel Mark On Angle Iron On Tipple N = 951.14 (N) E = -8,893.80 (W)	Station No. 124 Spad In Ceiling N = 619.62 (N) E = -9,089.78 (W)
Station No. 47 P. K. Nail N = 899.95 (N) E = -9,047.79 (W)	Station No. 73 Spad In Ceiling N = 742.20 (N) E = -8,855.28 (W)	Station No. 125 Spad In Ceiling N = 704.43 (N) E = -8,685.93 (W)
Station No. 48 Spad In Ceiling N = 843.32 (N) E = -8,928.01 (W)	Station No. 74 Spad In Ceiling N = 751.14 (N) E = -8,809.64 (W)	Station No. 126 Spad In Ceiling N = 651.01 (N) E = -8,835.90 (W)
Station No. 49 Spad In Ceiling N = 835.81 (N) E = -8,903.49 (W)	Station No. 75 Spad In Ceiling N = 729.38 (N) E = -8,947.62 (W)	
Station No. 51 P. K. Nail Centerline Of Track N = 837.56 (N) E = -8,871.42 (W)	Station No. 115 Spad In Ceiling N = 771.29 (N) E = -8,741.23 (W)	
Station No. 52 Spad In Ceiling N = 836.72 (N) E = -8,862.04 (W)	Station No. 116 Spad In Ceiling N = 797.15 (N) E = -8,649.30 (W)	
Station No. 53 Spad In Ceiling N = 818.58 (N) E = -8,868.22 (W)	Station No. 119 Spad In Ceiling N = 812.76 (N) E = -8,569.11 (W)	
Station No. 58 Spad In Ceiling N = 869.69 (N) E = -8,818.90 (W)	Station No. 120 Spad In Ceiling N = 823.68 (N) E = -8,523.60 (W)	
Station No. 60 Spad In Ceiling N = 908.21 (N) E = -8,833.85 (W)	Station No. 121 Spad In Ceiling N = 834.99 (N) E = -8,461.73 (W)	
Station No. 62 Spad In Ceiling N = 943.93 (N) E = -8,783.80 (W)	Station No. 122 Spad In Ceiling N = 854.20 (N) E = -8,528.63 (W)	

LEGEND:

ESCAPEWAY	(E)
ROBBED	(Hatched Box)
SURVEY STATION	○ ₃ (TAYLOR-DOBECK ASSOC.) ○ _{4/67A} (SUSQUEHANNA COAL CO.)
ELEVATION	+1382 (SUSQUEHANNA COAL CO. DATUM)
STOPPING	(Double Line)
INTAKE AIR	I (Arrow)
RETURN AIR	R (Arrow)
OLD ABANDONED WORKINGS	(Dashed Line)
NEW WORKINGS OF NORTH MOUNTAIN COAL CO.	(Solid Line)
PROPERTY LINE	(Thick Solid Line)
OUTCROP LINE	(Dashed Line)
PITCH OF VEIN (DEGREES)	50°

NOTES:

1. LOCATIONS AND EXTENT OF OLD ABANDONED WORKINGS UNKNOWN


No. 2 Vein - South Dip

MINE SURVEY FOR
NORTH MOUNTAIN COAL CO.
COAL TOWNSHIP, NORTHUMBERLAND COUNTY
PENNSYLVANIA


SCALE: 1 INCH = 100 FEET, OCTOBER 16, 1985

M.S.H.A. I.D.# 36-05873

NOV. 14, 1988
JAN. 20, 1989
MAY 23, 1989
MAY 15, 1990

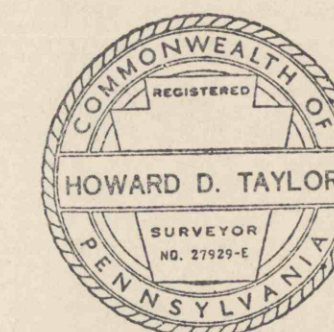

Taylor-Doberck Associates
PROFESSIONAL LAND SURVEYORS
RD#1 BOX 659
SHAMOKIN, PA. 17872

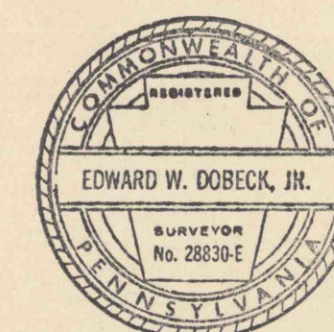

Sub-Surface
SHEET NO. 2 OF 4