


SEARLE & STARK.

C. S. MALTBY.

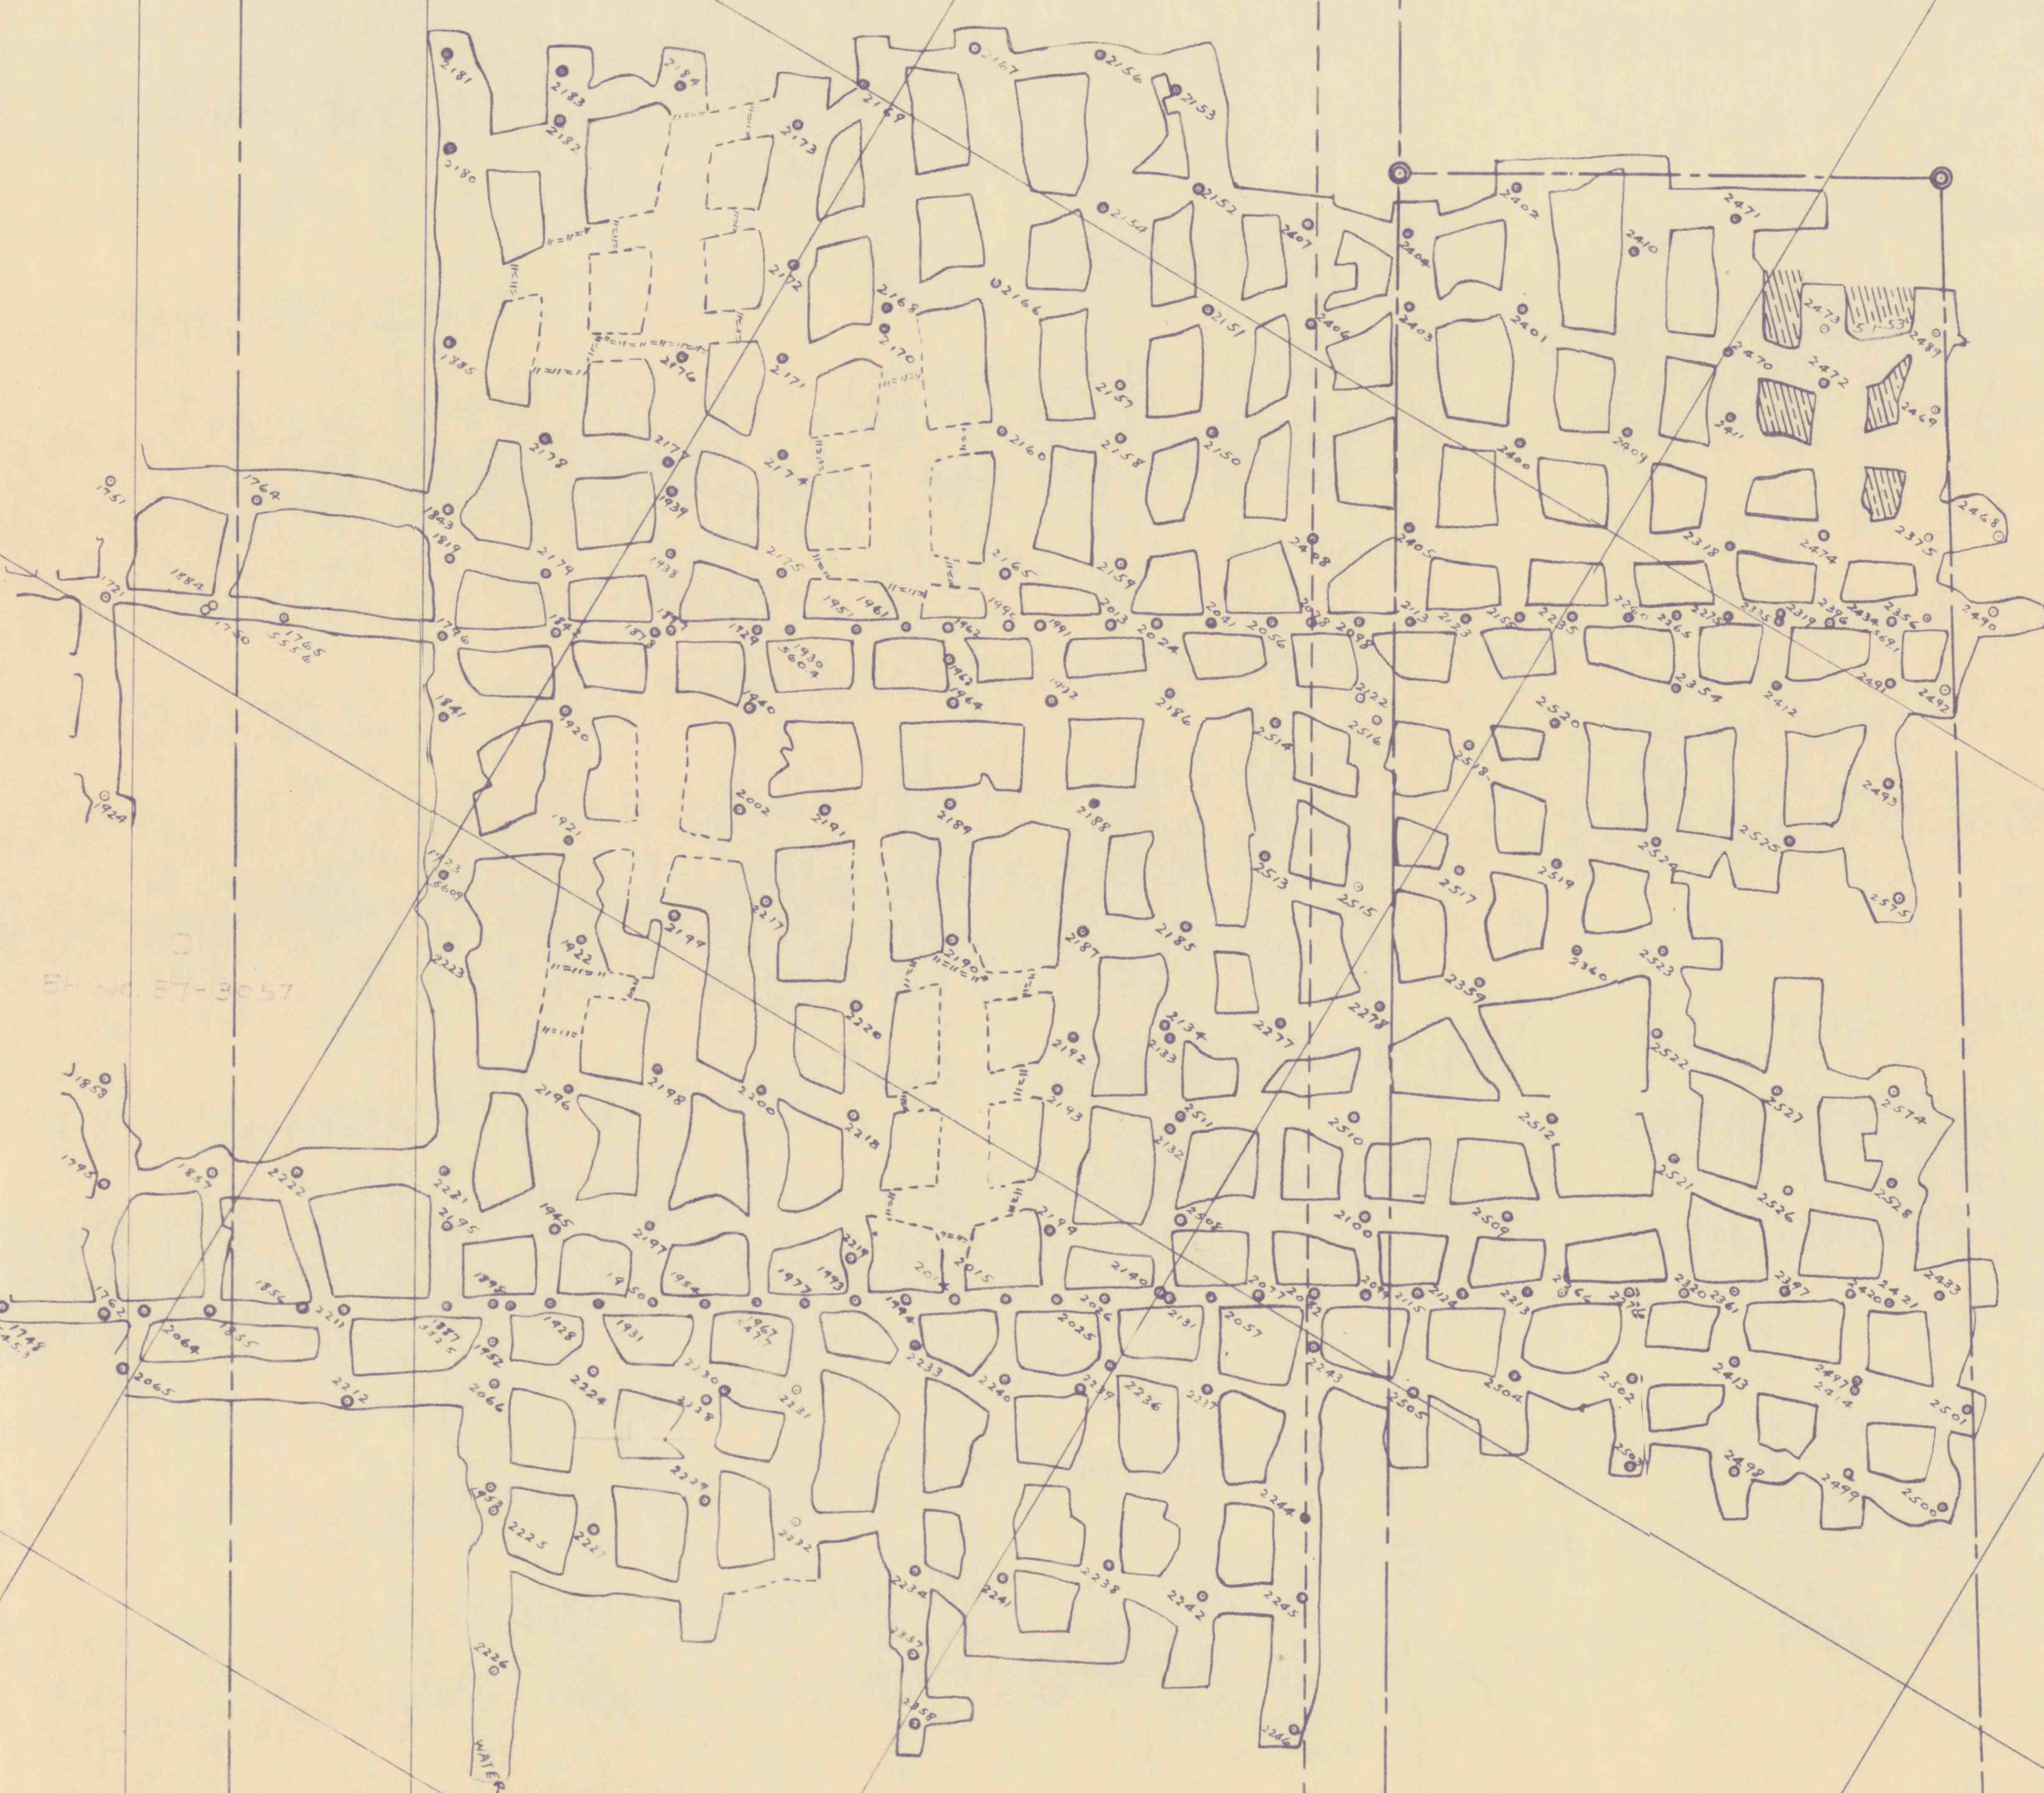

ALL MINING SURVEYS AND RECORDS MADE BY
FLOYD G. WILCOX
MAY 1902

I. E. STEARNS.

C. S. MALTBY.

R. G. SHOEMAKER.

S & G SHOEMAKER.

R. C.

SHOEMAKER.

JANE H. SHOEMAKER.

HARRY E. COAL CO.
TOP ROSS BED.
MALTBY SECTION
SHOYERVILLE, PA.
SCALE 1"=100'
DATUM 500 FEET BELOW MEAN TIDE.

INSPECTOR TRACING.
EXTENDED.