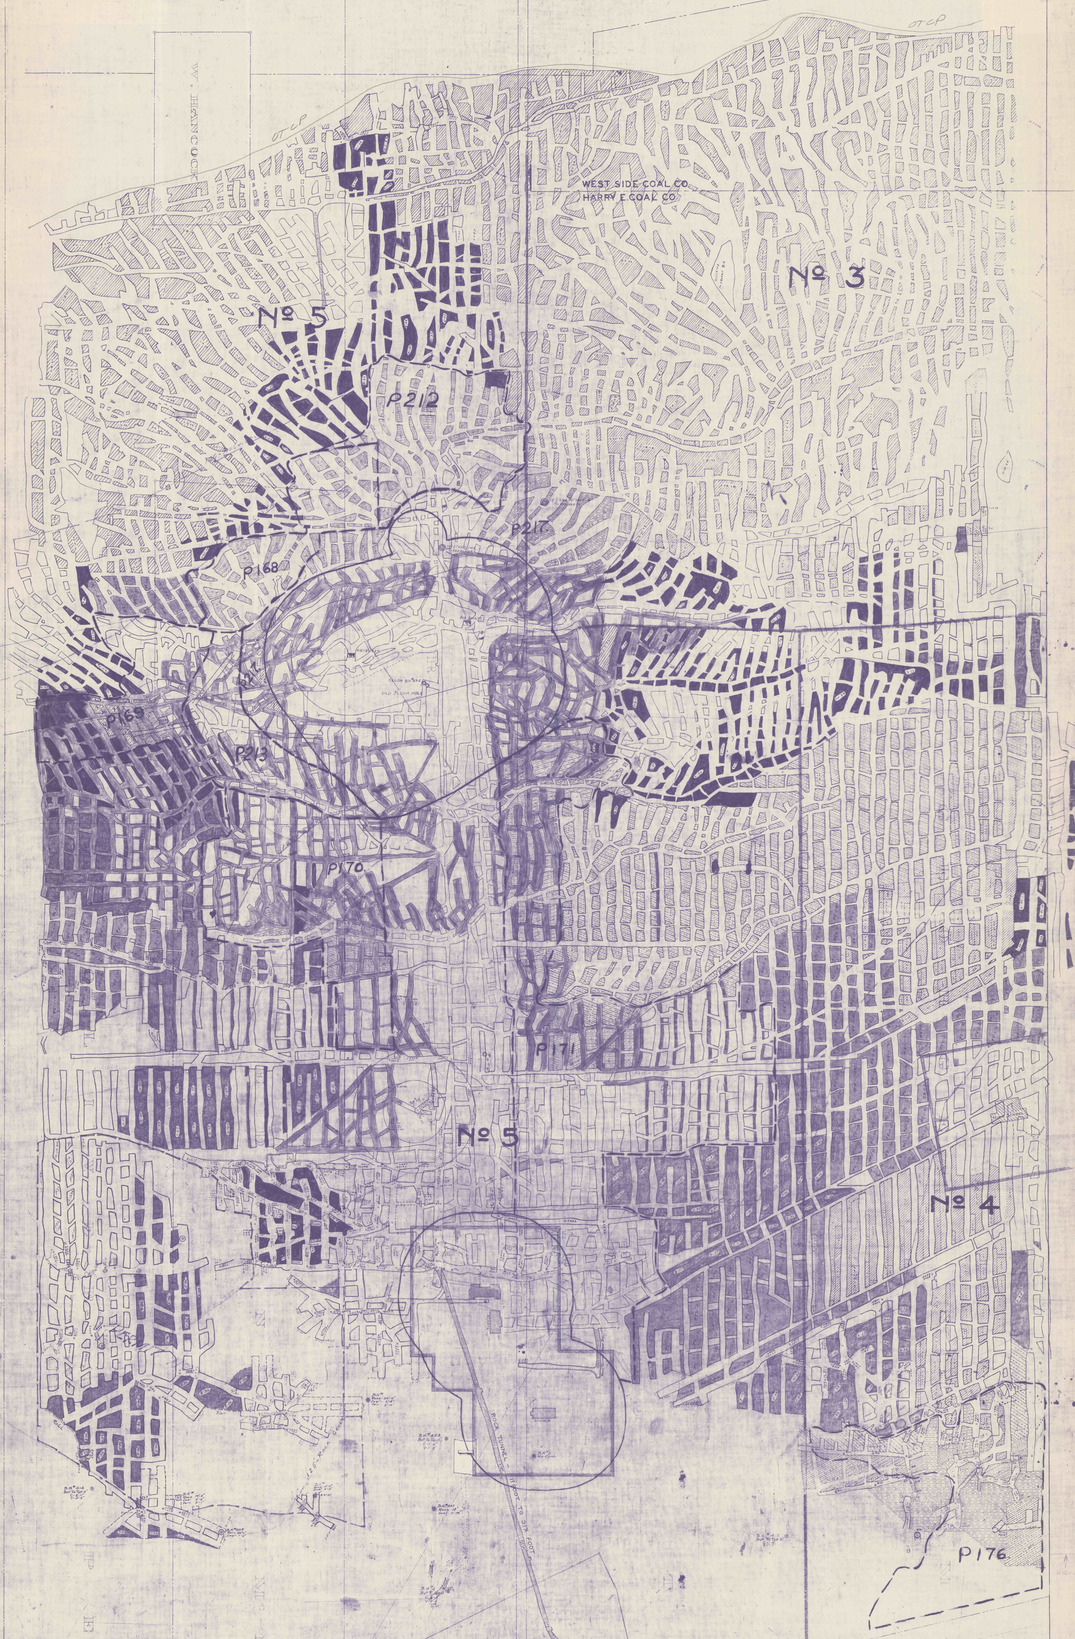
WEST SIDE COAL CO.
HARRY E. COAL CO.
No 3
No 5
P212
P217
P168
P169
P213
P170
P171
No 5
No 4
P176