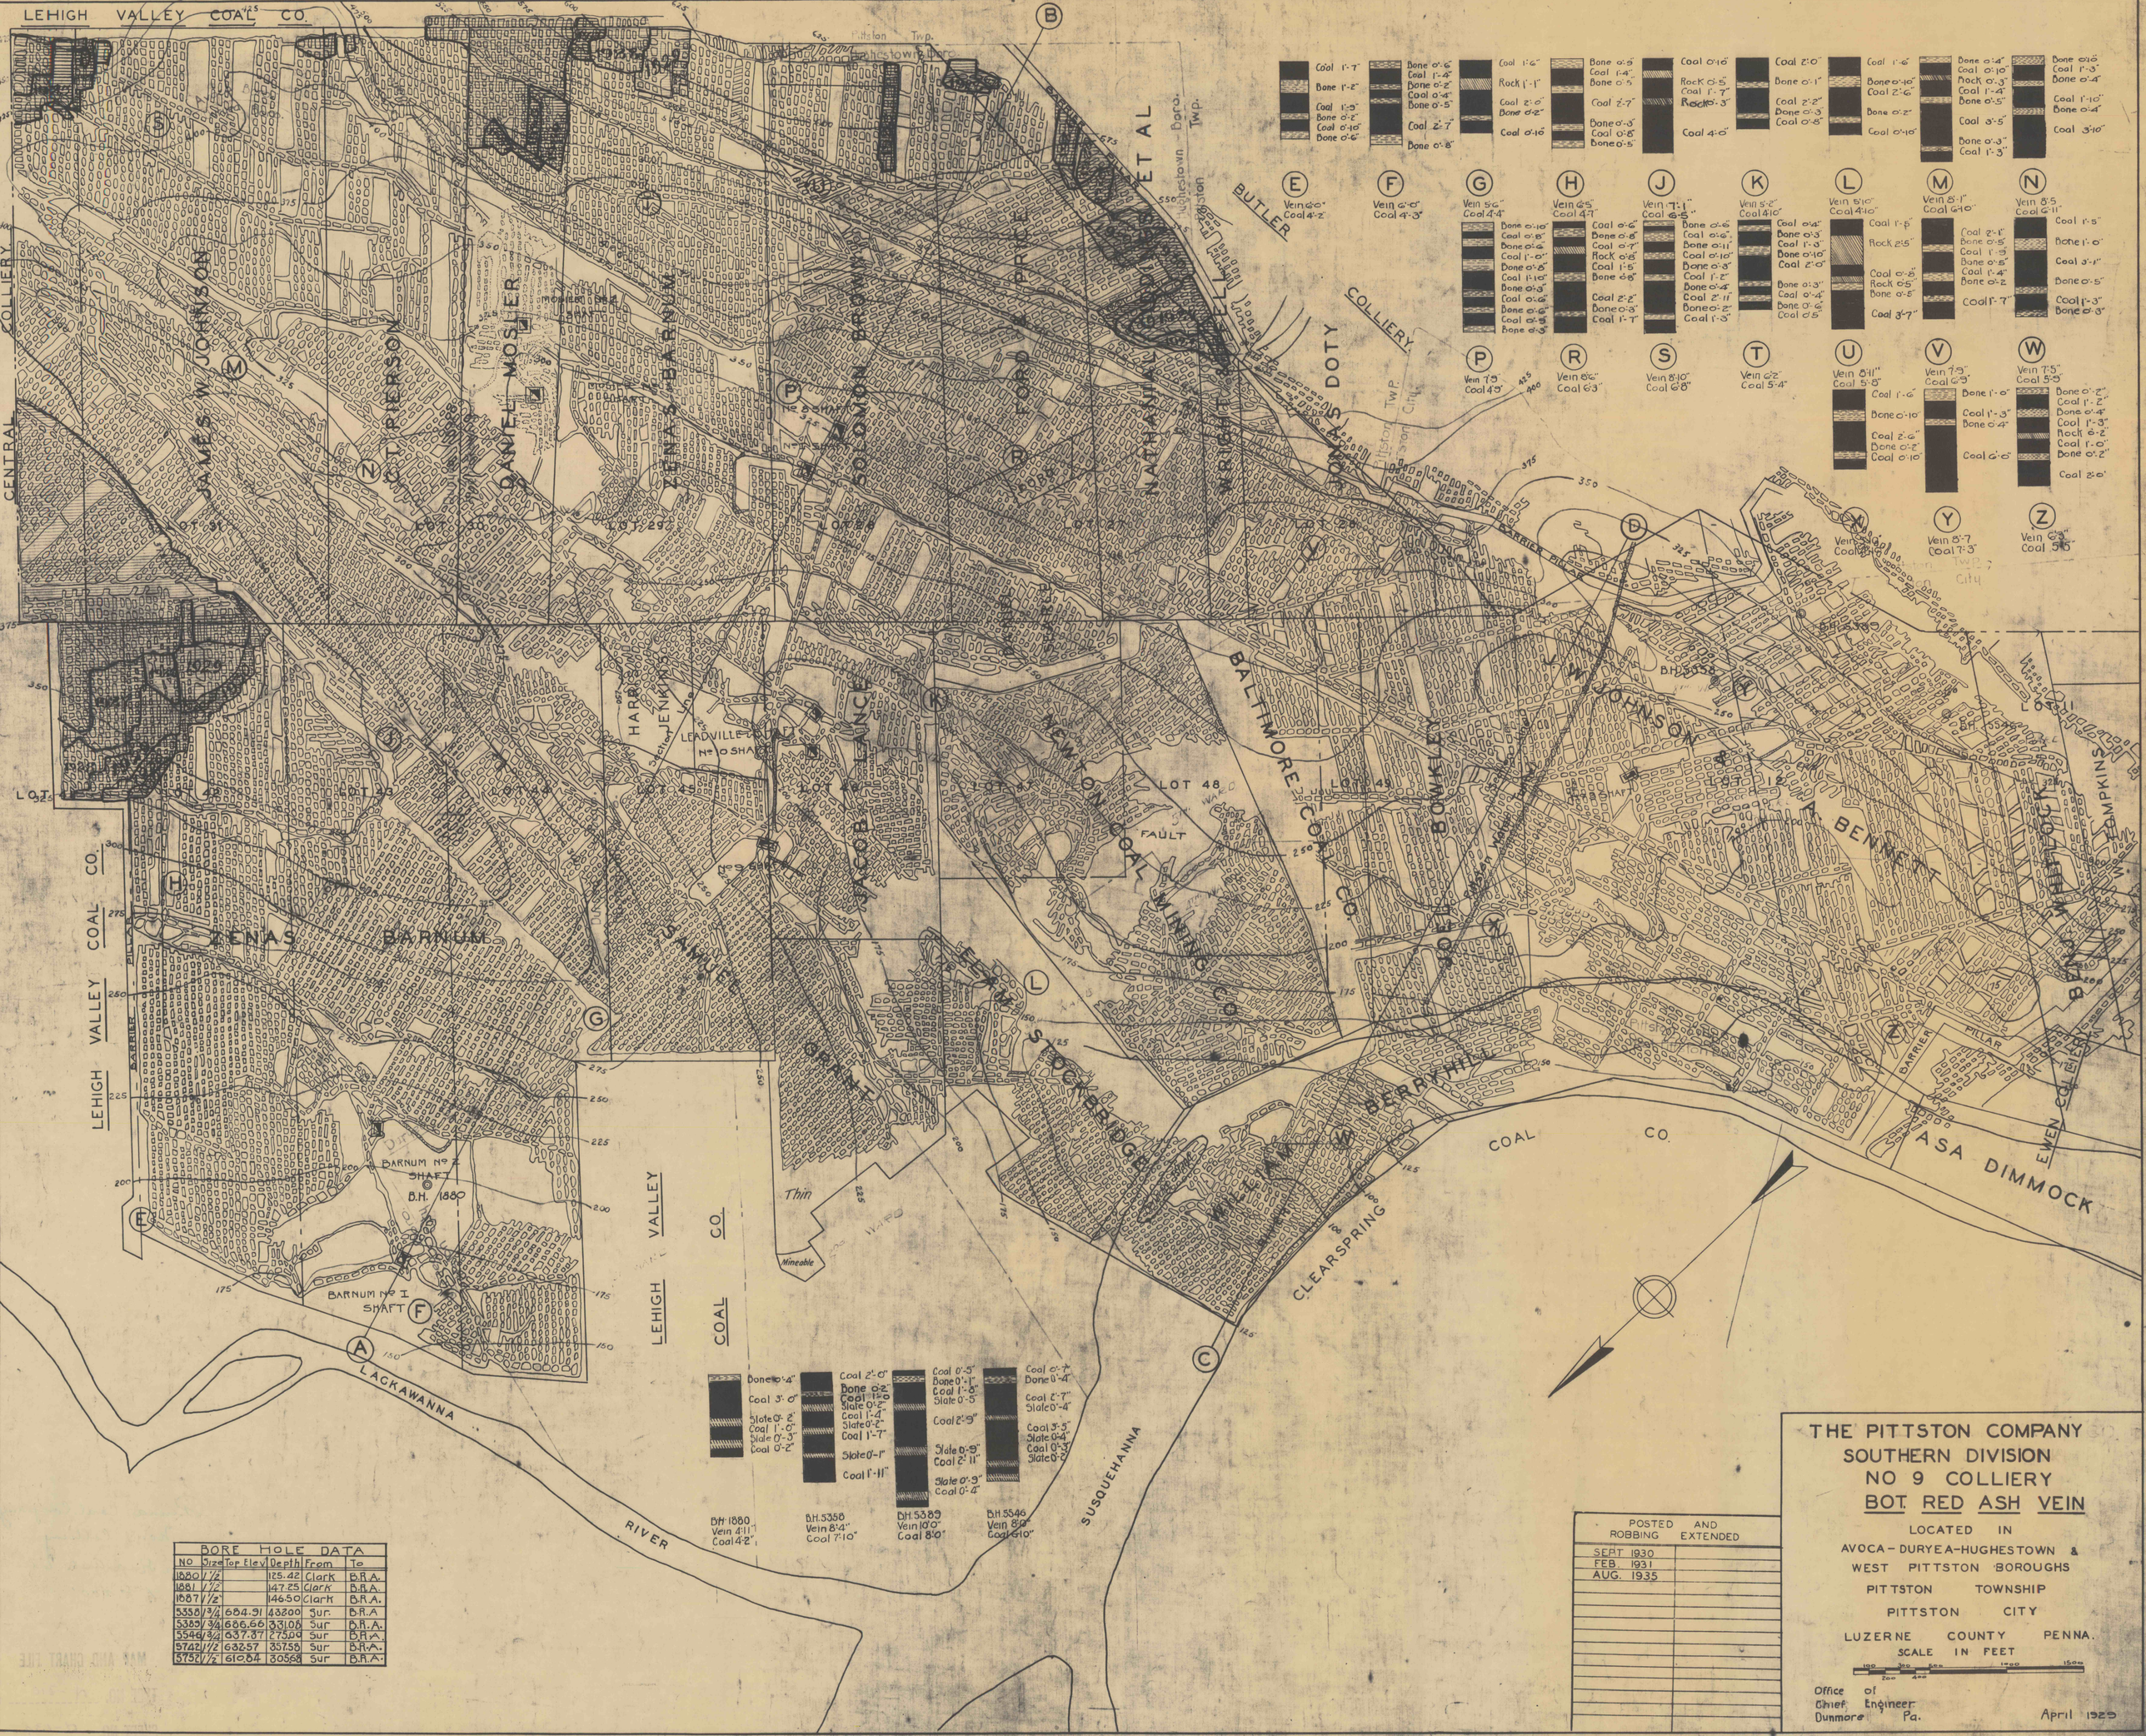

BORE HOLE DATA					
NO	Size	Top Elev	Depth	From	To
1880	1 1/2		125.42	Clark	B.R.A.
1881	1 1/2		147.25	Clark	B.R.A.
1887	1 1/2		146.50	Clark	B.R.A.
5358	1 3/4	684.91	43200	Sur.	B.R.A
5389	1 3/4	686.66	33108	Sur	B.R.A.
5346	1 3/4	637.37	27304	Sur	B.R.A.
5742	1 1/2	632.57	35758	Sur	B.R.A.
5752	1 1/2	610.84	30568	Sur	B.R.A.

POSTED AND ROBBING	EXTENDED
SEPT 1930	
FEB. 1931	
AUG. 1935	

THE PITTSTON COMPANY
SOUTHERN DIVISION
NO 9 COLLIERY
BOT. RED ASH VEIN

LOCATED IN
AVOCA - DURYEA - HUGHESTOWN &
WEST PITTSTON BOROUGHS
PITTSTON TOWNSHIP
PITTSTON CITY
LUZERNE COUNTY PENNA.

SCALE IN FEET

Office of Chief Engineer
Dunmore Pa.

April 1929