


No size		Top Elev		Bore		Hole		No size		Top Elev		Depth		From To	
1606	3"	1149	1700	1505	8	M	R	A	1178	8	178	1	487	01	1480
1565	3"	371	56	302	2	B	R	A	519	1	383	8	373	5	1480
1538	1"	154	84	299	2	B	R	A	1590	0	1455	0	373	5	1480
1535	1"	120	19	175	0	B	R	A	1881	1	305	0	373	5	1480
1528	1"	108	72	141	1	B	R	A	1878	1	319	0	373	5	1480
1513	1"	373	81	154	0	M	R	A	1875	1	1075	0	373	5	1480
1442	1"	288	23	184	4	B	R	A	1875	1	1273	0	373	5	1480
1401	1"	262	15	158	3	B	R	A	1868	1	1273	0	373	5	1480
1375	1"	501	60	167	5	M	R	A	1866	1	1273	0	373	5	1480
1325	1"	22	140	825	2	B	R	A	1894	1	1250	0	373	5	1480
1273	1"	339	14	406	5	B	R	A	1829	1	1250	0	373	5	1480
1009	1"	553	55	163	3	M	R	A	1786	1	141	6	141	6	1480
893	1"	481	34	146	5	M	R	A	1577	1	1592	0	141	6	1480
DATA		DATA		DATA		DATA		DATA		DATA		DATA		DATA	

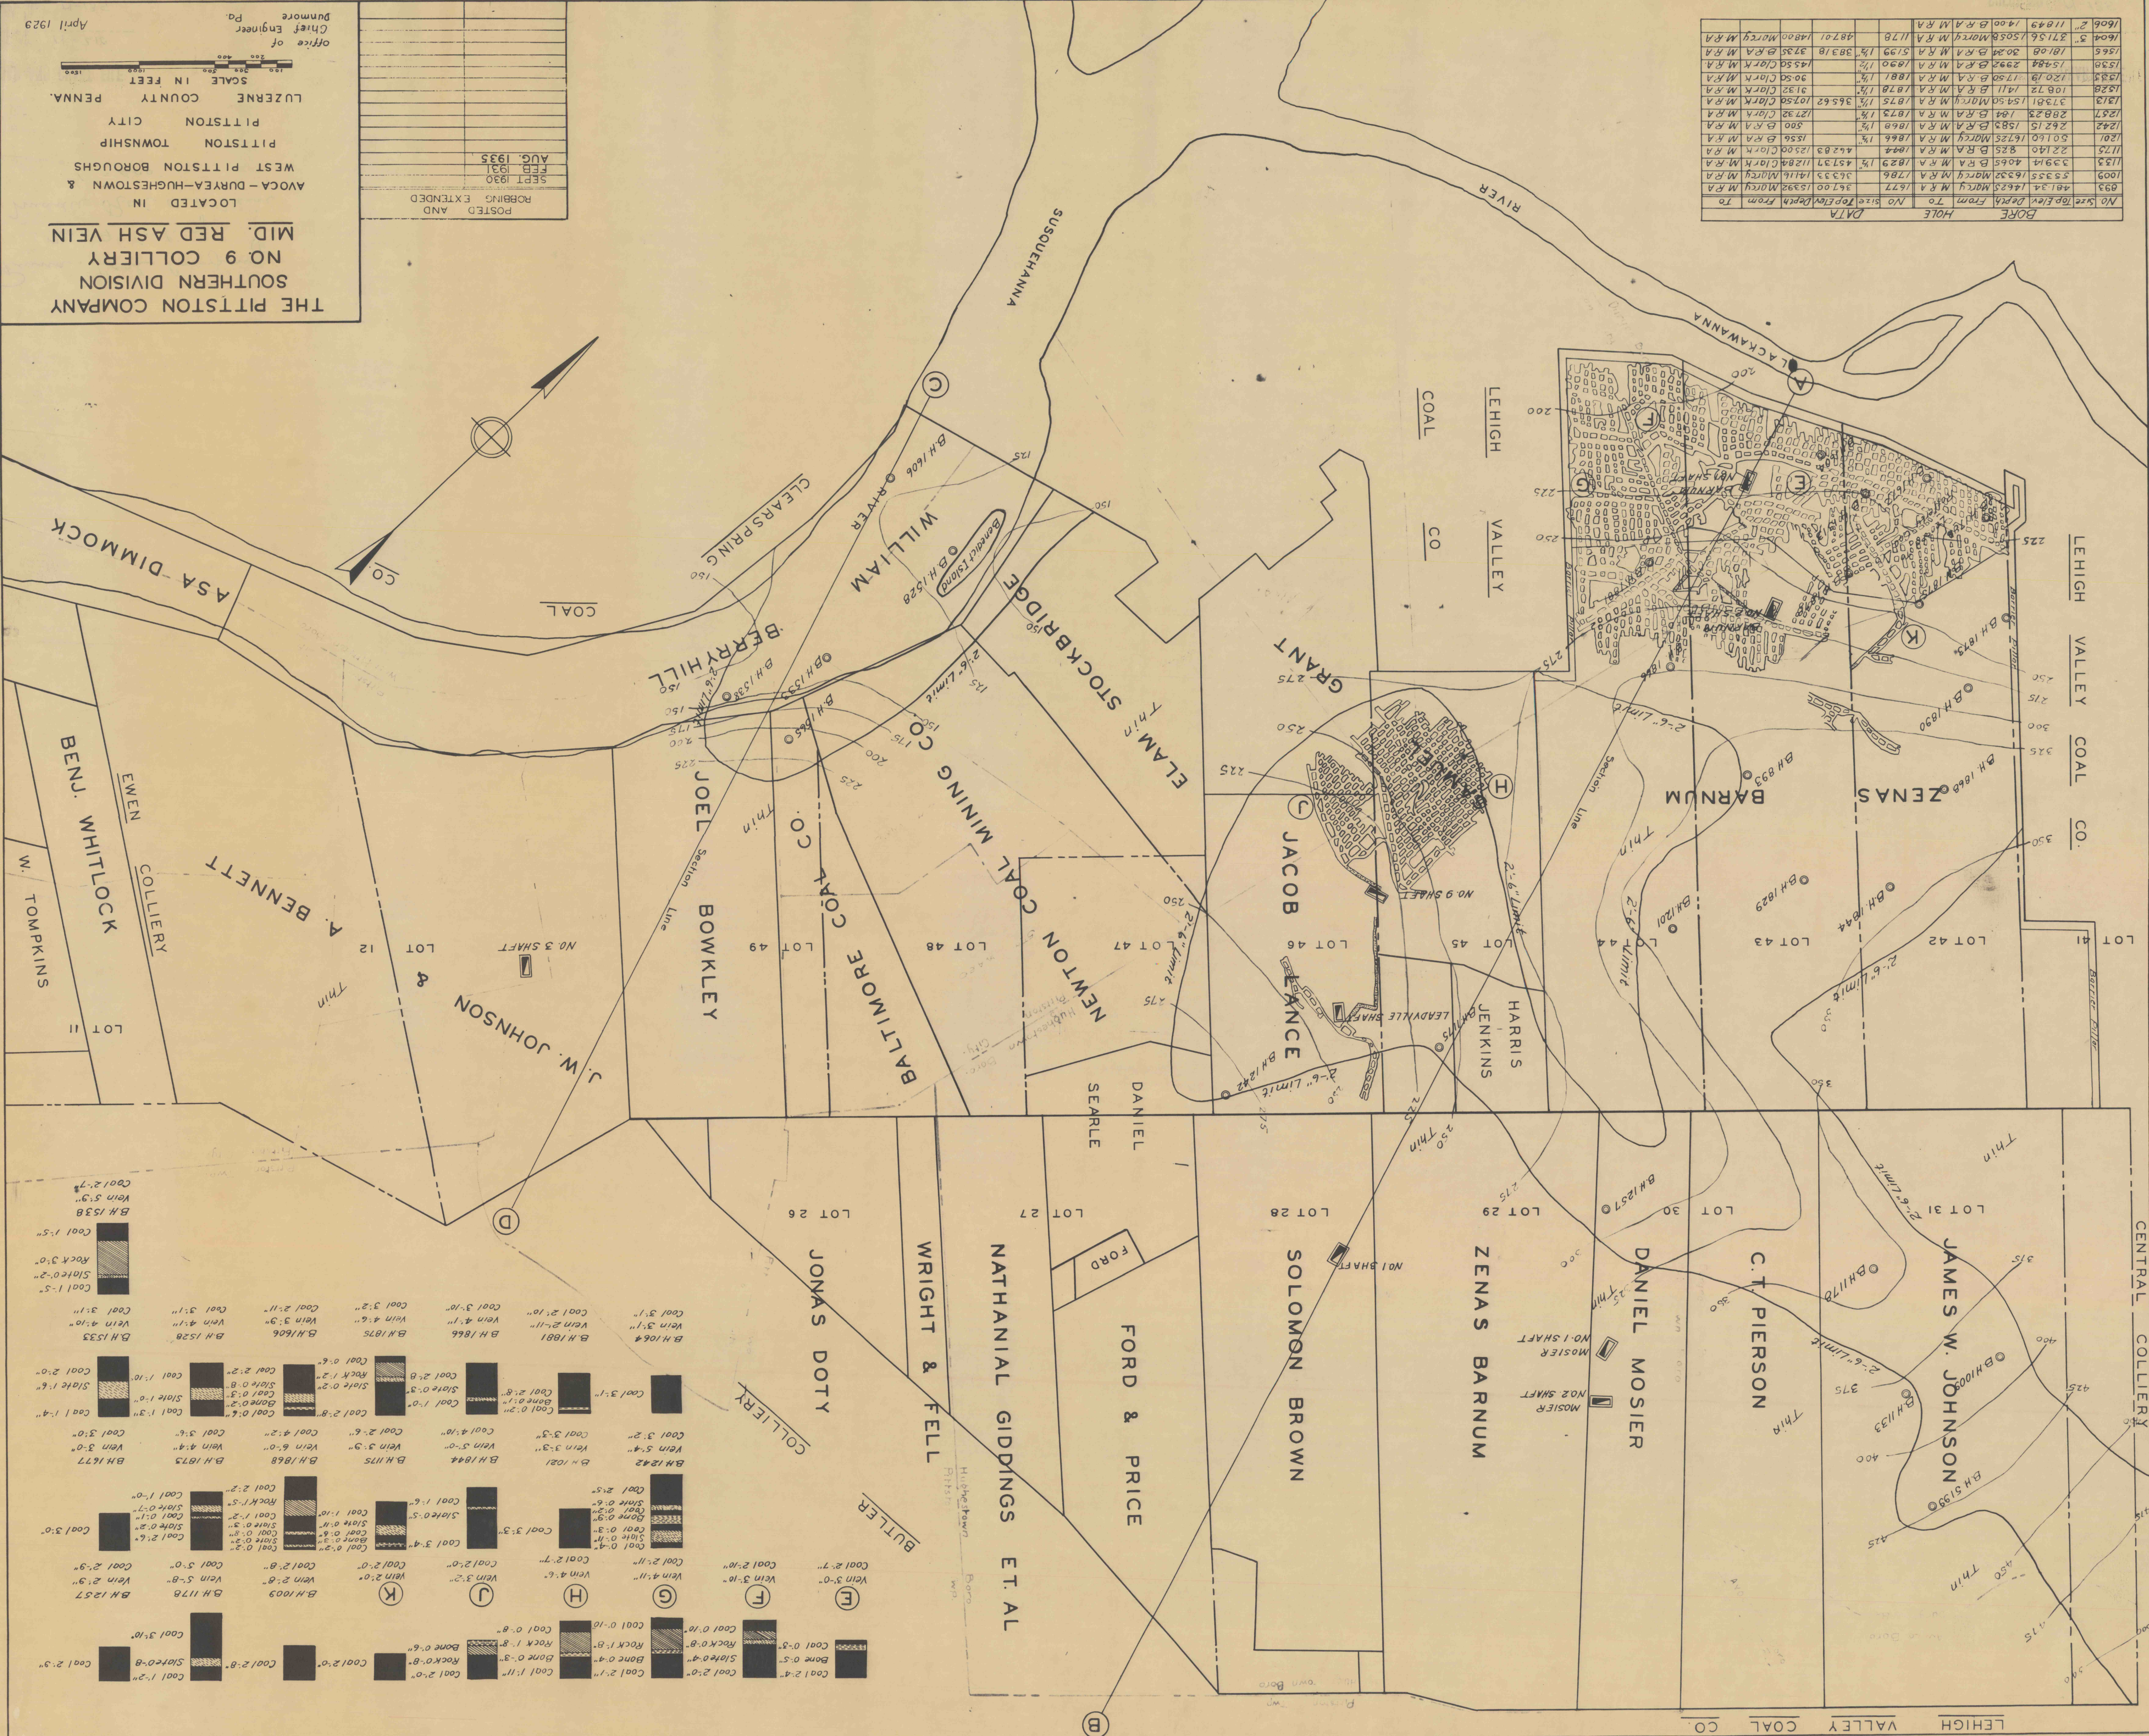

SOUTHERN DIVISION
NO. 9 COLLIERY
MID. RED ASH VEIN
LOCATED IN
AVOCA - DUREA - HUGHSTOWN &
PENNA.
SCALE IN FEET
100 200 300 400
Office of
Chief Engineer
April 1923

SEPT 1930	POSTED AND
FEB 1931	ROBBING EXTENDED
AUG. 1935	