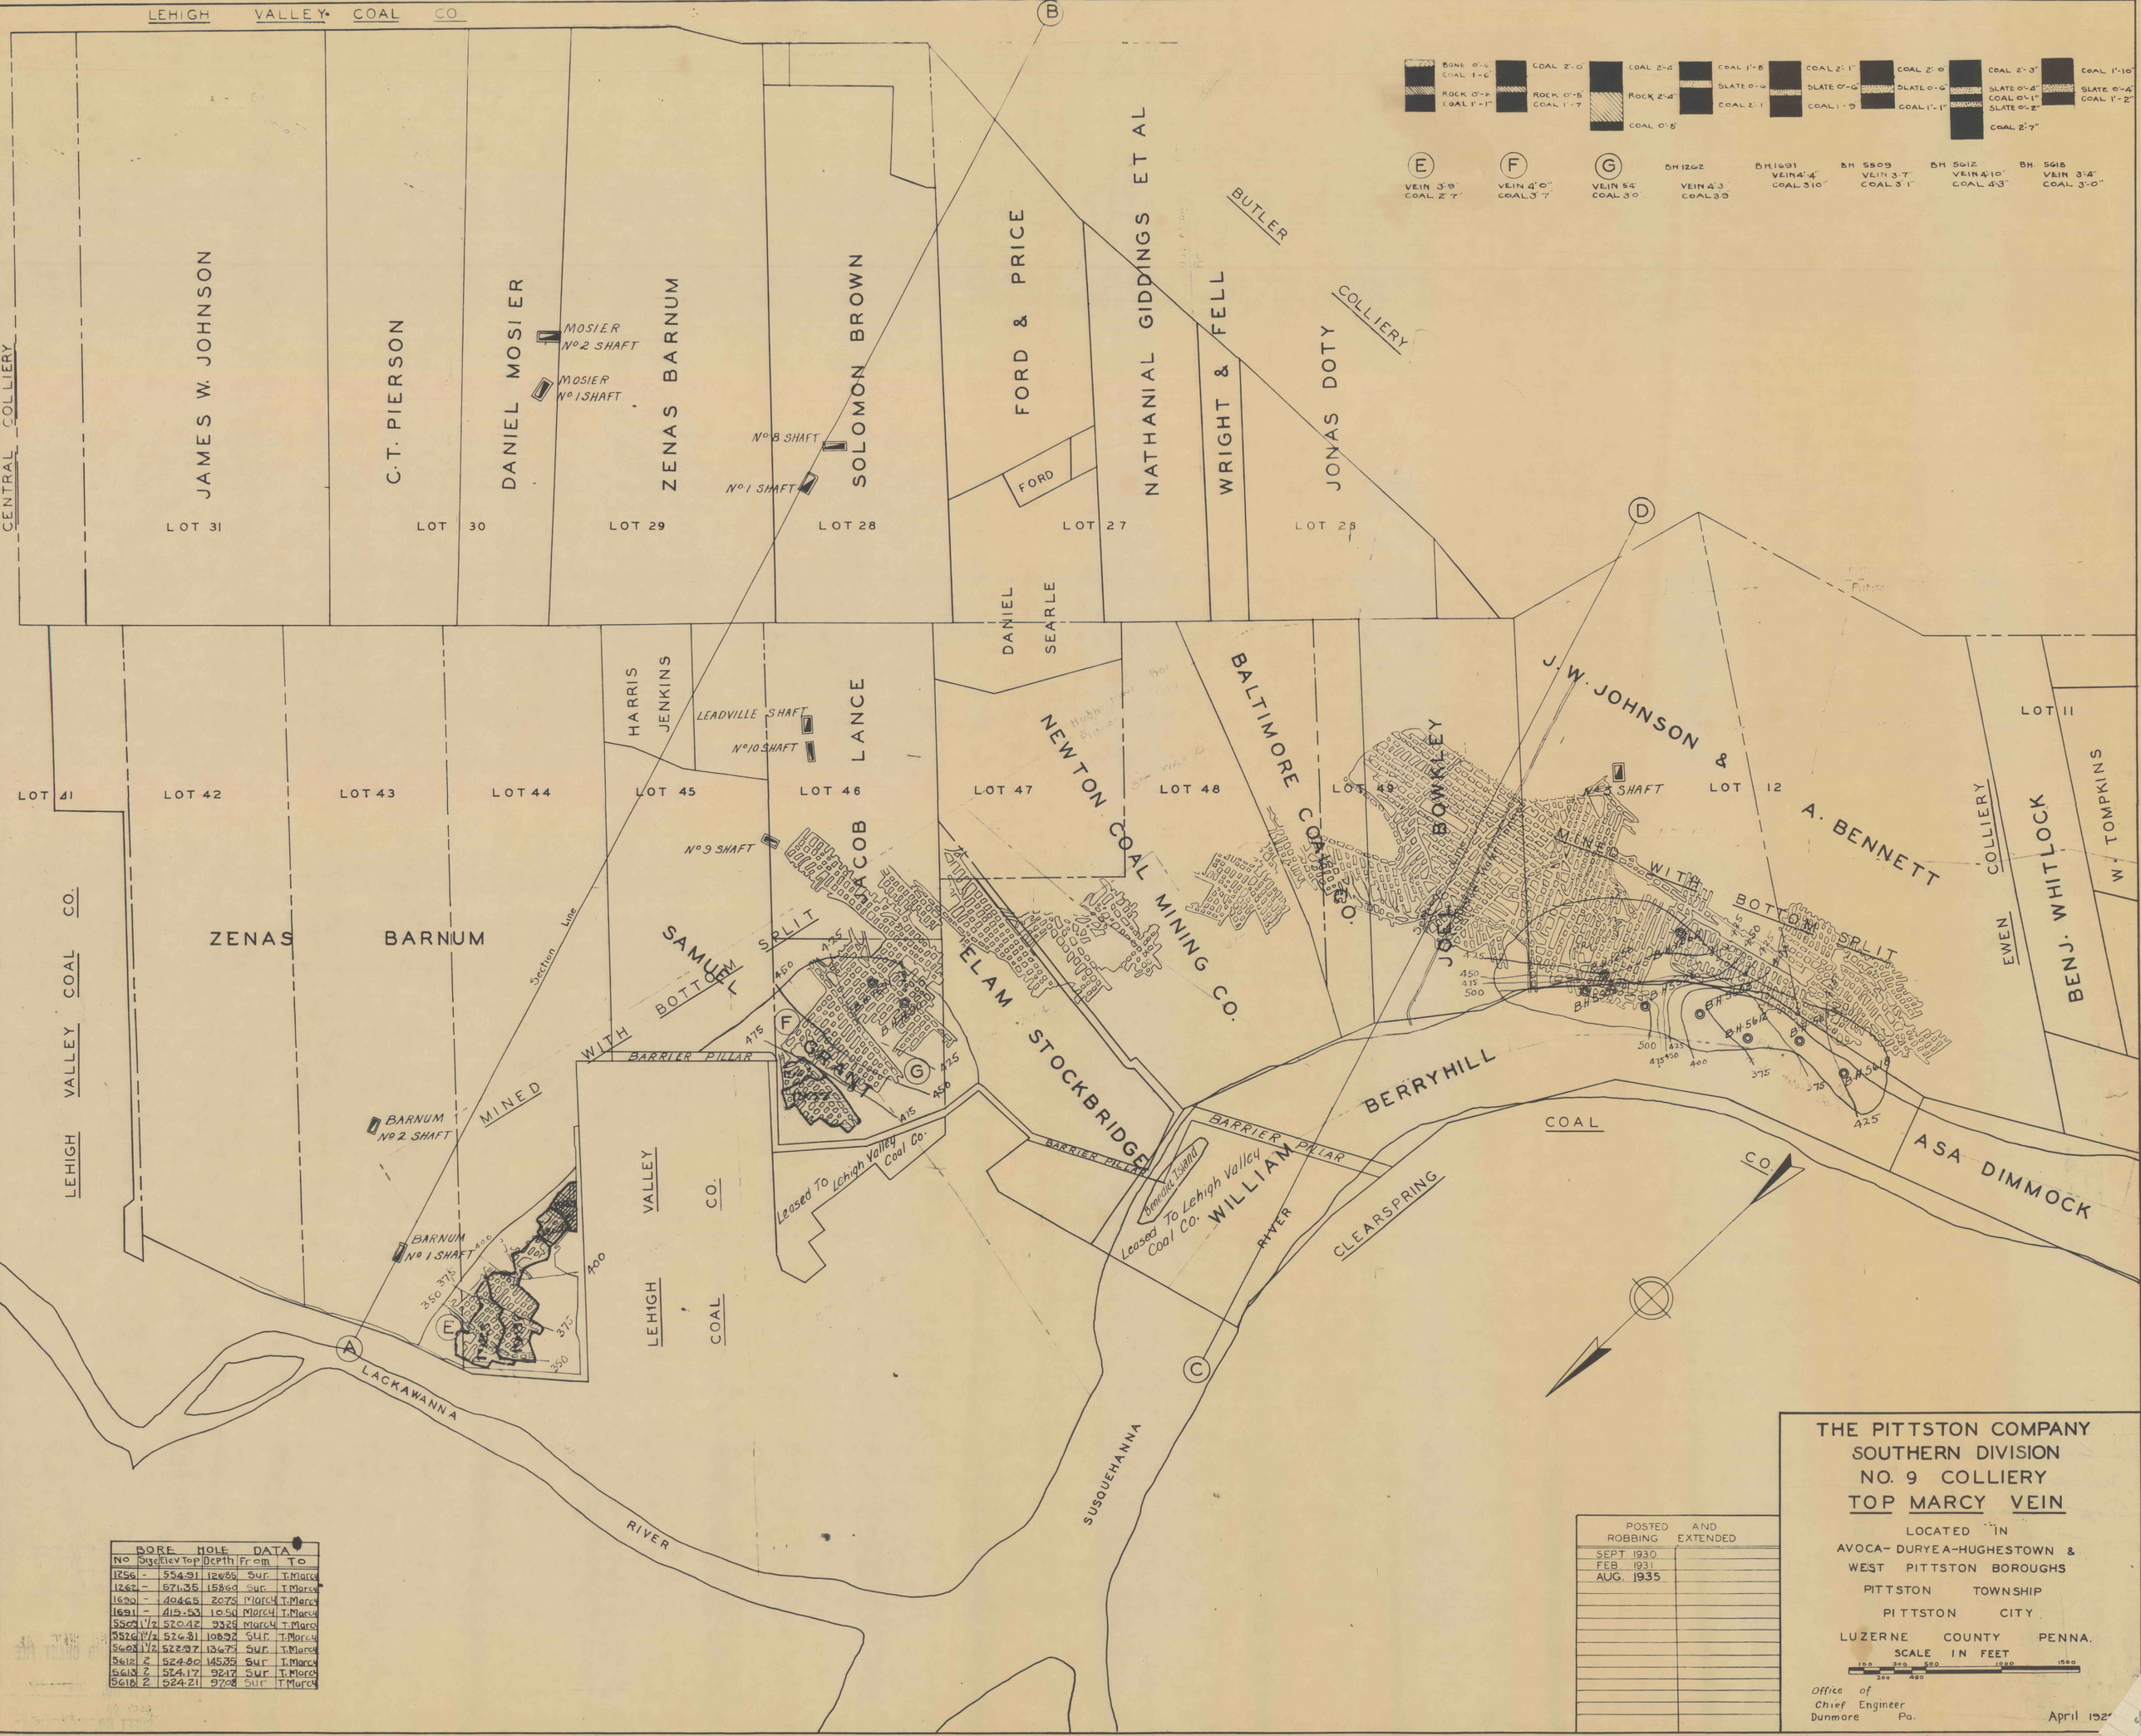

BORE HOLE DATA					
No	Size	Elev Top	Depth	From	To
1256	-	554.91	1268.5	Sur.	T. Marcy
1262	-	571.35	1586.0	Sur.	T. Marcy
1690	-	404.65	207.8	Marcy	T. Marcy
1691	-	415.53	109.4	Marcy	T. Marcy
5509	1 1/2	520.42	93.25	Marcy	T. Marcy
5576	1 1/2	526.81	108.92	Sur.	T. Marcy
5605	1 1/2	522.97	136.75	Sur.	T. Marcy
5612	2	524.80	145.35	Sur.	T. Marcy
5613	2	574.17	92.17	Sur.	T. Marcy
5618	2	524.21	97.08	Sur.	T. Marcy

POSTED AND ROBBING	EXTENDED
SEPT 1930	
FEB 1931	
AUG. 1935	

THE PITTSTON COMPANY
SOUTHERN DIVISION
NO. 9 COLLIERY
TOP MARCY VEIN

LOCATED IN
AVOCA-DURYEA-HUGHESTOWN & WEST PITTSTON BOROUGHS
PITTSTON TOWNSHIP
PITTSTON CITY
LUZERNE COUNTY PENNA.

SCALE IN FEET
100 200 300 400 500 1000 1500

Office of Chief Engineer
Dunmore Pa.

April 192