

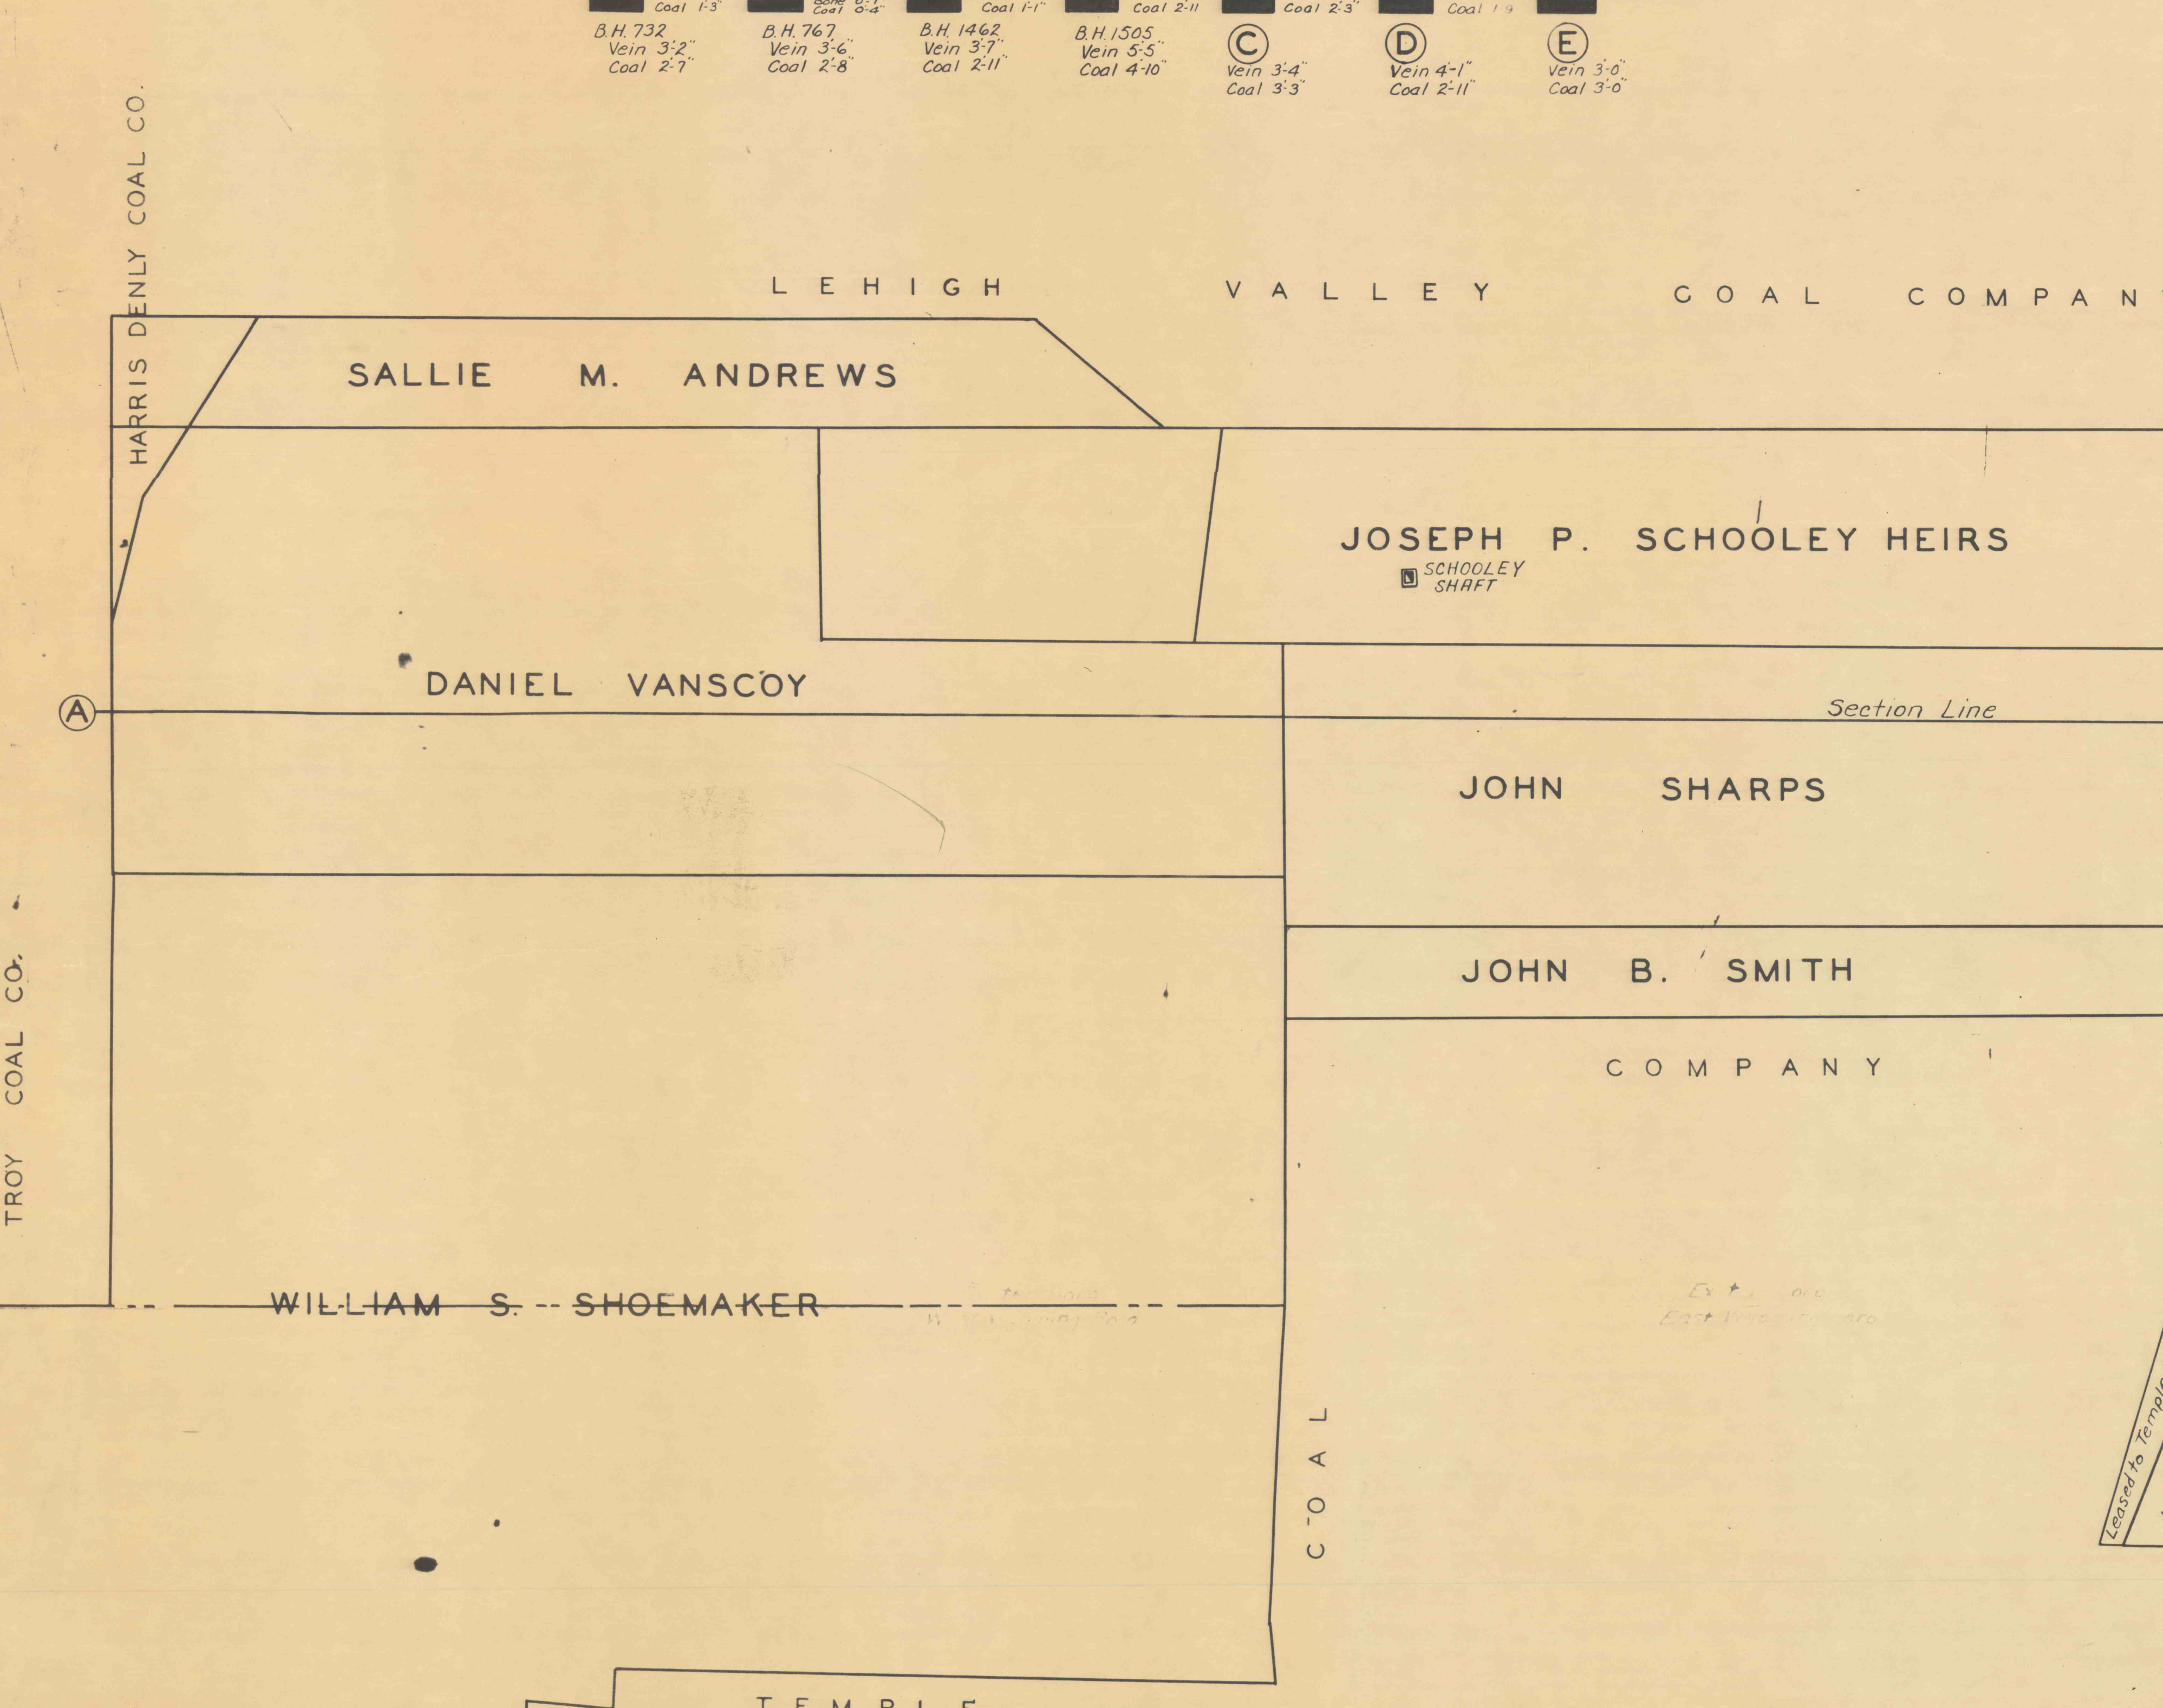


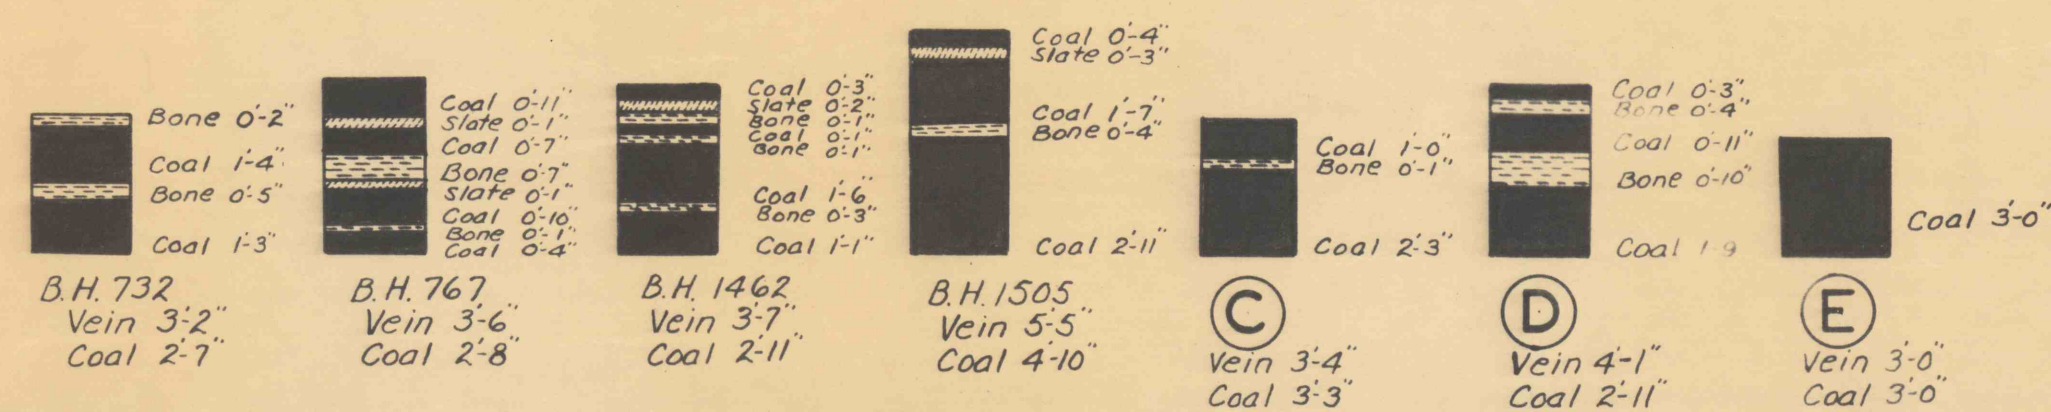

BORE HOLE DATA									

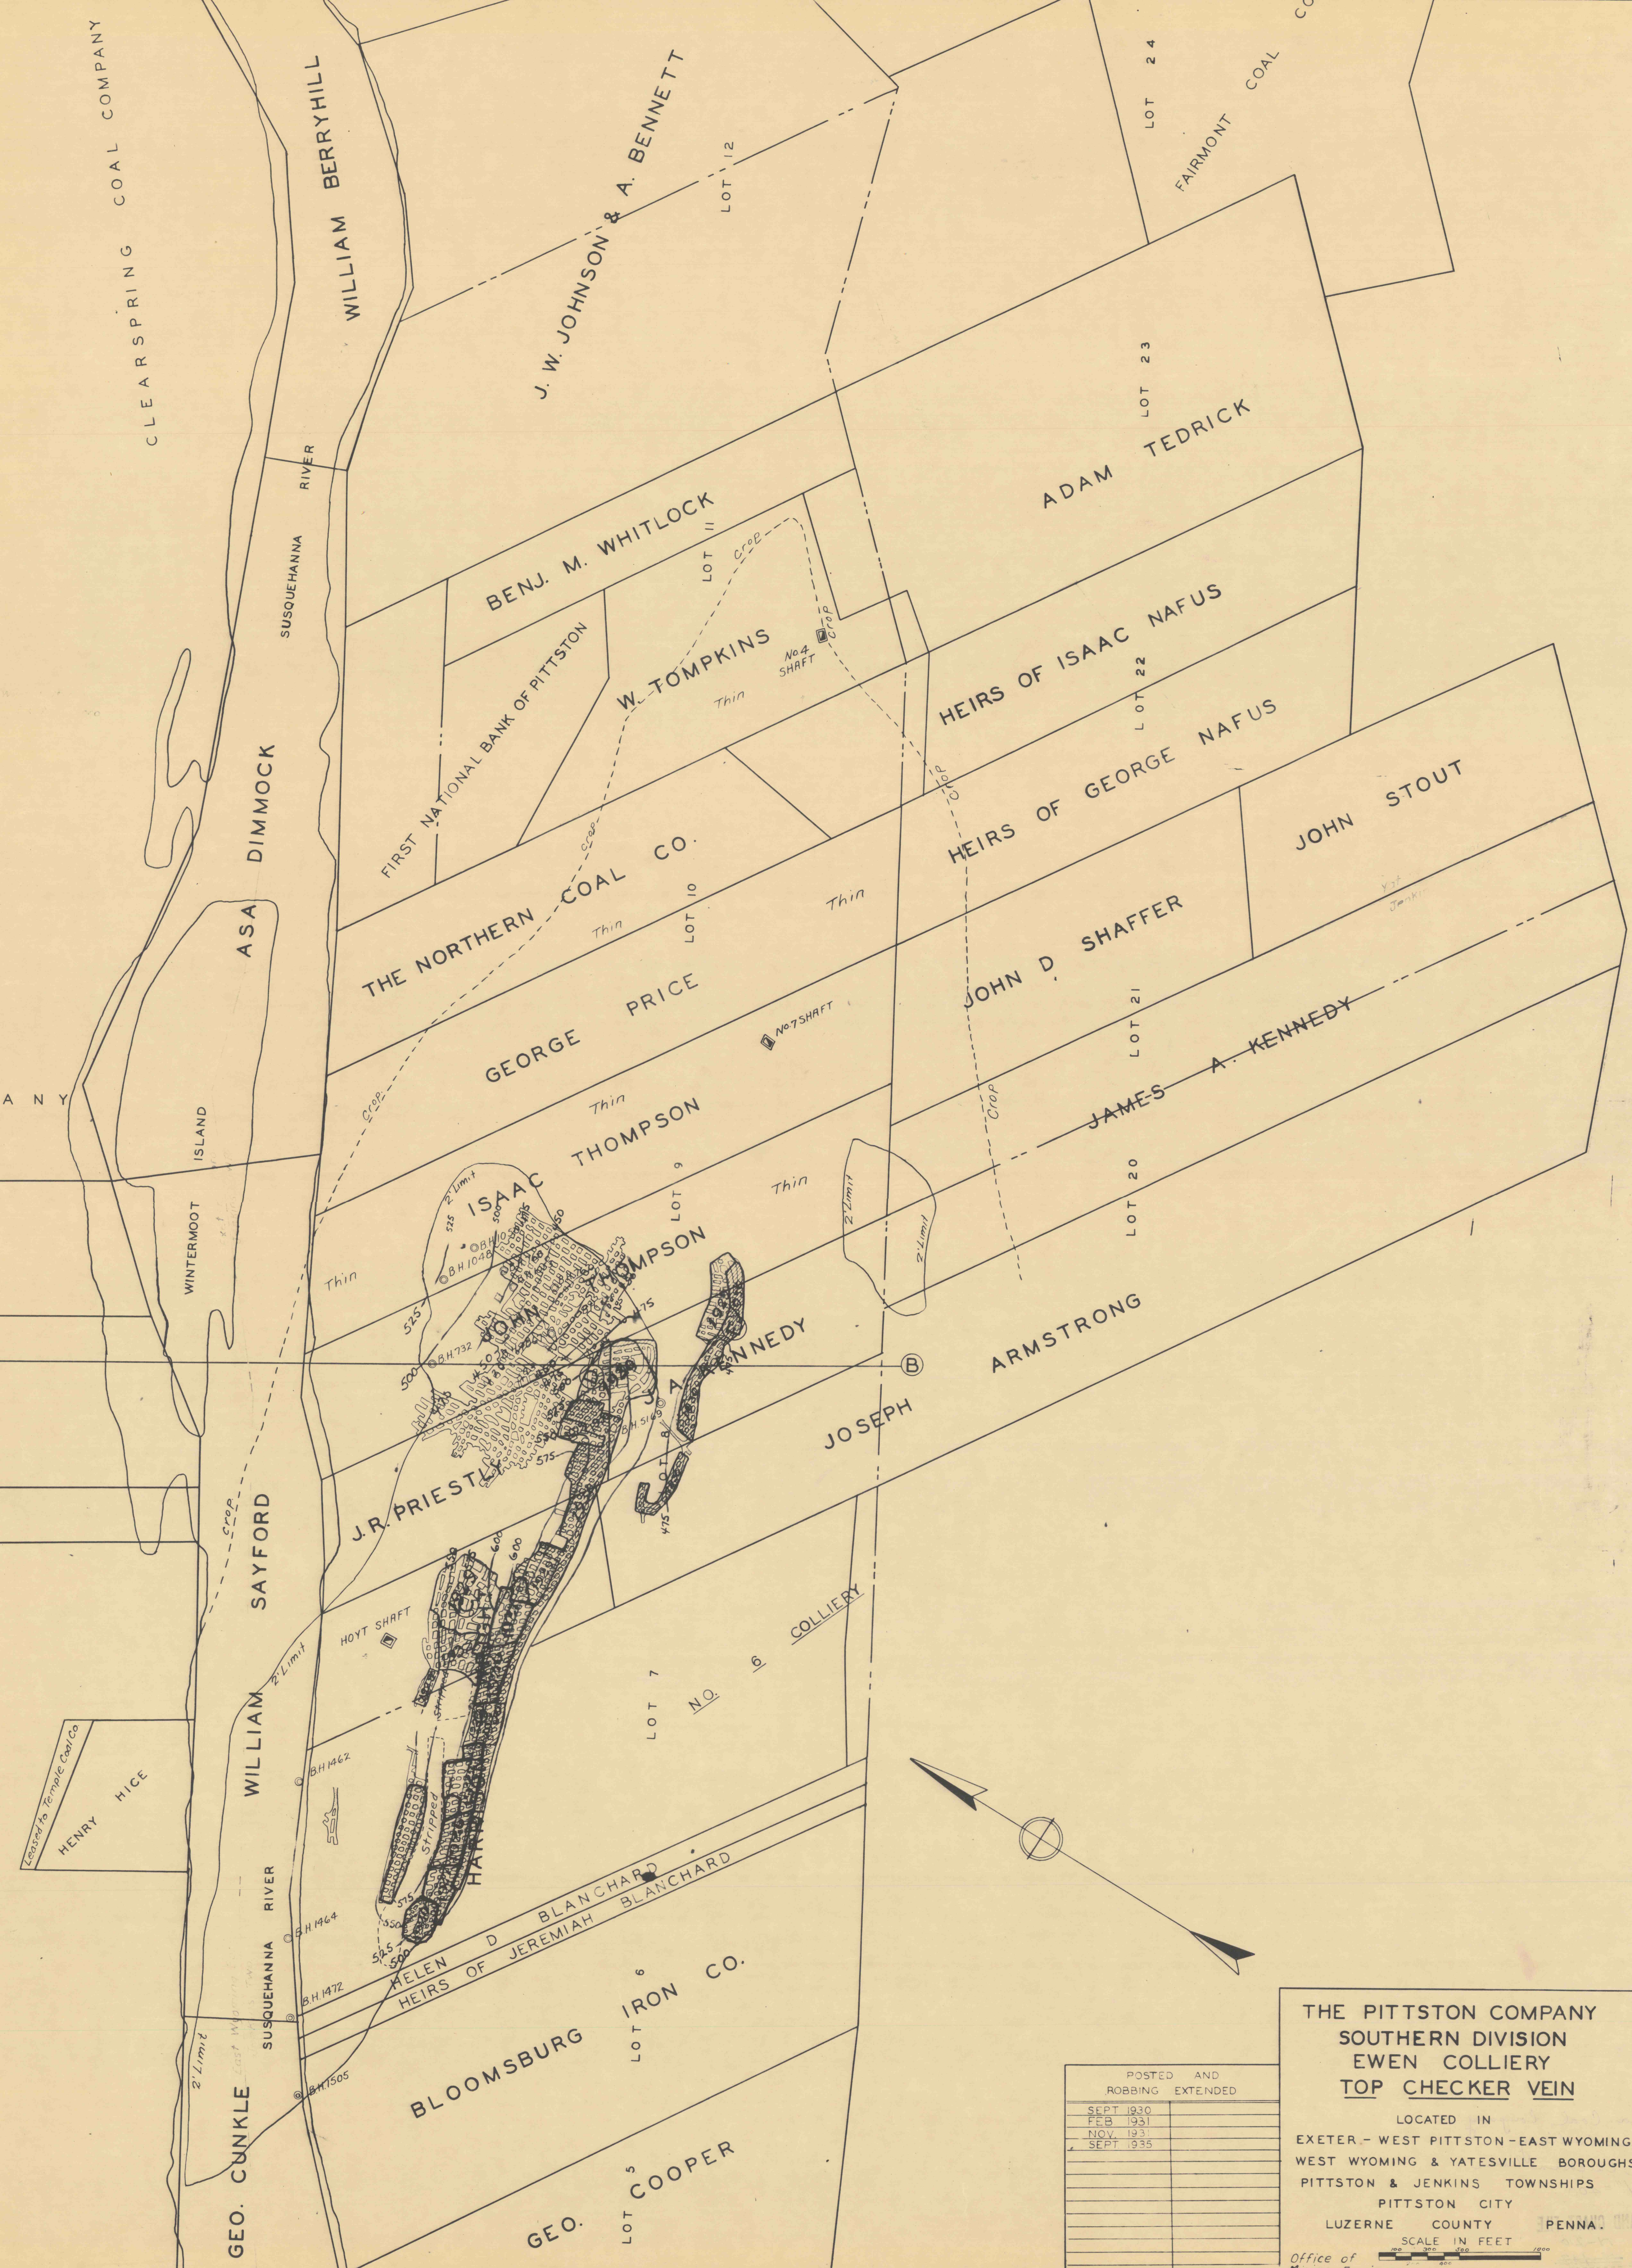

POSTED AND ROBBING EXTENDED	
SEPT 1930	
FEB 1931	
NOV 1931	
SEPT 1935	

SOUTHERN DIVISION
EWEN COLLIERY
TOP CHECKER VEIN

LOCATED IN
EXETER - WEST PITTSBURGH - EAST WYOMING
WEST WYOMING & YATESVILLE BOROUGH
PITTSBURGH & JENKINS TOWNSHIPS
PITTSBURGH CITY
LUZERNE COUNTY PENNSYLVANIA

Office of
Mining Engineer
Dunmore Pa.

Feb 1929