
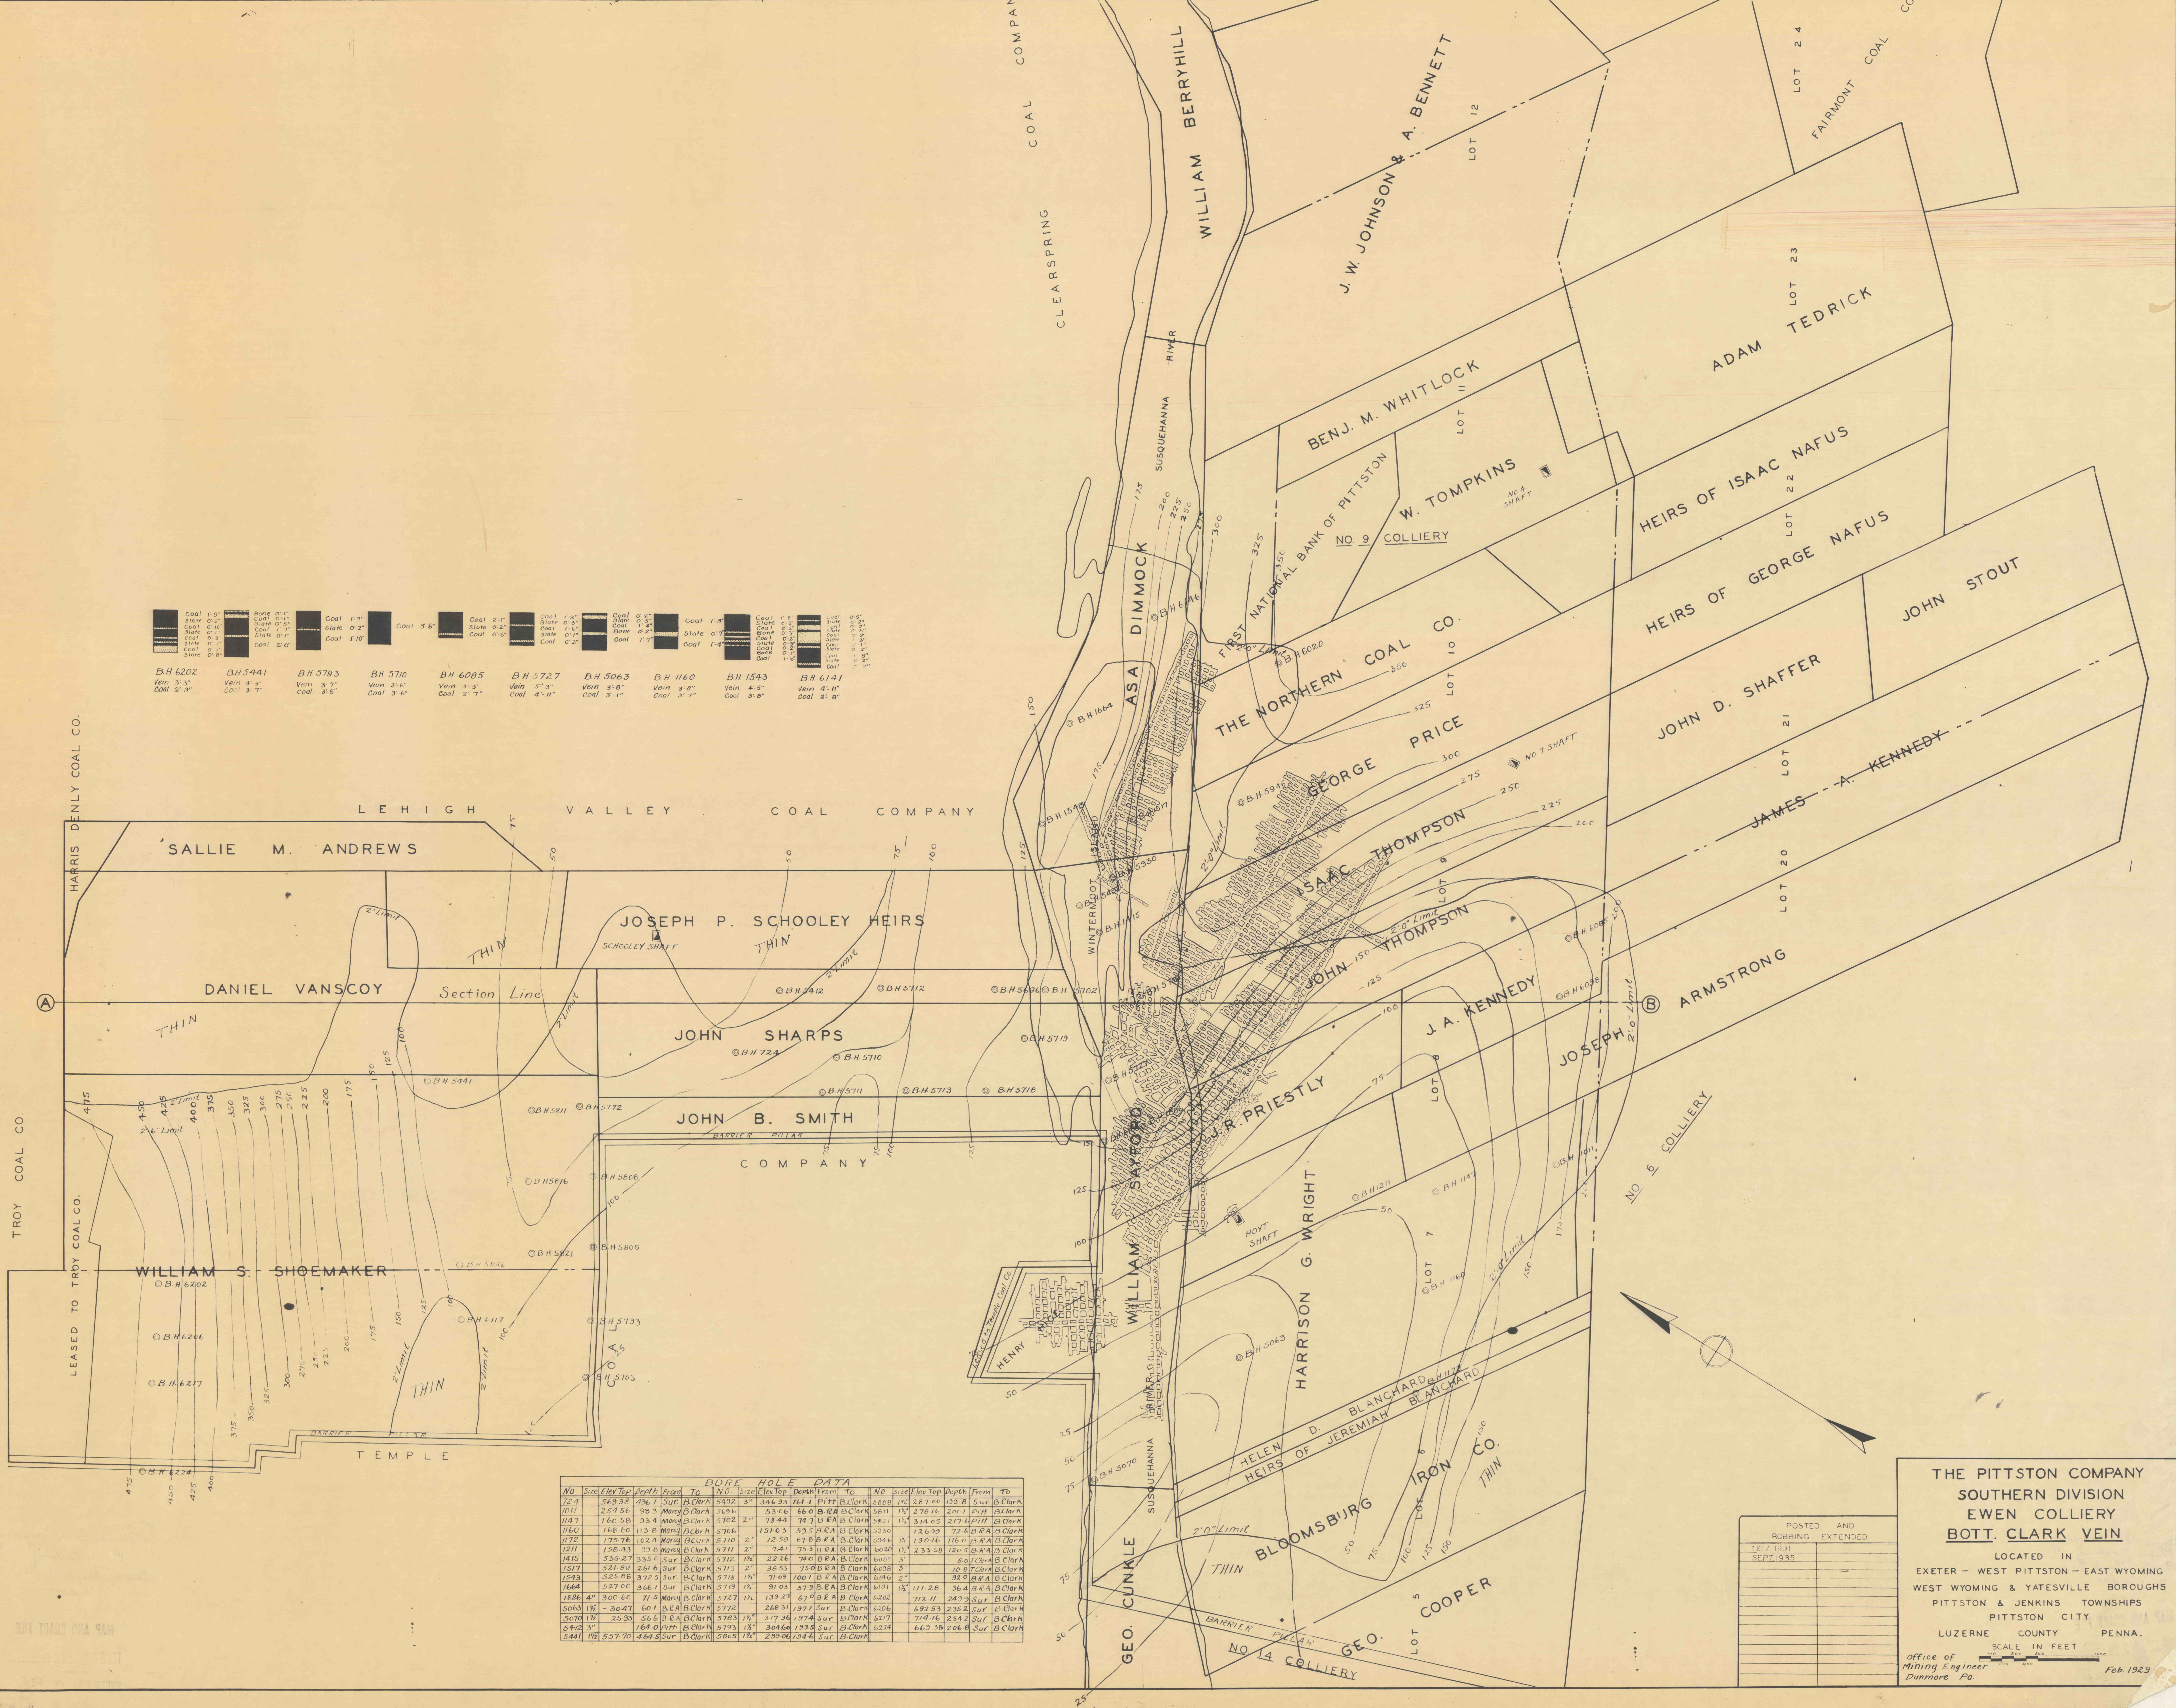


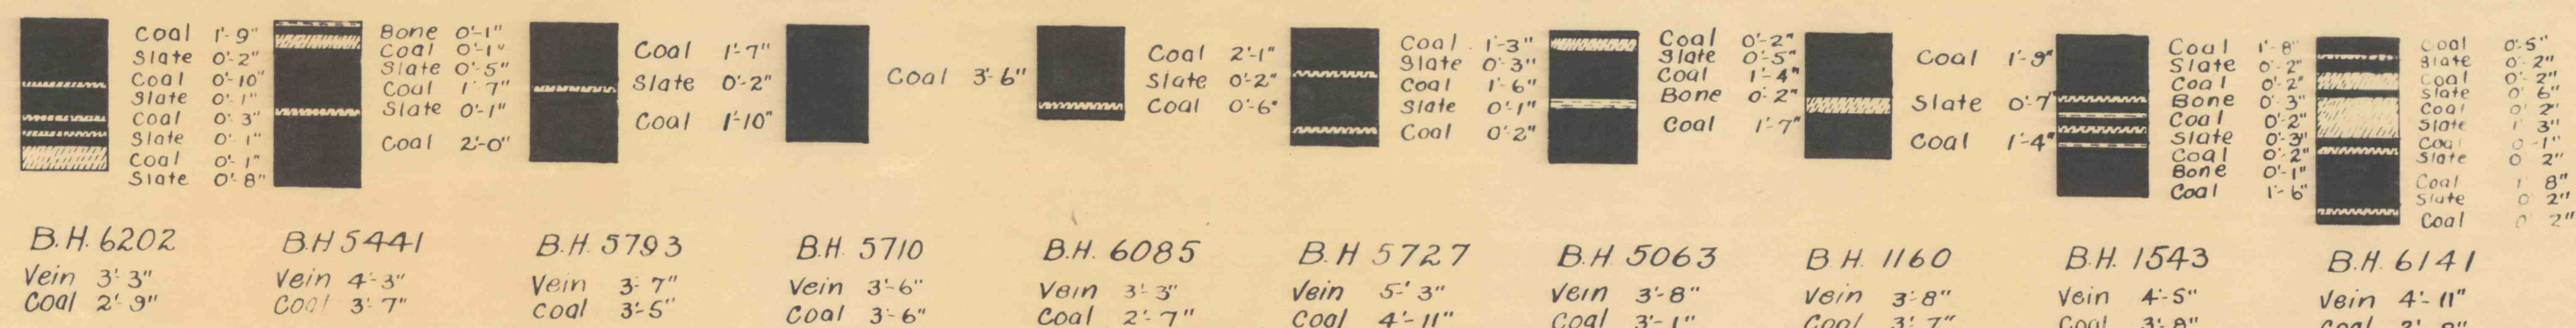

BORE HOLE DATA												
No.	Size	Elev.Top	Depth	From	To	No.	Size	Elev.Top	Depth	From	To	
124	569.32	496.1	Sur.	B. Clark	5492	3"	346.93	161.1	Sur.	B. Clark	5811	
1011	254.56	38.3	Wend.	B. Clark	5684	53.06	46.0	B. Clark	5811	1716.16	211.1	
1147	146.56	33.4	Wend.	B. Clark	5702	2"	78.46	74.7	B. Clark	5811	211.1	
1160	168.66	113.8	Marq.	B. Clark	5706	151.63	55.5	B. Clark	5811	124.29	72.6	
1172	175.76	162.4	Marq.	B. Clark	5710	2"	72.50	87.8	B. Clark	5946	11	
1211	158.43	35.8	Marq.	B. Clark	5711	2"	74.71	75.3	B. Clark	6020	15	
1815	335.27	335.6	Sur.	B. Clark	5712	1 1/2"	22.14	74.0	B. Clark	6020	3"	
1517	521.89	261.6	Sur.	B. Clark	5713	2"	38.53	75.0	B. Clark	6020	15	
1543	525.88	372.5	Sur.	B. Clark	5714	1 1/2"	71.09	100.1	B. Clark	6046	2"	
1644	327.00	366.7	Sur.	B. Clark	5715	1 1/2"	91.03	57.9	B. Clark	6046	2"	
1886	47	300.66	71.5	Wend.	B. Clark	5727	1 1/2"	33.28	67.4	B. Clark	6046	2"
5063	18	36.47	60.1	B. Clark	5729	268.31	197.1	Sur.	B. Clark	6202	69.23	
5070	18	25.93	56.6	B. Clark	5783	1 1/2"	317.34	197.4	Sur.	B. Clark	6202	69.23
5412	3"	164.0	117.1	B. Clark	5793	1 1/2"	304.66	193.3	Sur.	B. Clark	6202	69.23
5411	1 1/2"	557.70	464.3	Sur.	5805	1 1/2"	239.04	194.4	Sur.	B. Clark		

THE PITTSTON COMPANY
SOUTHERN DIVISION
EWEN COLLIERY
BOTT. CLARK VEIN

LOCATED IN
EXETER - WEST PITTSTON - EAST WYOMING
WEST WYOMING & YATESVILLE BOROUGHES
PITTSTON & JENKINS TOWNSHIPS
PITTSTON CITY
LUZERNE COUNTY PENNA.

Office of
Mining Engineer
Dunmore, Pa.

Feb. 1929