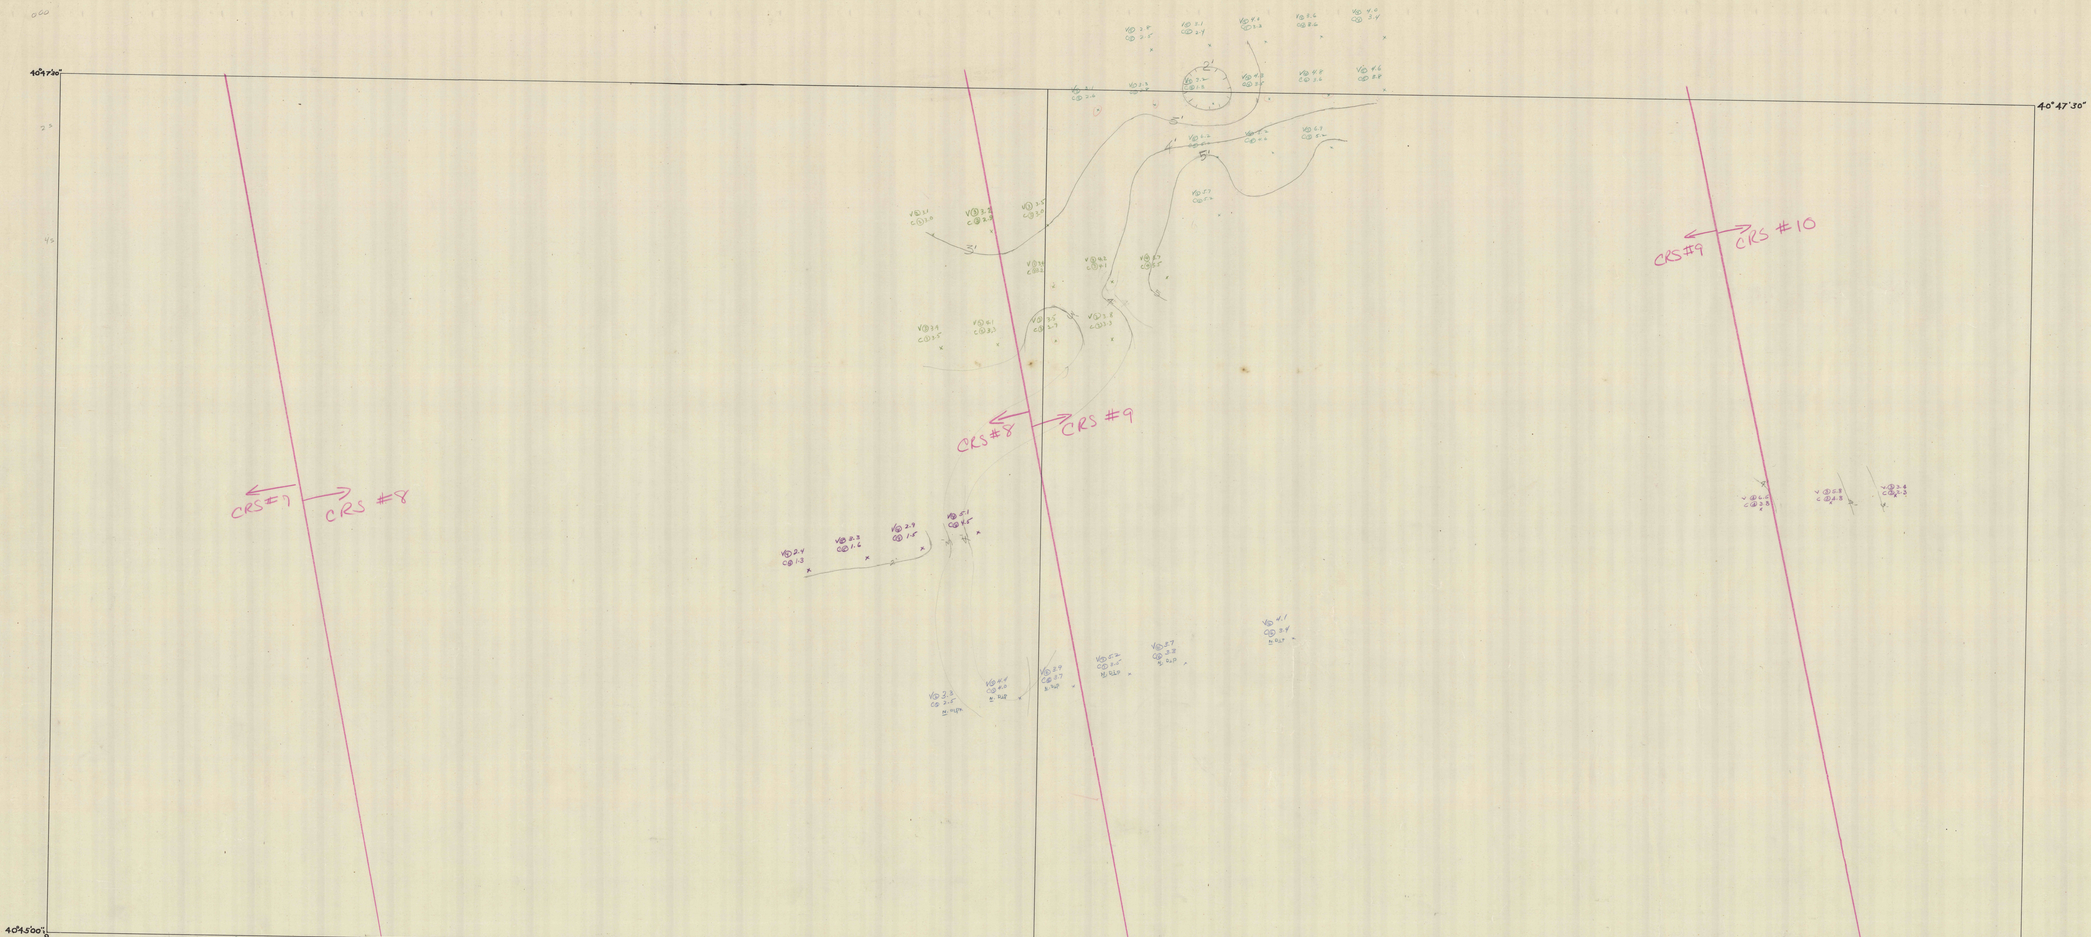

	No. of Holes	Avg. Thickness	Range Min	Range Max
V	8	3.4	8.1	1.8
C	8	2.4	6.1	1.0

	No. of Holes	Avg. Thickness	Range Min	Range Max
V	13	3.5'	8.1'	1.8'
C	13	2.8'	6.1'	0.5'

Revised 10/1/59

Colliery	Operator's	U.S.G.S.
Reliance	4 ft.	3½
Locust Gap	4 ft.	3½
Locust Spring	4 ft.	3½
Penn	3¾	3½
Potts	4 ft.	3½

	Average	Range
V (13)	4.3	6.7 3.3
C (13)	3.5	8.0 1.0

Summary for Mt Carmel SE @ 3½ Bed

	No. Holes	No. Observations	Average	Range
V.	23	87	4.5'	2.4'-12.2'
C.	23	87	3.7'	0.2'-9.9'

Colliery	Operator's	U.S.G.S.
Locust Gap	4 ft.	3½
Locust Spring	4 ft.	3½

Coal Thickness Sheet of Four Foot Vein (3½)
SW-SE Parts of Mt. Carmel Quadrangle
Enterprise, Excelsior, Corbin Collieries
Alaska-Reliance Collieries
Susquehanna Collieries Corp
Locust Gap, Locust Spring, Potts Collieries

V = Vein No. Readings Avg. Max. Min.
C = Coal 0 ft. (Max) (Min) (ft)