


LOOKING WESTWARD

N

PENNSYLVANIA RAILROAD BRANCH

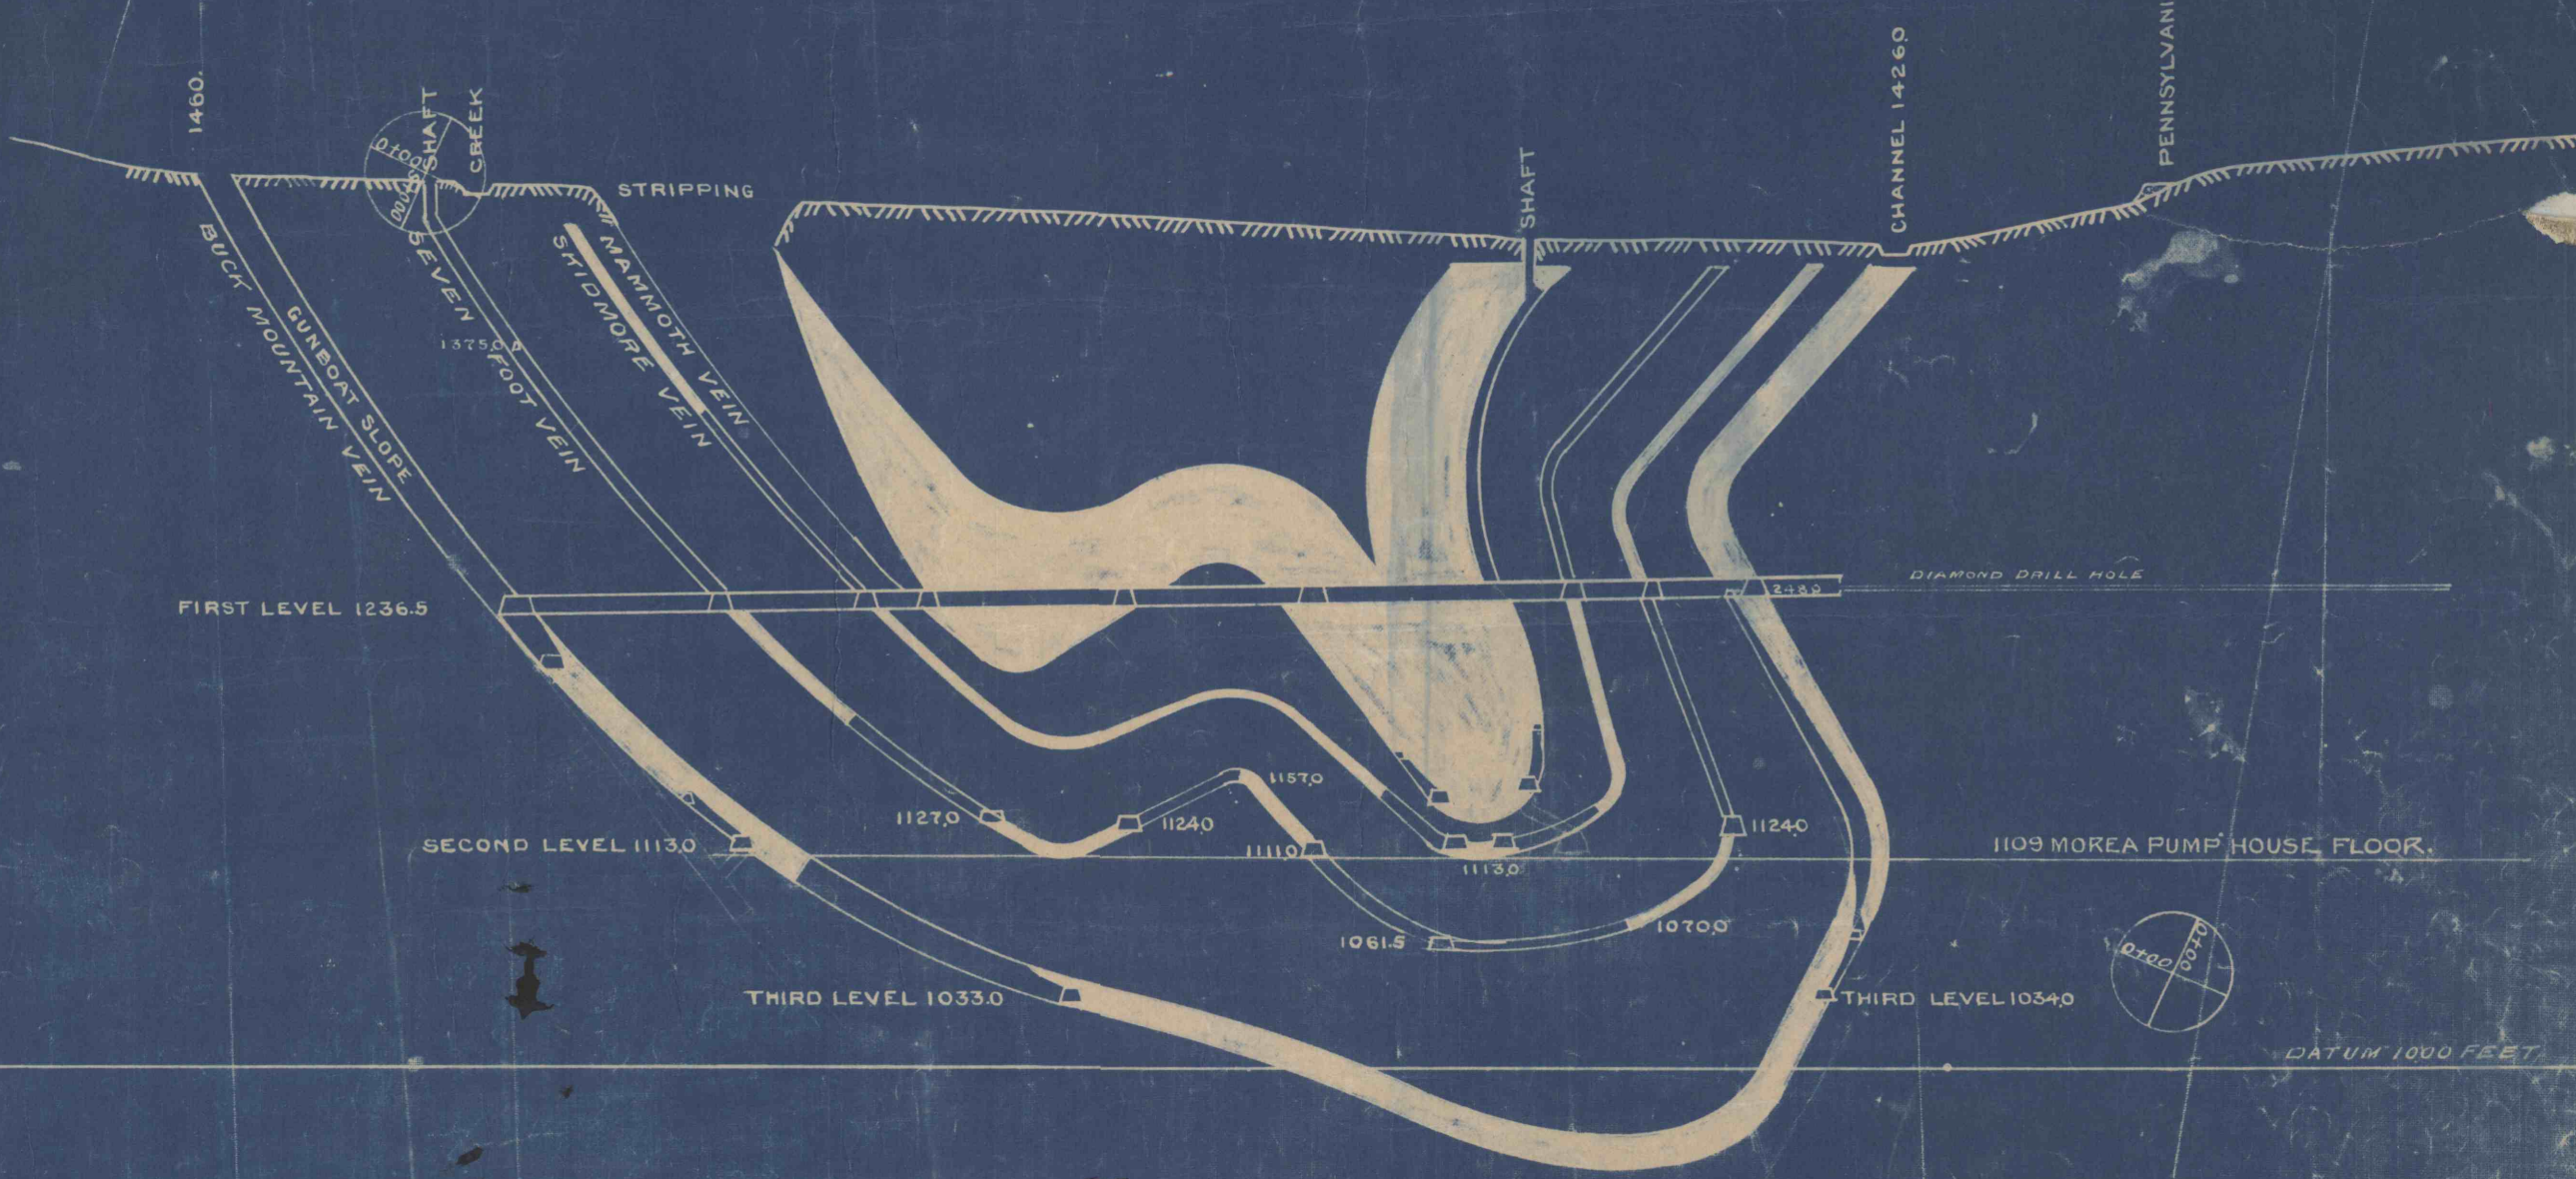

SOUTHERN FIELD.

MAHANOEY TWP., SCHUYLKILL

COUNTY PA., 14 E. SCHUYLKILL DIST.,

DODSON COAL CO., MADEIRA HILL COAL CO.,

— No 18 —

— MOREA COLLIERY —

SECTION THROUGH LINE OF BREAKER

SCALE 100 FEET

9/34

0704 803

0227 202

0705 515