


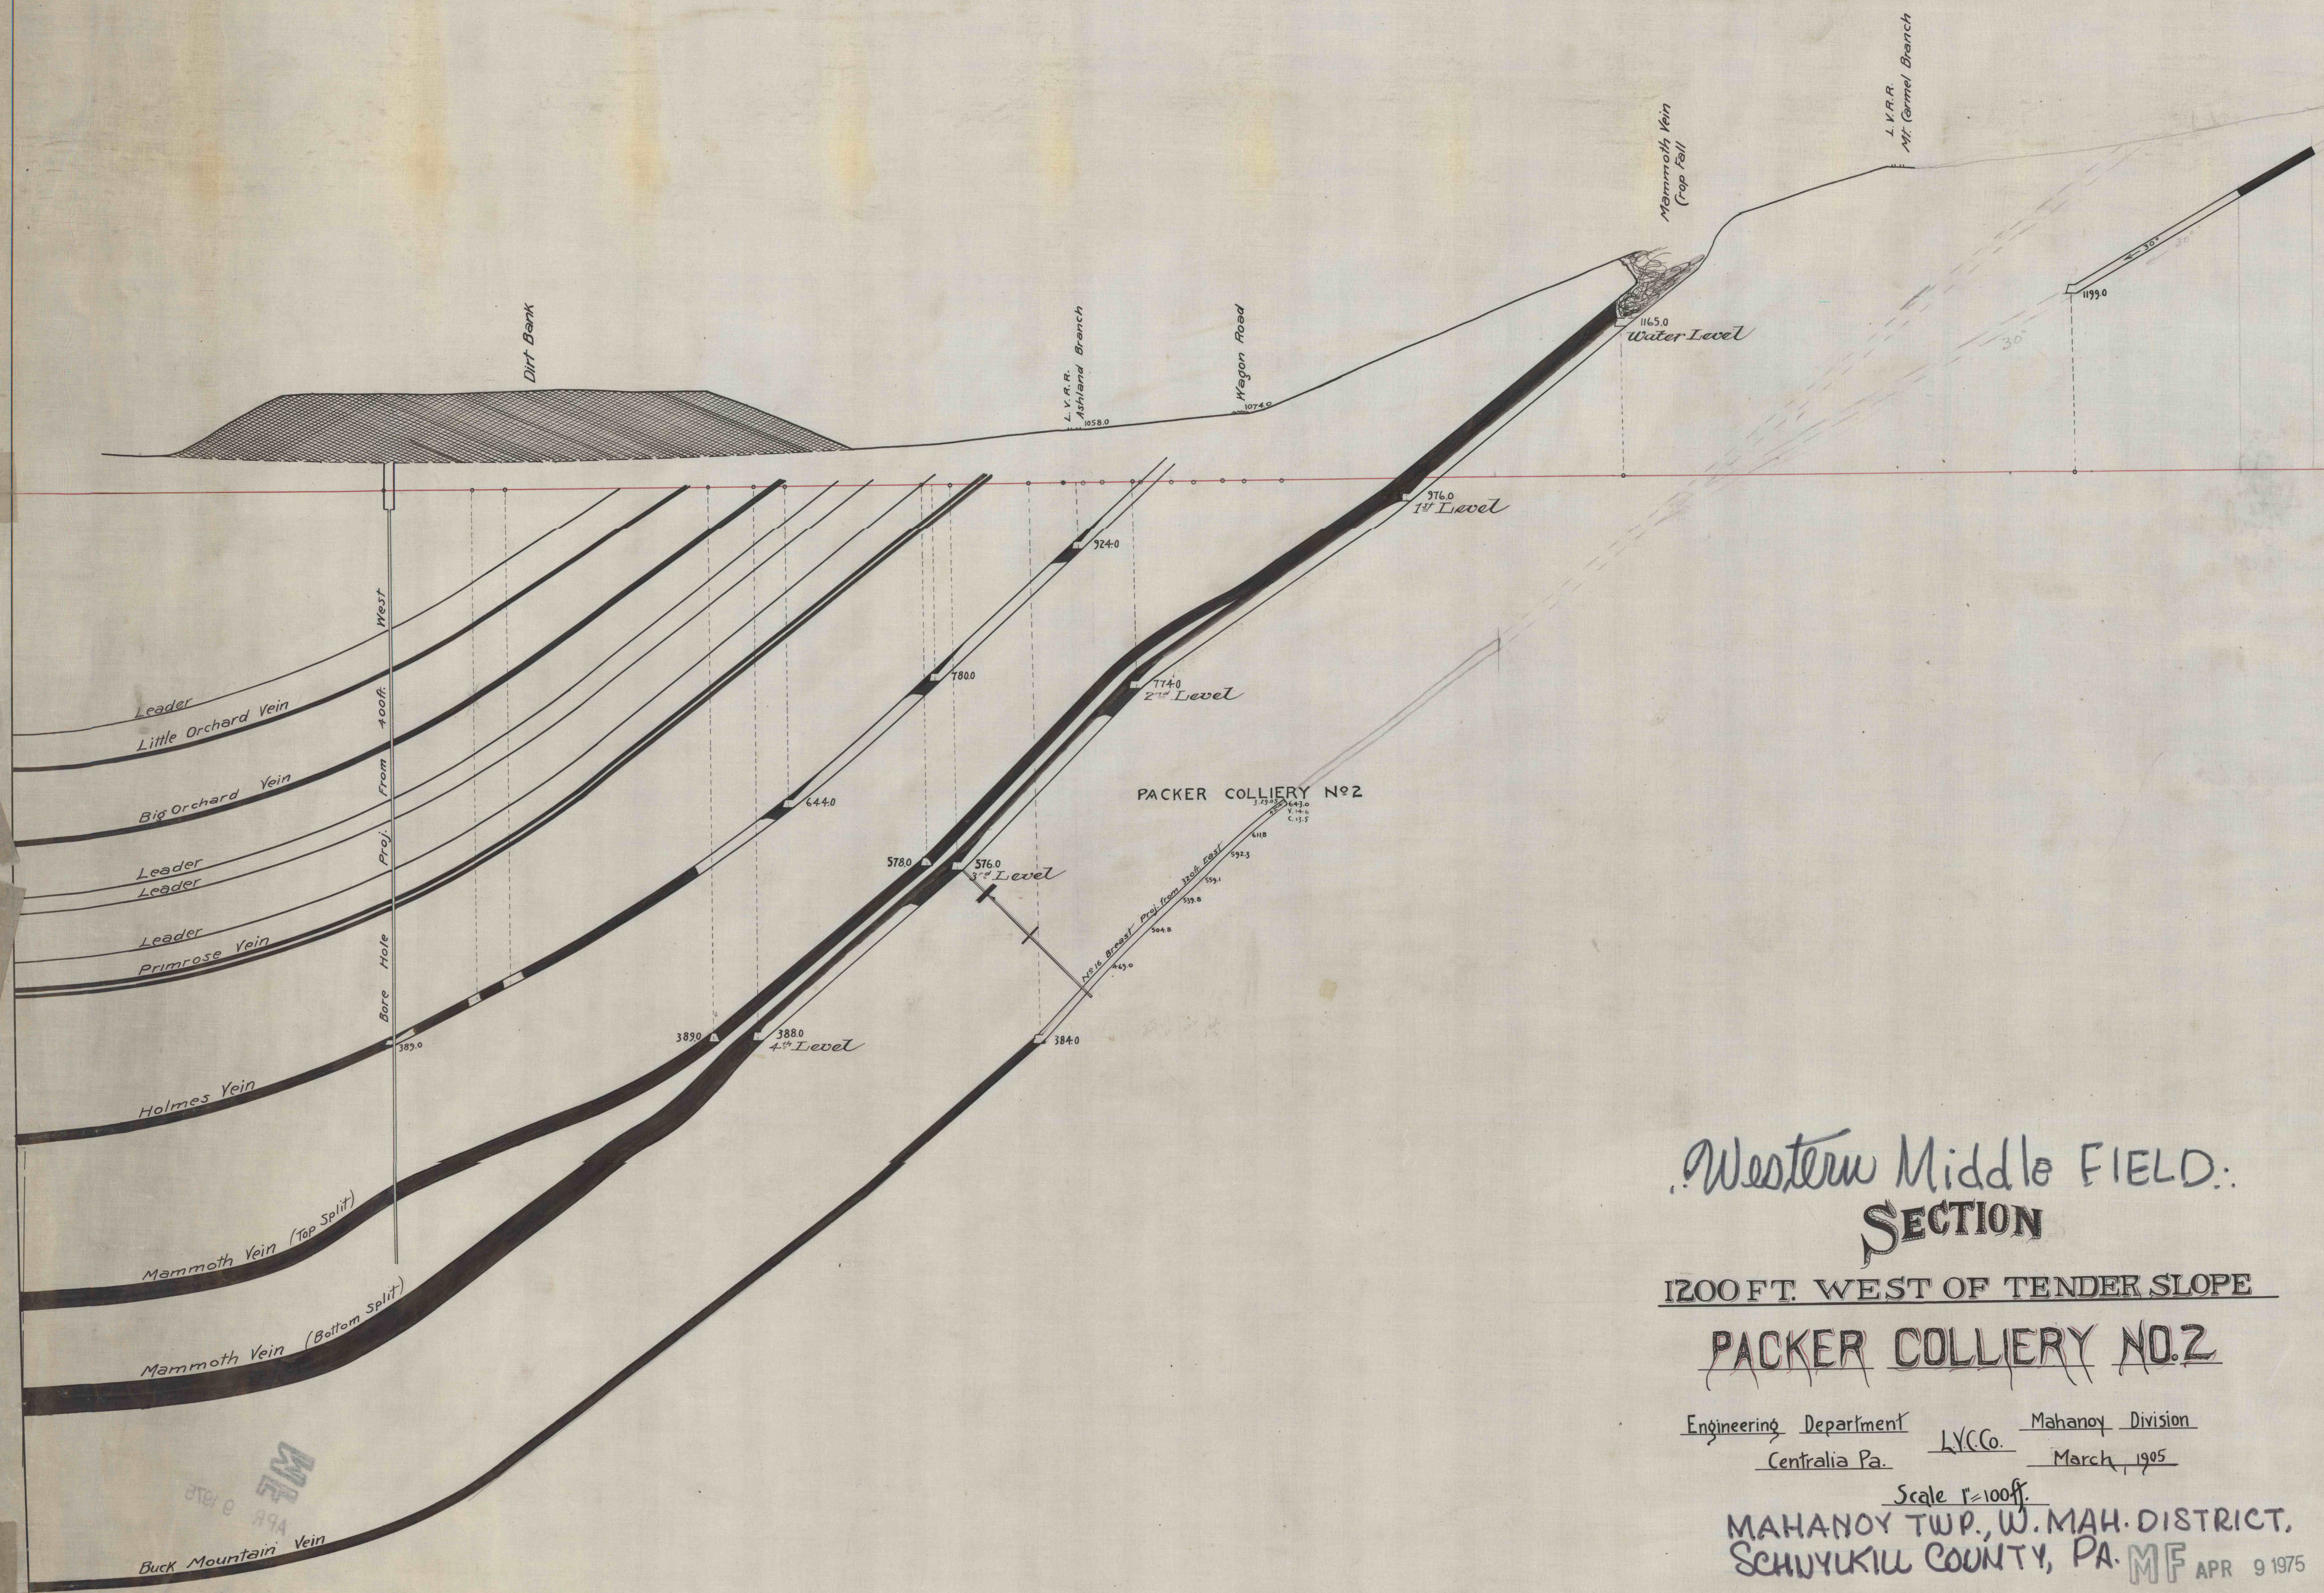

Western Middle FIELD:
SECTION

1200 FT. WEST OF TENDER SLOPE

PACKER COLLIERY NO. 2

Engineering Department LYCCo. Mahanoy Division
Centralia Pa. March, 1905

Scale 1"=100 ft.

MAHANAY TWP., W. MAH. DISTRICT,
SCHUYLKILL COUNTY, PA.

MF APR 9 1975