


MINING ENGINEERING DEPT.
LINTON & WILKINS-BARRIS GOAL CO.
WILKINS-BARRIS, PA.
VAULT NO. M.I.-K-22

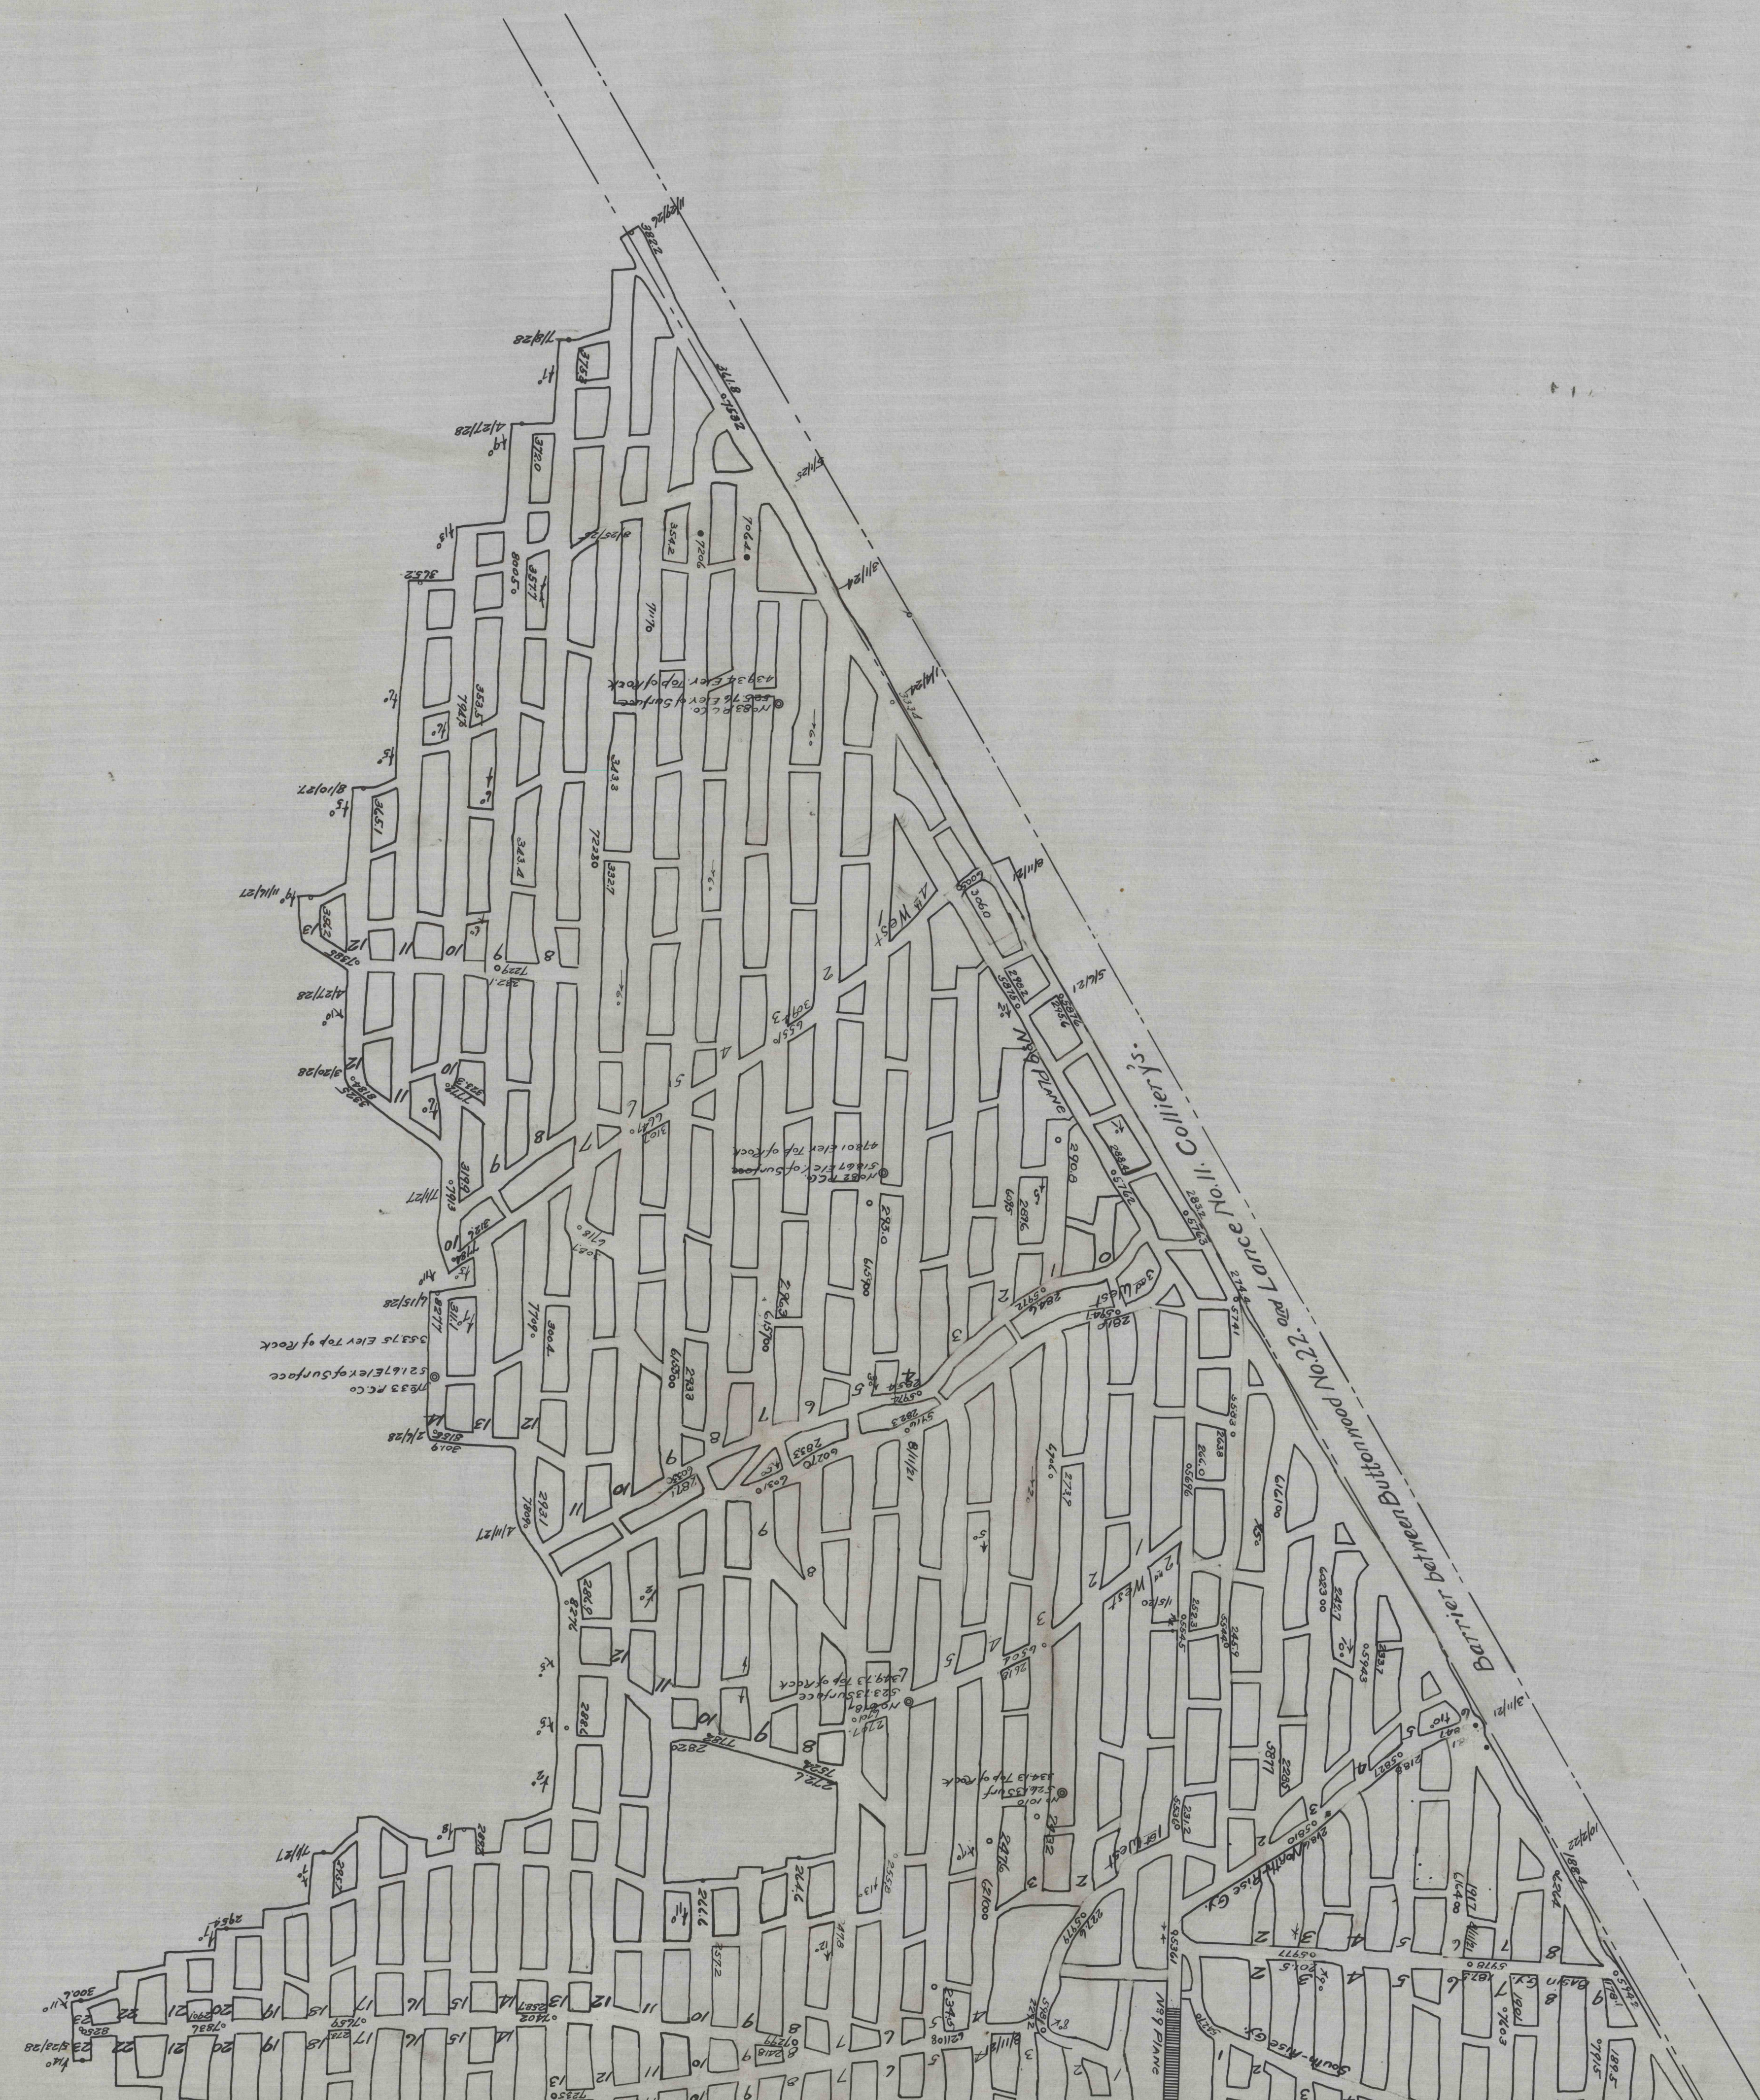

Northern Field...
BUTTONWOOD COLLIERY
HANOVER TOWNSHIP
KIDNEY VEIN
LUZERNE COUNTY, PA.
MINE INSPECTOR TRACING
5 PLYMOUTH DISTRICT.

August 1921	checked Nov. 30, 1959
April 1922	
APRIL 24 1924	
Dec. 1925	
August 1929	
January 1930	
March 1932	
April 1937	
April 1940	
April 1947	
July 1948	
July 1949	
Dec. 1950	
Mar. 1951	
Feb. 1952	
Mar. 1954	
Nov. 1956	
not working 1957	

MF
SEP 21 1973

MINING ENGINEERING DEPT.
LINTON & WILKINS-BARRIS GOAL CO.
WILKINS-BARRIS, PA.
VAULT NO. M.I.-K-22

MF
MF
SEP 21 1973
3 OF 3