


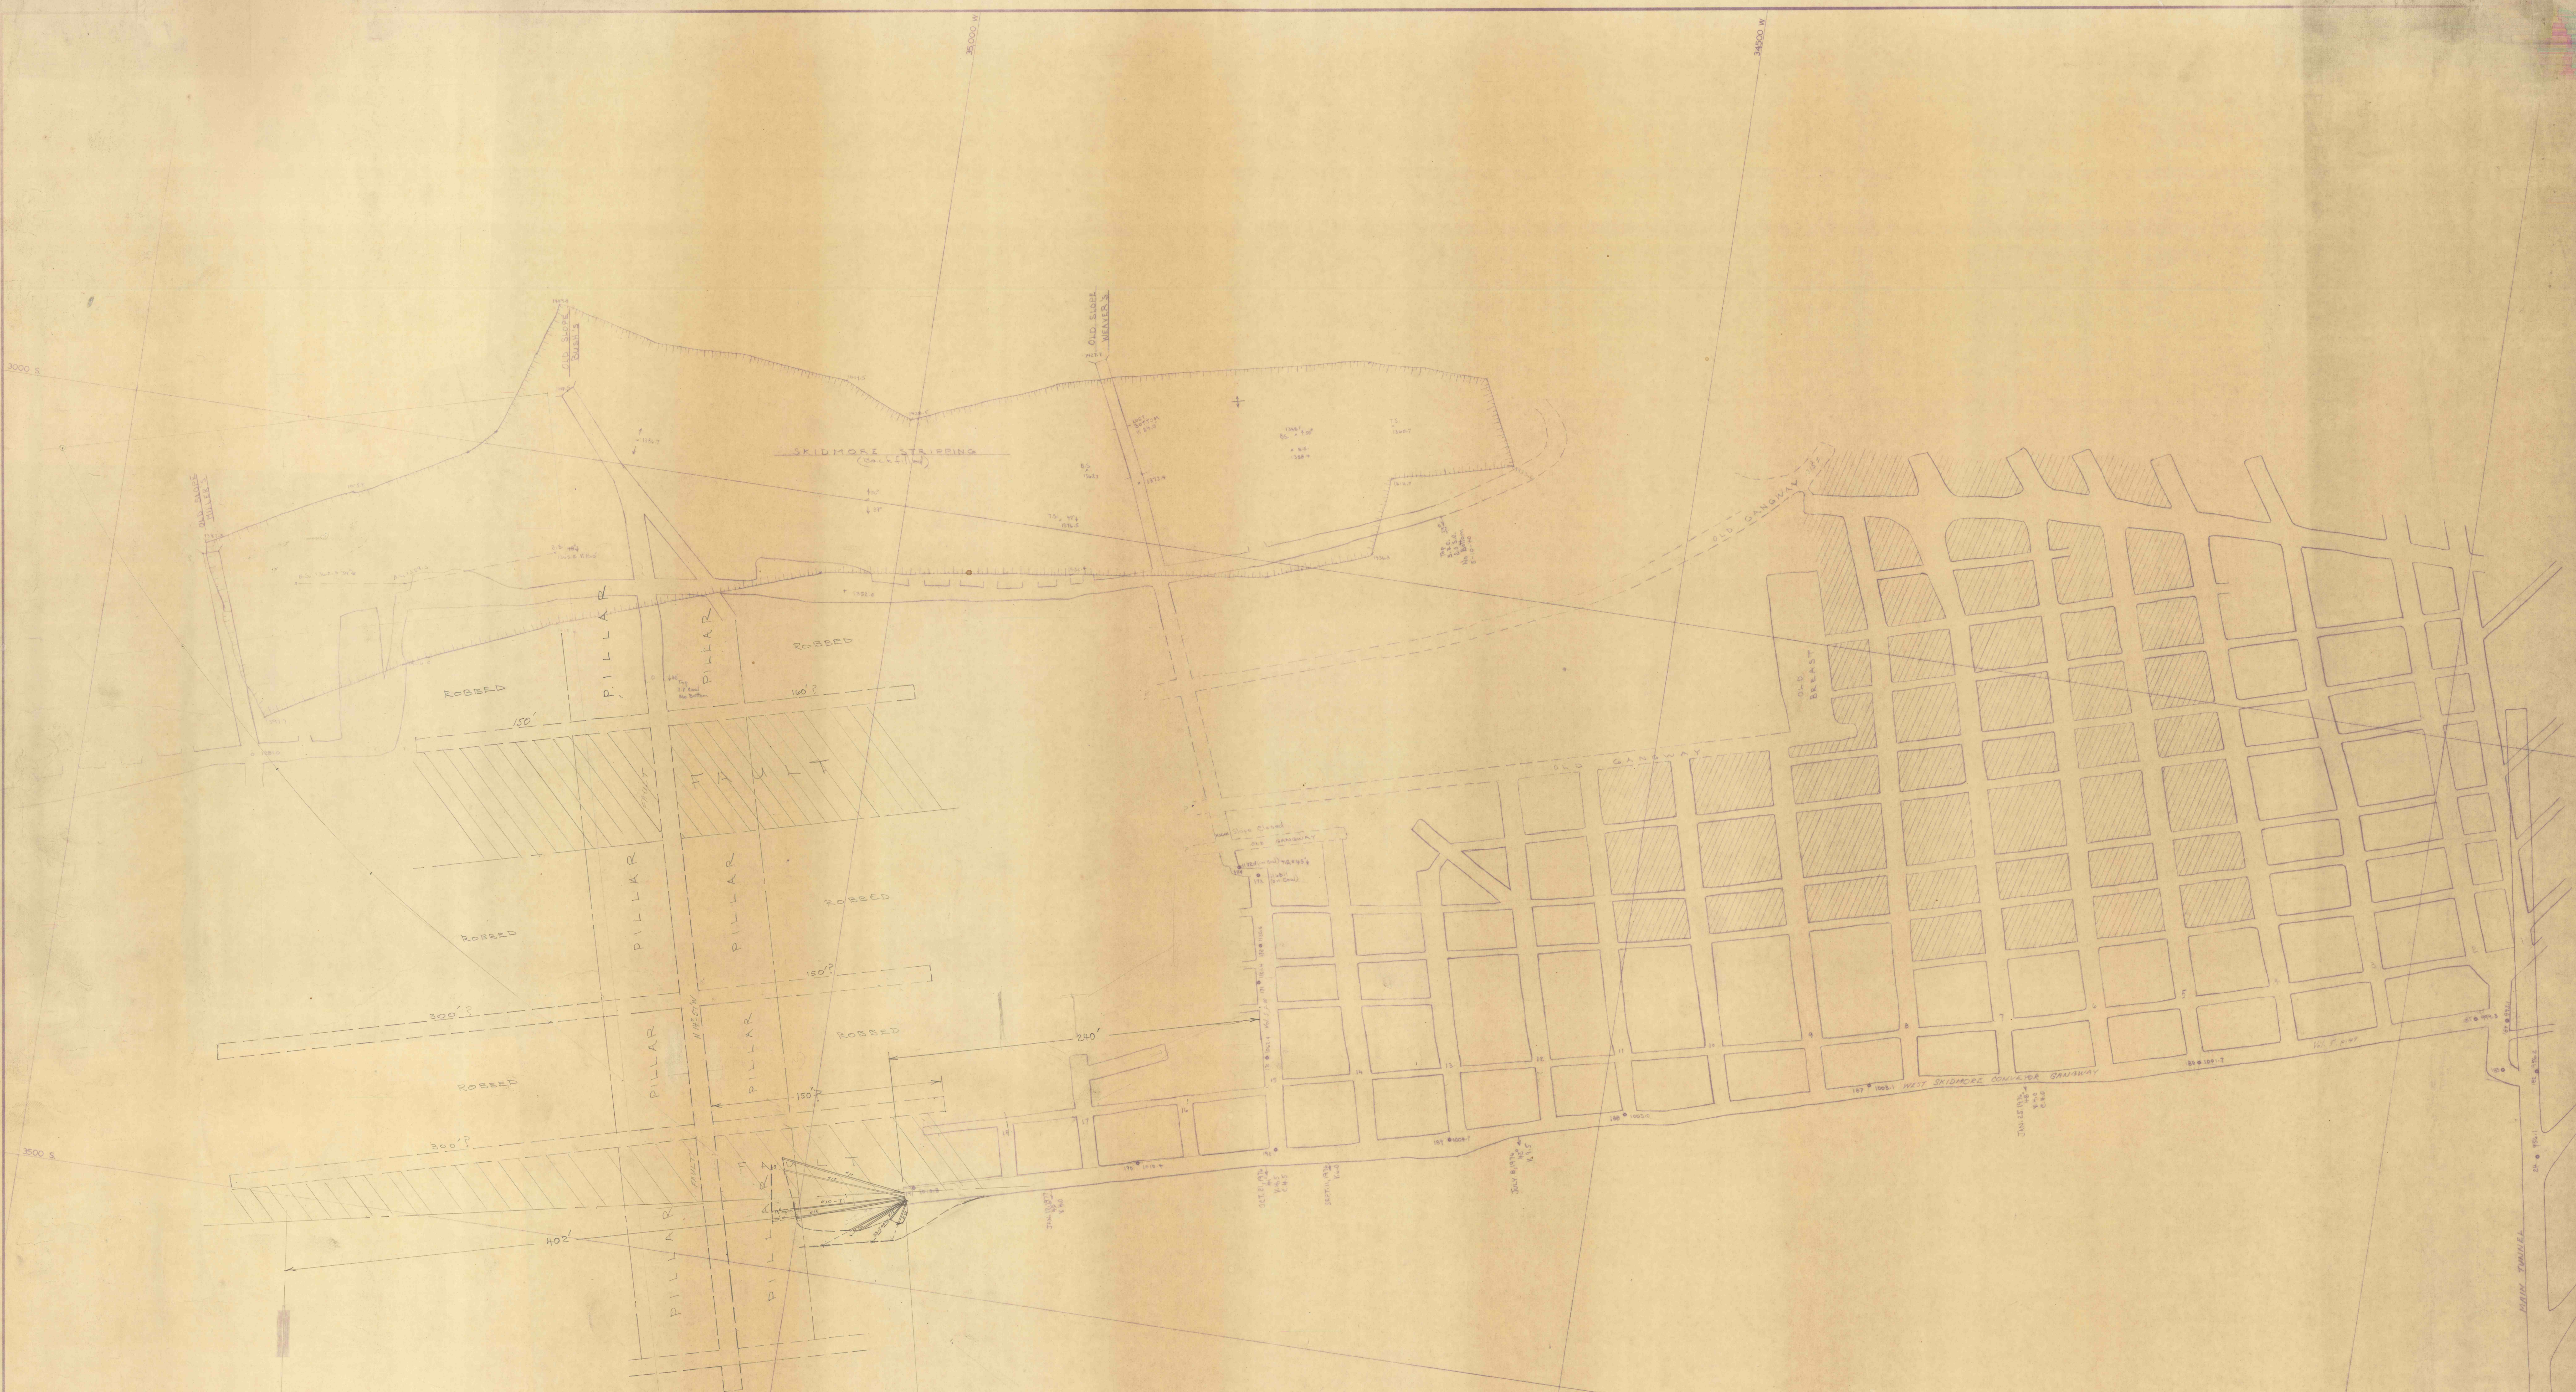

— PORTER TUNNEL —
MAP OF SOUTH DIP SKIDMORE SECTION SHOWING
INFORMATION PROVIDED BY RAY BUSH TO MESA
SCALE: 1"=40' SEPT. 2, 1917 F. A. SCHUCKER, P.E.

62
1714
1400
1300
1200
1100
1000