


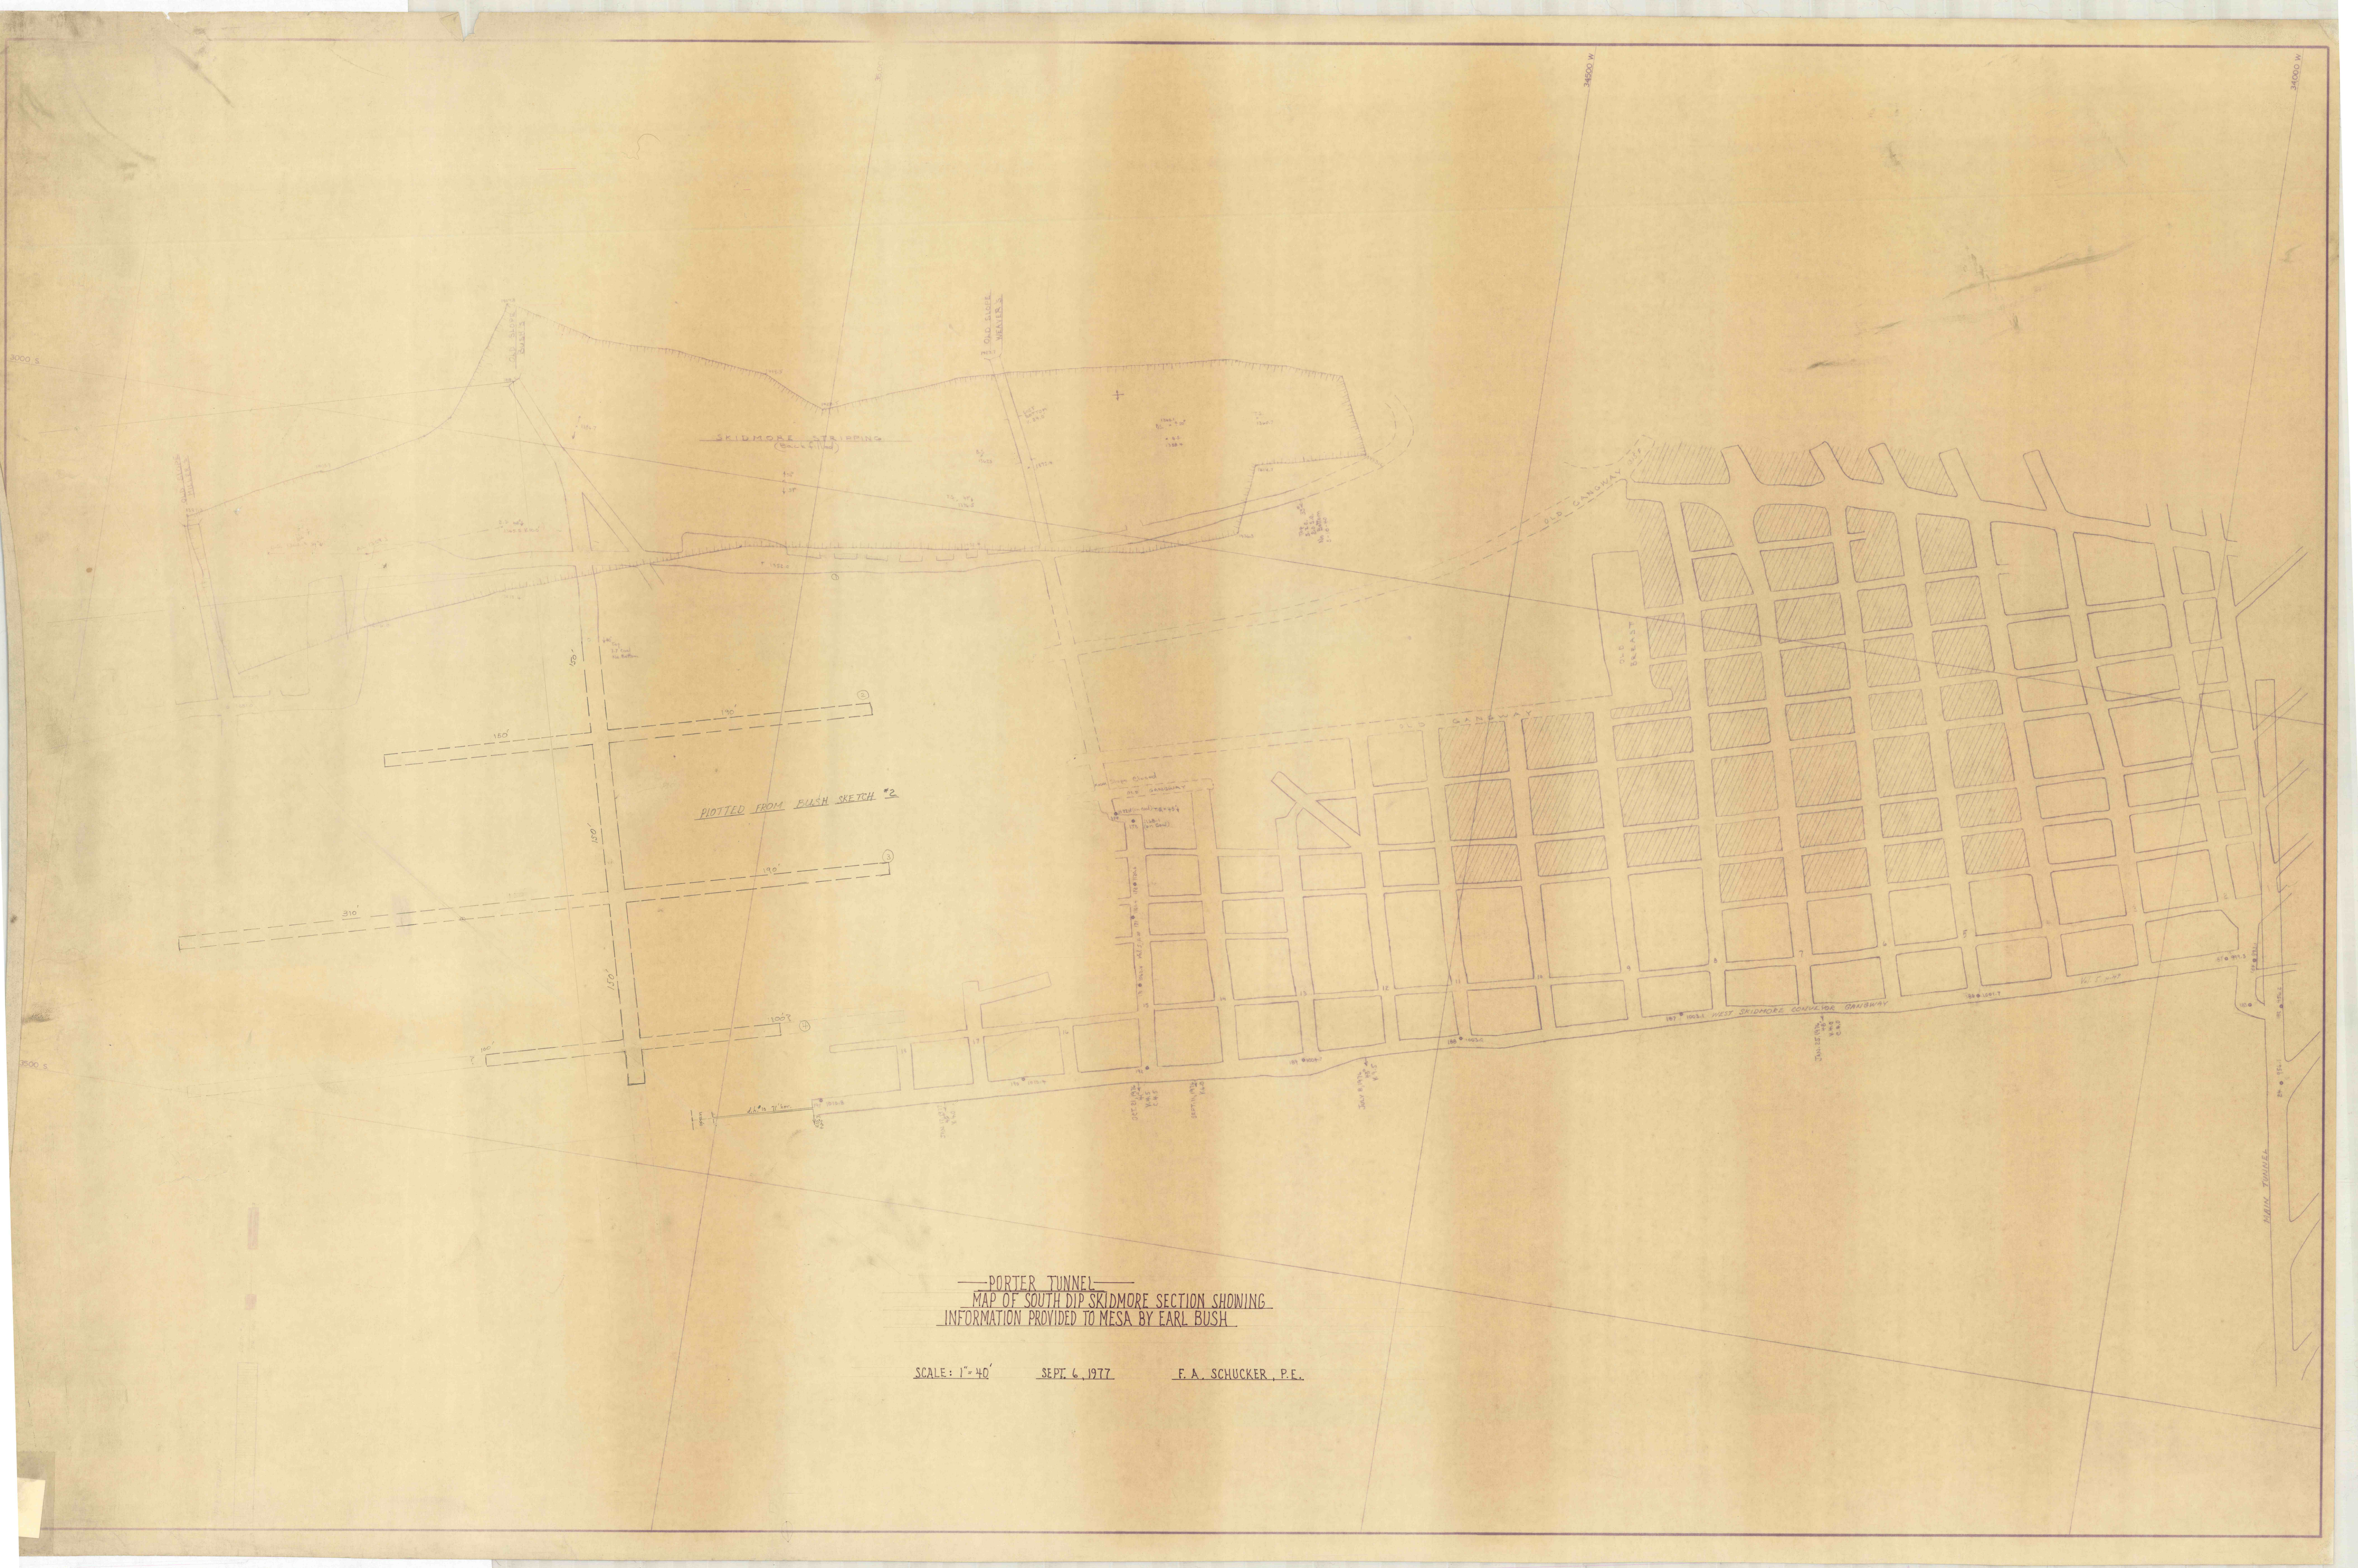

PORTER TUNNEL
MAP OF SOUTH DIP SKIDMORE SECTION SHOWING
INFORMATION PROVIDED TO MESA BY EARL BUSH

SCALE: 1"=40'

SEPT. 6, 1977

F. A. SCHUCKER, P.E.